


010478-010483-0095

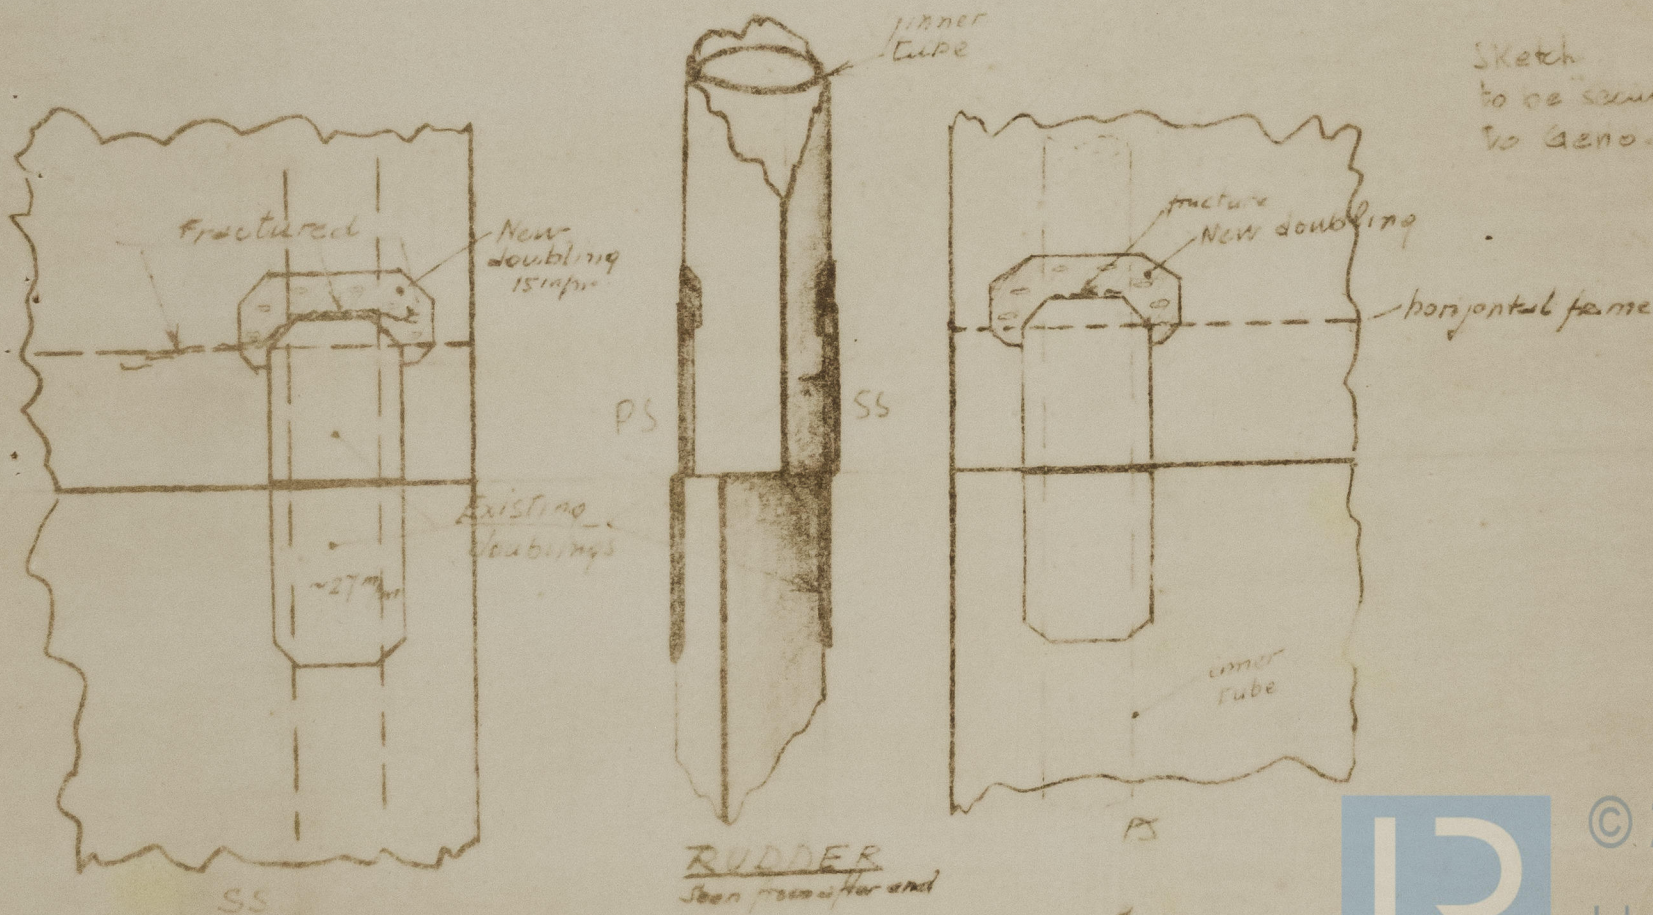

Sketch
to be securely attached
to Genoa Report No.

RUDDER
Seen from after end
"CITTA DI SALERNO"
Rudder shell plating Repair (Gen. 758)



© 2021

Lloyd's Register
Foundation