


NOS 11969 & 11979 1284 1373-1380. PLAN OF STEEL DECKS.

DIMENSIONS:- 460'-0" B.P. x 59'-0" M.D. x 34'-10" M.D.
 SCALE:- 1/8" = 1 FOOT.


TO CLASS LLOYDS 100 A.I.
 "CARRYING PETROLEUM IN BULK"
 NO. 11979 10 CLASS B.S. (BULK OIL CARRIER)

Also 1381 & 1382 - 460' x 59' x 34'
 1408 see letter 5/8/48
 1412-13 - 25/9/48
 Fossvik 1383 460' x 59' x 34'
 Grantham 1412 not classed


OIL-TIGHT HATCHES 4'-0" DIAMETER COAMING WELDED TO DECK.
 DECK BUTTS VESSED & WELDED. SEE MIDSHIP SECTION.
 DECK LANDINGS DOWN WAY OF OIL, S.S. CLARE OR OIL
 OR WELDED.

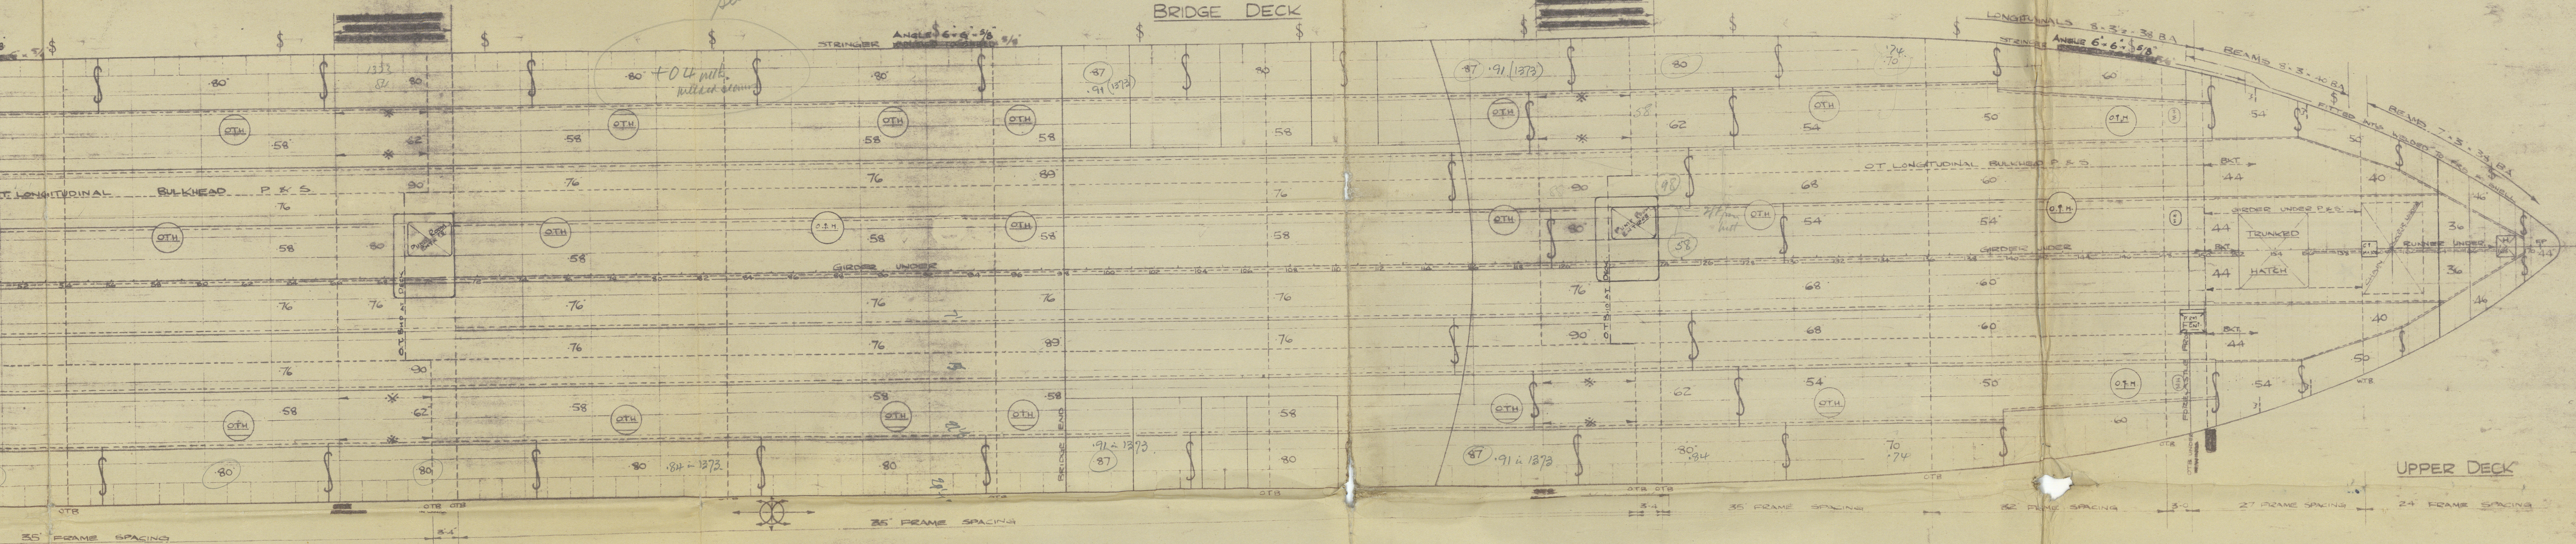


* 4'-2 1/2" x 36" STEEL BARS FITTED ON THESE LONGITUDINALS FOR EXTENT SHOWN.
 CONNECTED TO TRANSVERSE & 40' x 14" B.L.T. (10-1/8" RING) TO BULKHEAD.
 REMAINDER OF BRACKETS TO BE NORMAL.

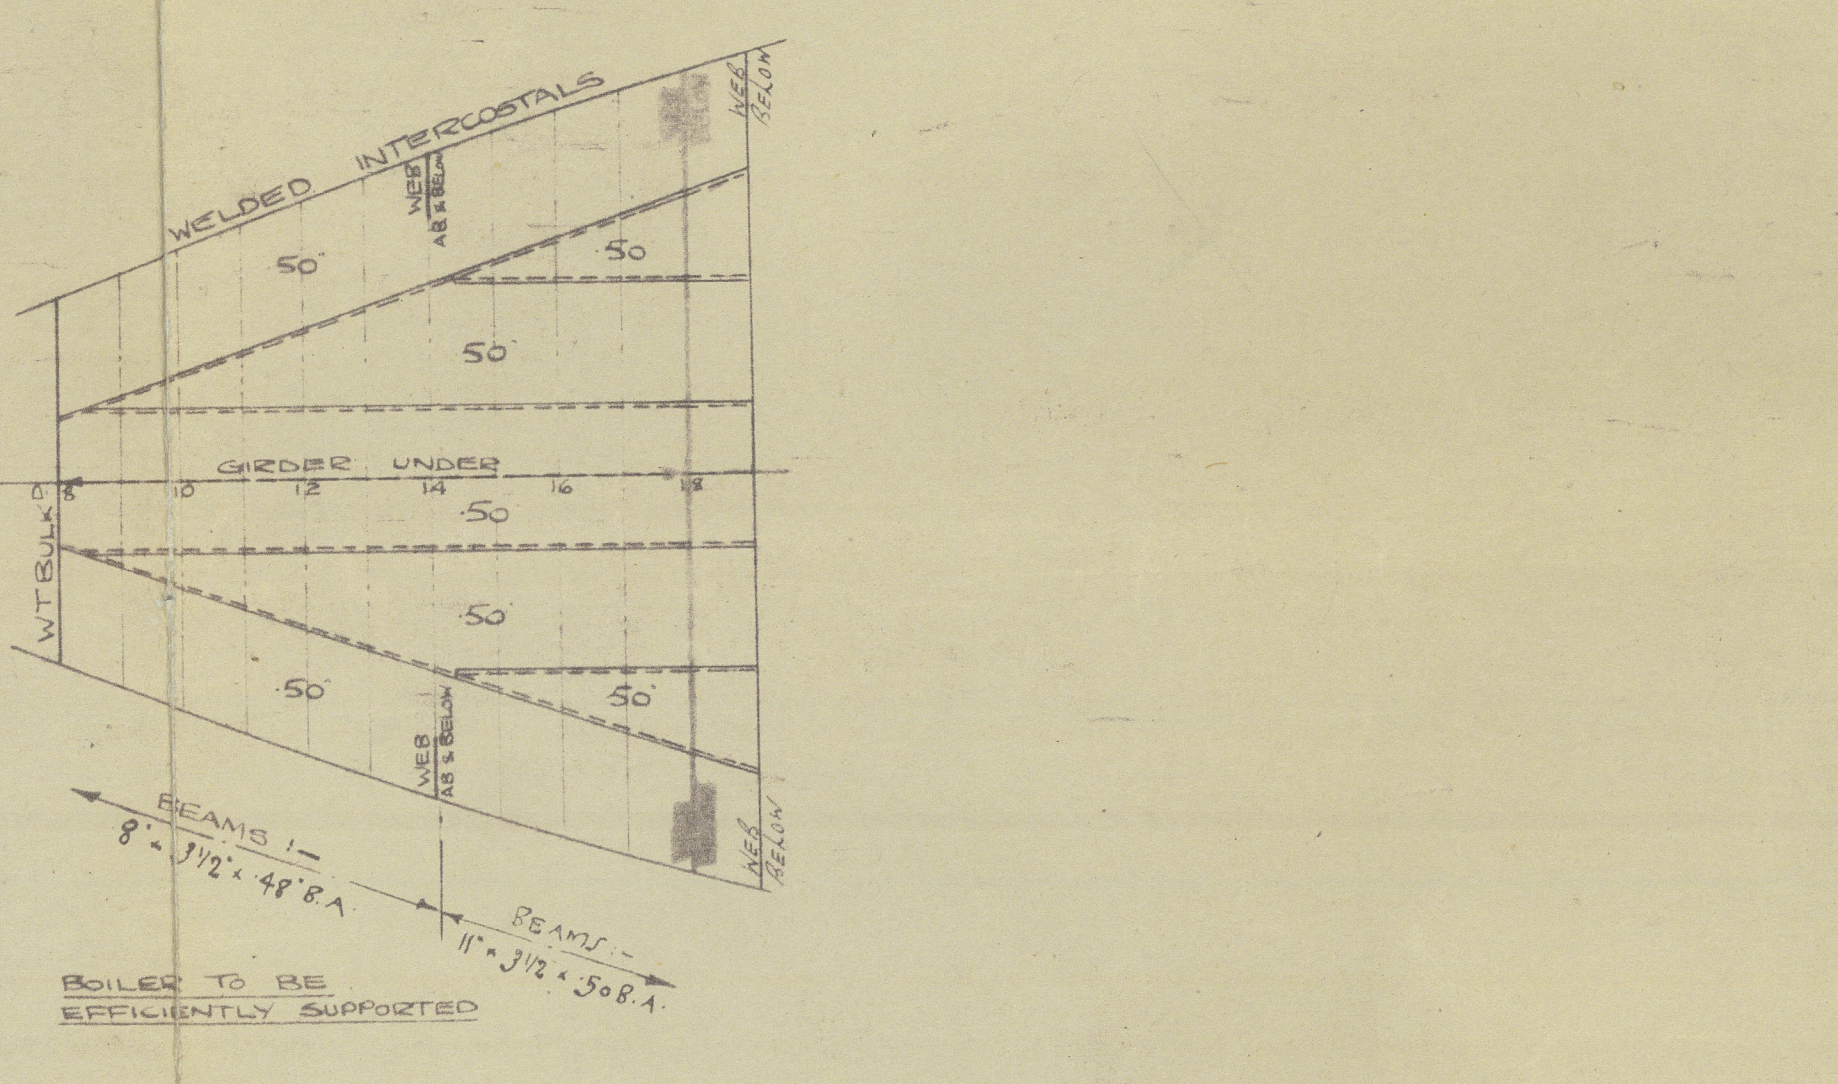

BOILER FLAT

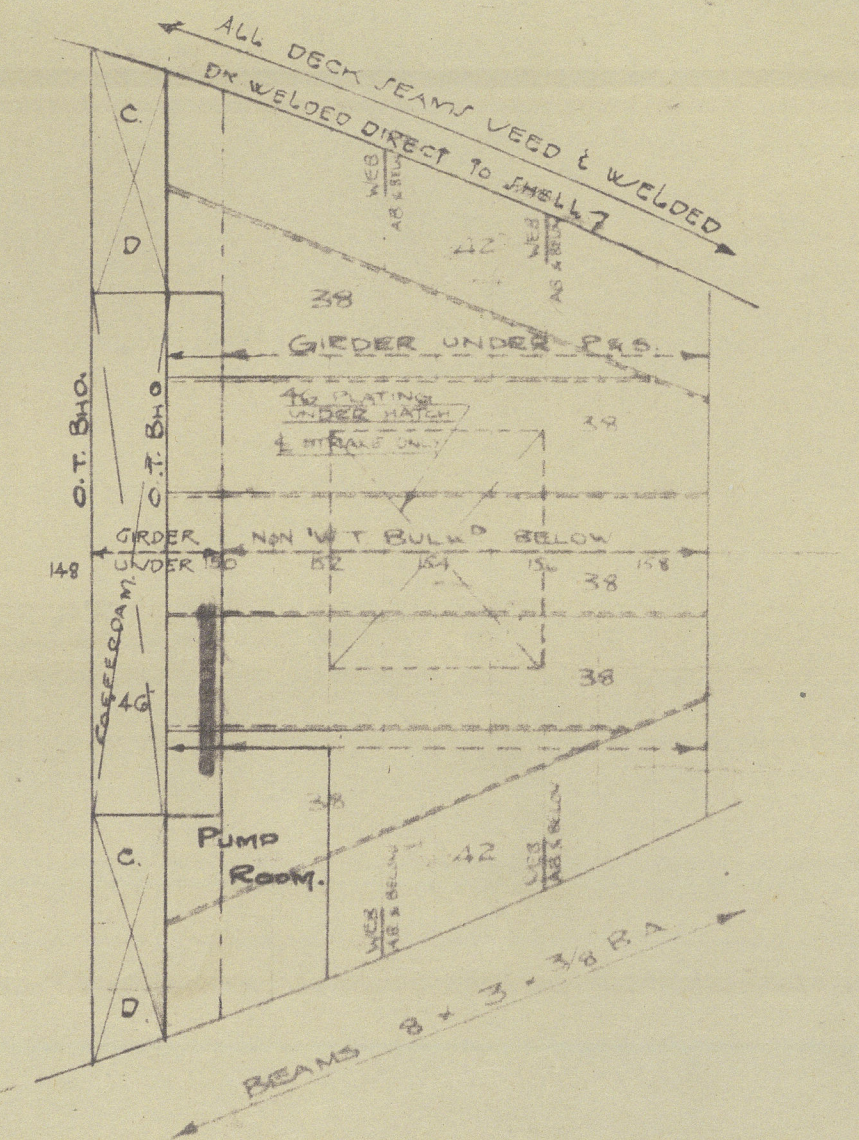


TOP OF DEEP TANK

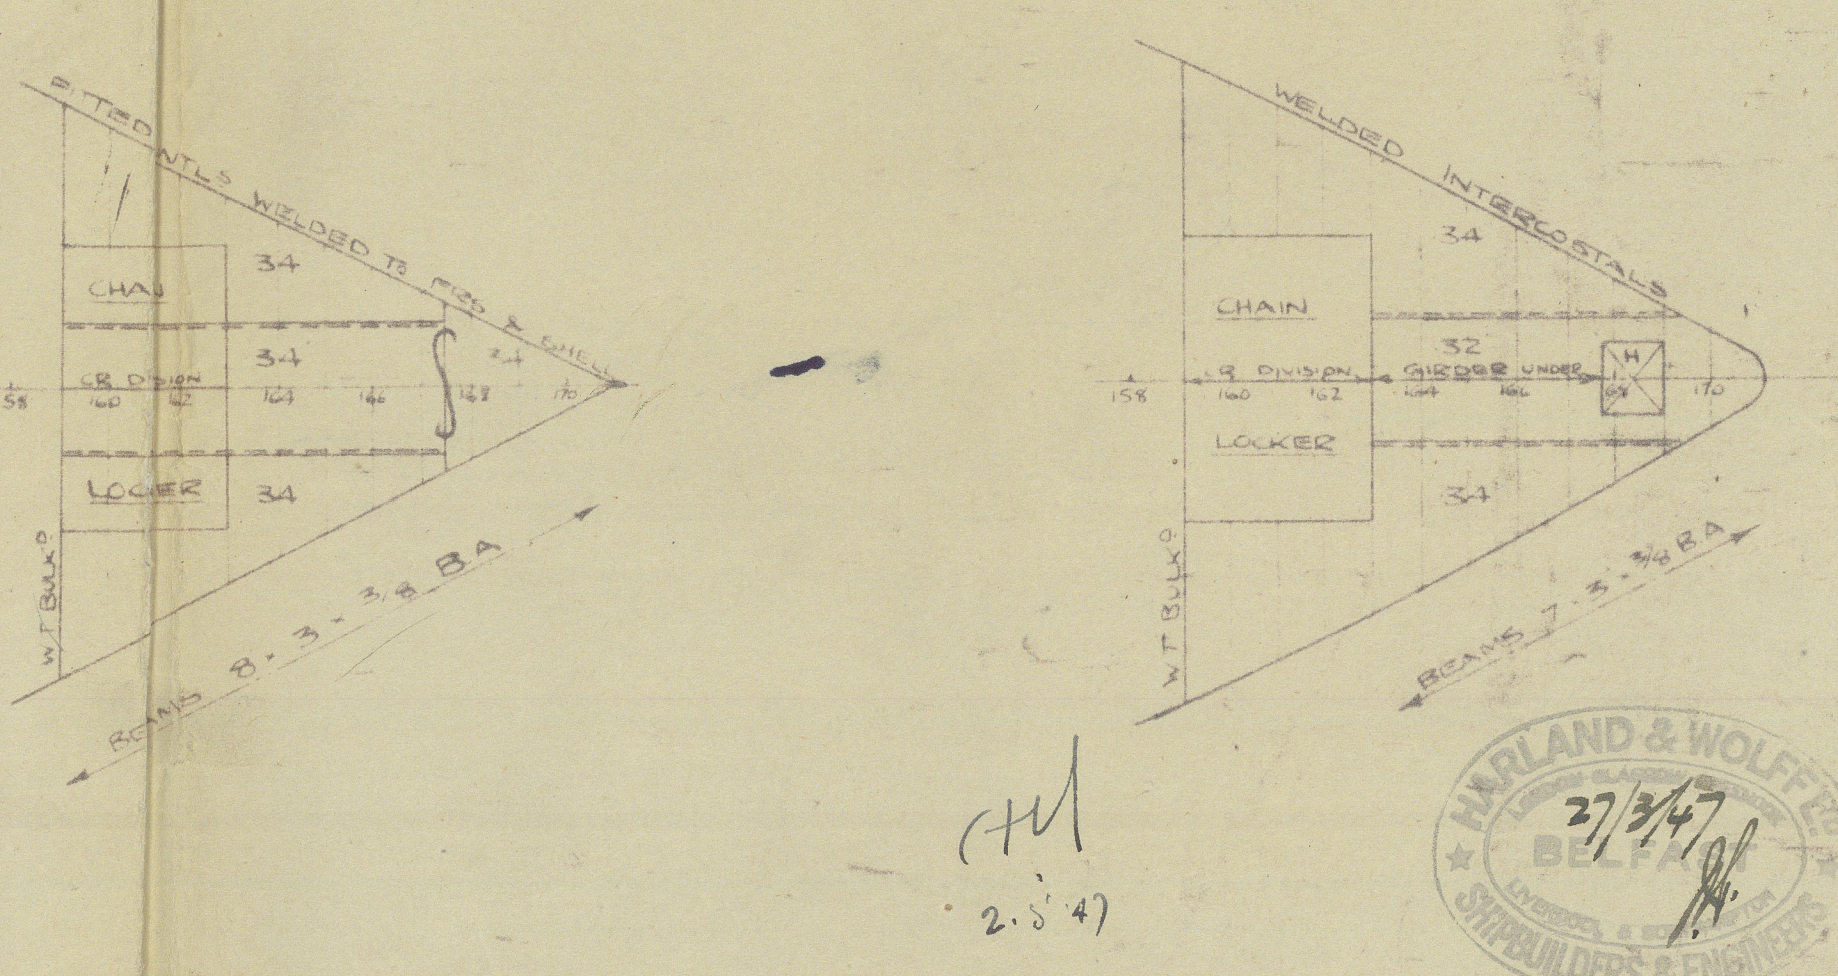

W.T. FLAT

MAIN DECK FORB

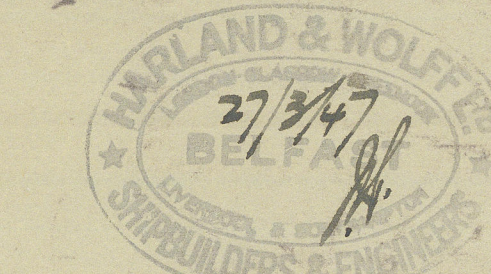

Archival

Albacara

RECORDS DEPT.
LONDON

8

HARLAND & WOLFF LTD.

H/N Albacara

S. 1373 + 1380 / 1 / 3 2 1408:12-13.
Steel Decks

2/5/47

2

No. 1373 Del. yr No 14623 - "Falta" ★

No. 1380

No. 1381

010484-010494-0054



© 2021

Lloyd's Register
Foundation