


# Lloyd's Register of Shipping.

## SURVEYS FOR FREEBOARD.

### (CONDITIONS OF ASSIGNMENT.)

Ship's Name **"EMPIRE LUNDY"** Port of Survey **HULL.**  
 Official Number **180121** Surveyor's Signature *J. M. Maceod*  
 Nationality and Port of Registry **British - 9006.** Date of Survey **During construction**

Disposition and dimensions of superstructures, trunks, deckhouses and machinery casings to be inserted in the diagrams and tabular statement:

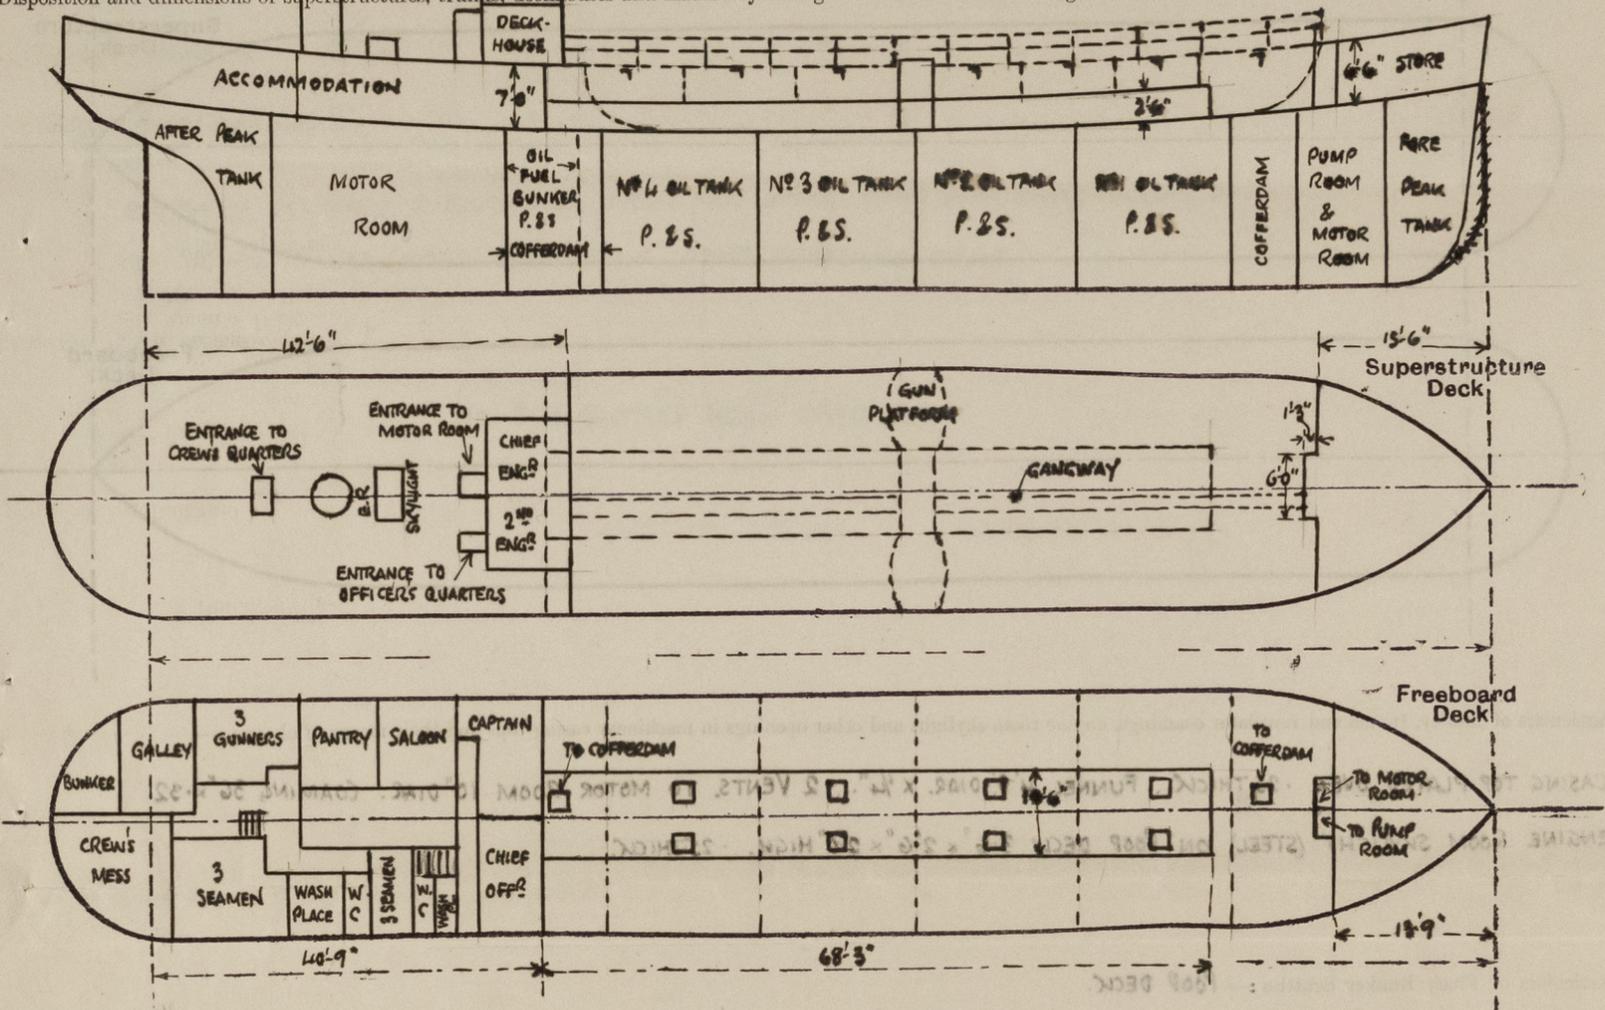

Particulars of Superstructures, Trunks, Casings, Deckhouses.

	Coaming	Plating	Stiffeners	Spacing	End Attachments of Stiffeners	Size of Openings	Height of Sills	Height of Casings
Poop Bulkhead	.30	.30	4" x 3" x 36"	30"	BUTS TOP & BOTTOM	NONE		7'-0"
Raised Quarter Deck Bulkhead	✓							
Bridge, After Bulkhead	✓							
Bridge, Forward Bulkhead	✓							
Forecastle Bulkhead	.20	.20	2 1/2" x 2 1/2" x 26"	30"	BUTS TOP & BOTTOM	4'-6" x 2'-0"	18"	6'-6"
Trunk, Aft	.30	.30	3 x 2 1/2" x 30"	21"	BUTS AT BOTTOM	2'-6" x 2'-6"		2'-6"
Trunk, Forward								
Exposed Machinery Casings on Freeboard or Raised Quarter Decks	✓							
Exposed Machinery Casings on Superstructure Decks	✓							
Machinery Casings within Superstructures not fitted with Class I Closing Appliances	✓							
Deckhouses on Flush Deck Ships	✓							

Particulars of Closing Appliances (state if capable of being manipulated from both sides).

Poop Bulkhead	NONE openings
Raised Quarter Deck Bulkhead	✓
Bridge, After Bulkhead	✓
Bridge, Forward Bulkhead	✓
Forecastle Bulkhead	2 HINGED STEEL DOORS 4'-6" x 2'-0" - 18" SILLS. SPRING LOCKS OPERATED FROM BOTH SIDES.
Exposed Machinery Casings on Freeboard or Raised Quarter Decks	✓
Exposed Machinery Casings on Superstructure Decks	✓
Machinery Casings within Superstructures not fitted with Class I Closing Appliances	✓
Deckhouses on Flush Deck Ships	✓



