




PLAN VIEW AT BOTTOM OF TANK

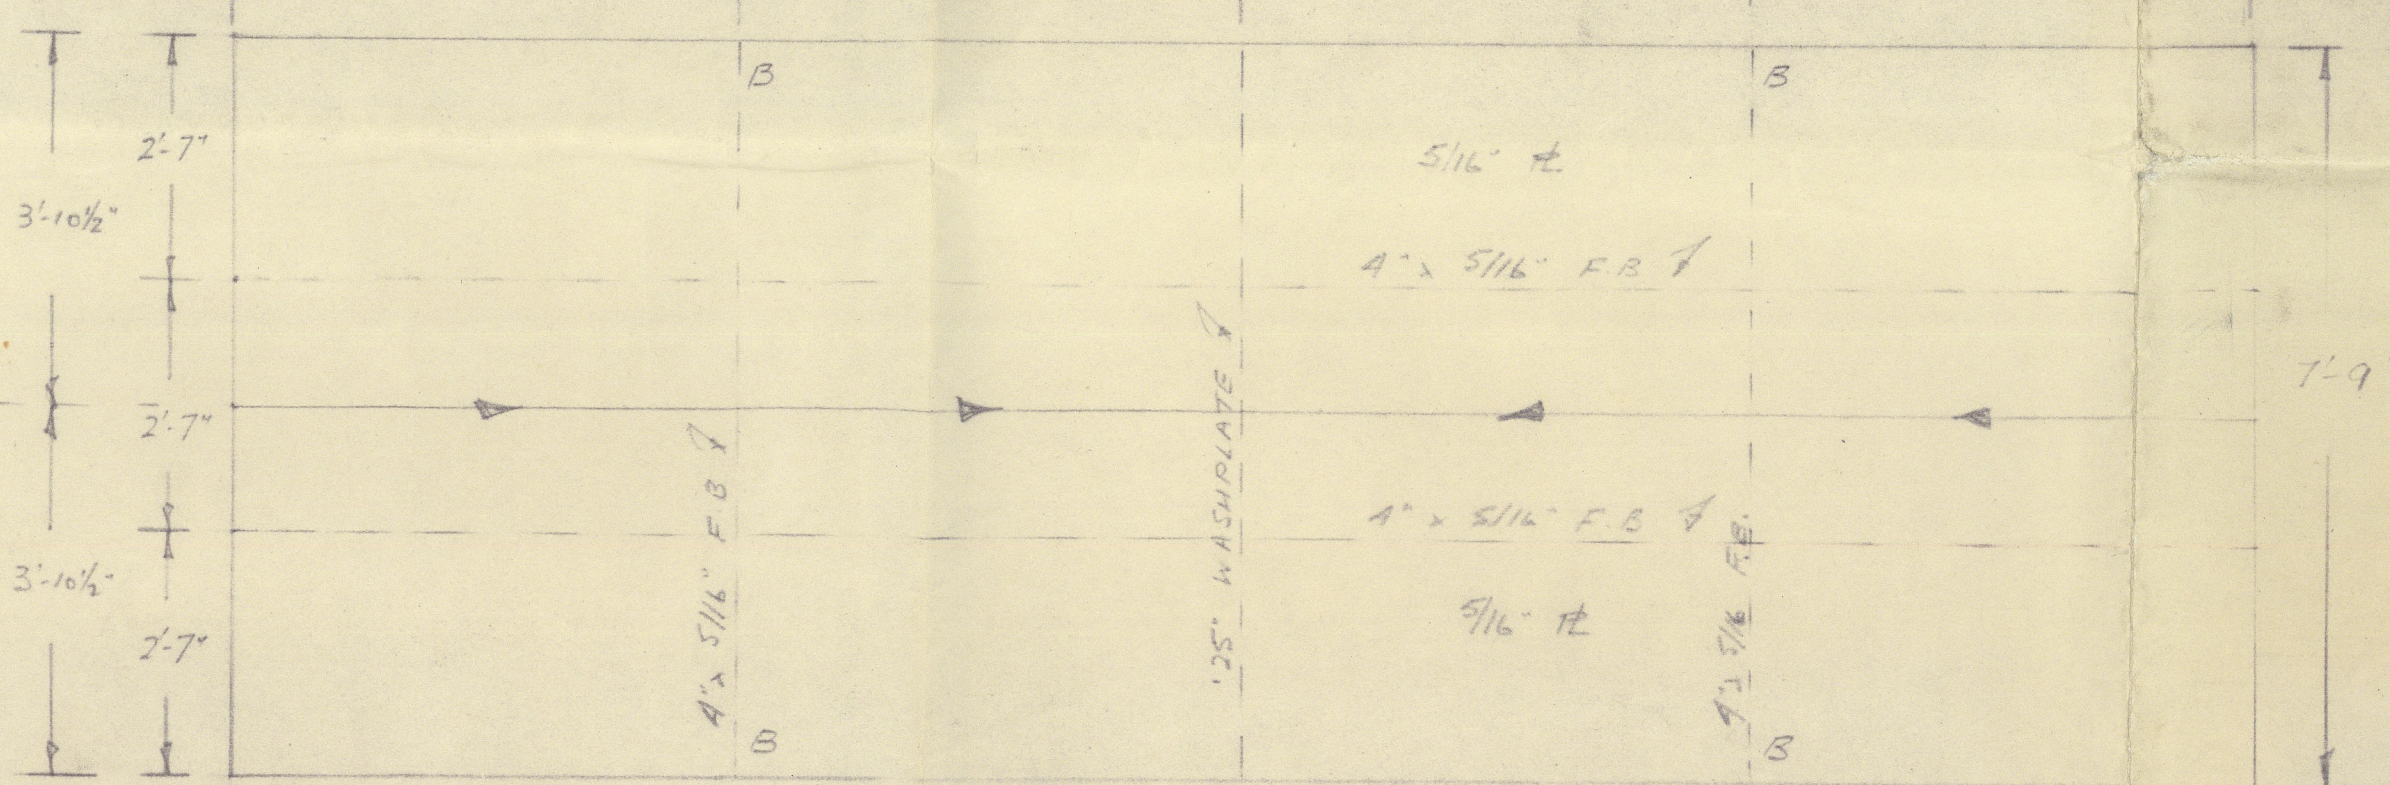


PLAN VIEW AT TOP OF TANK

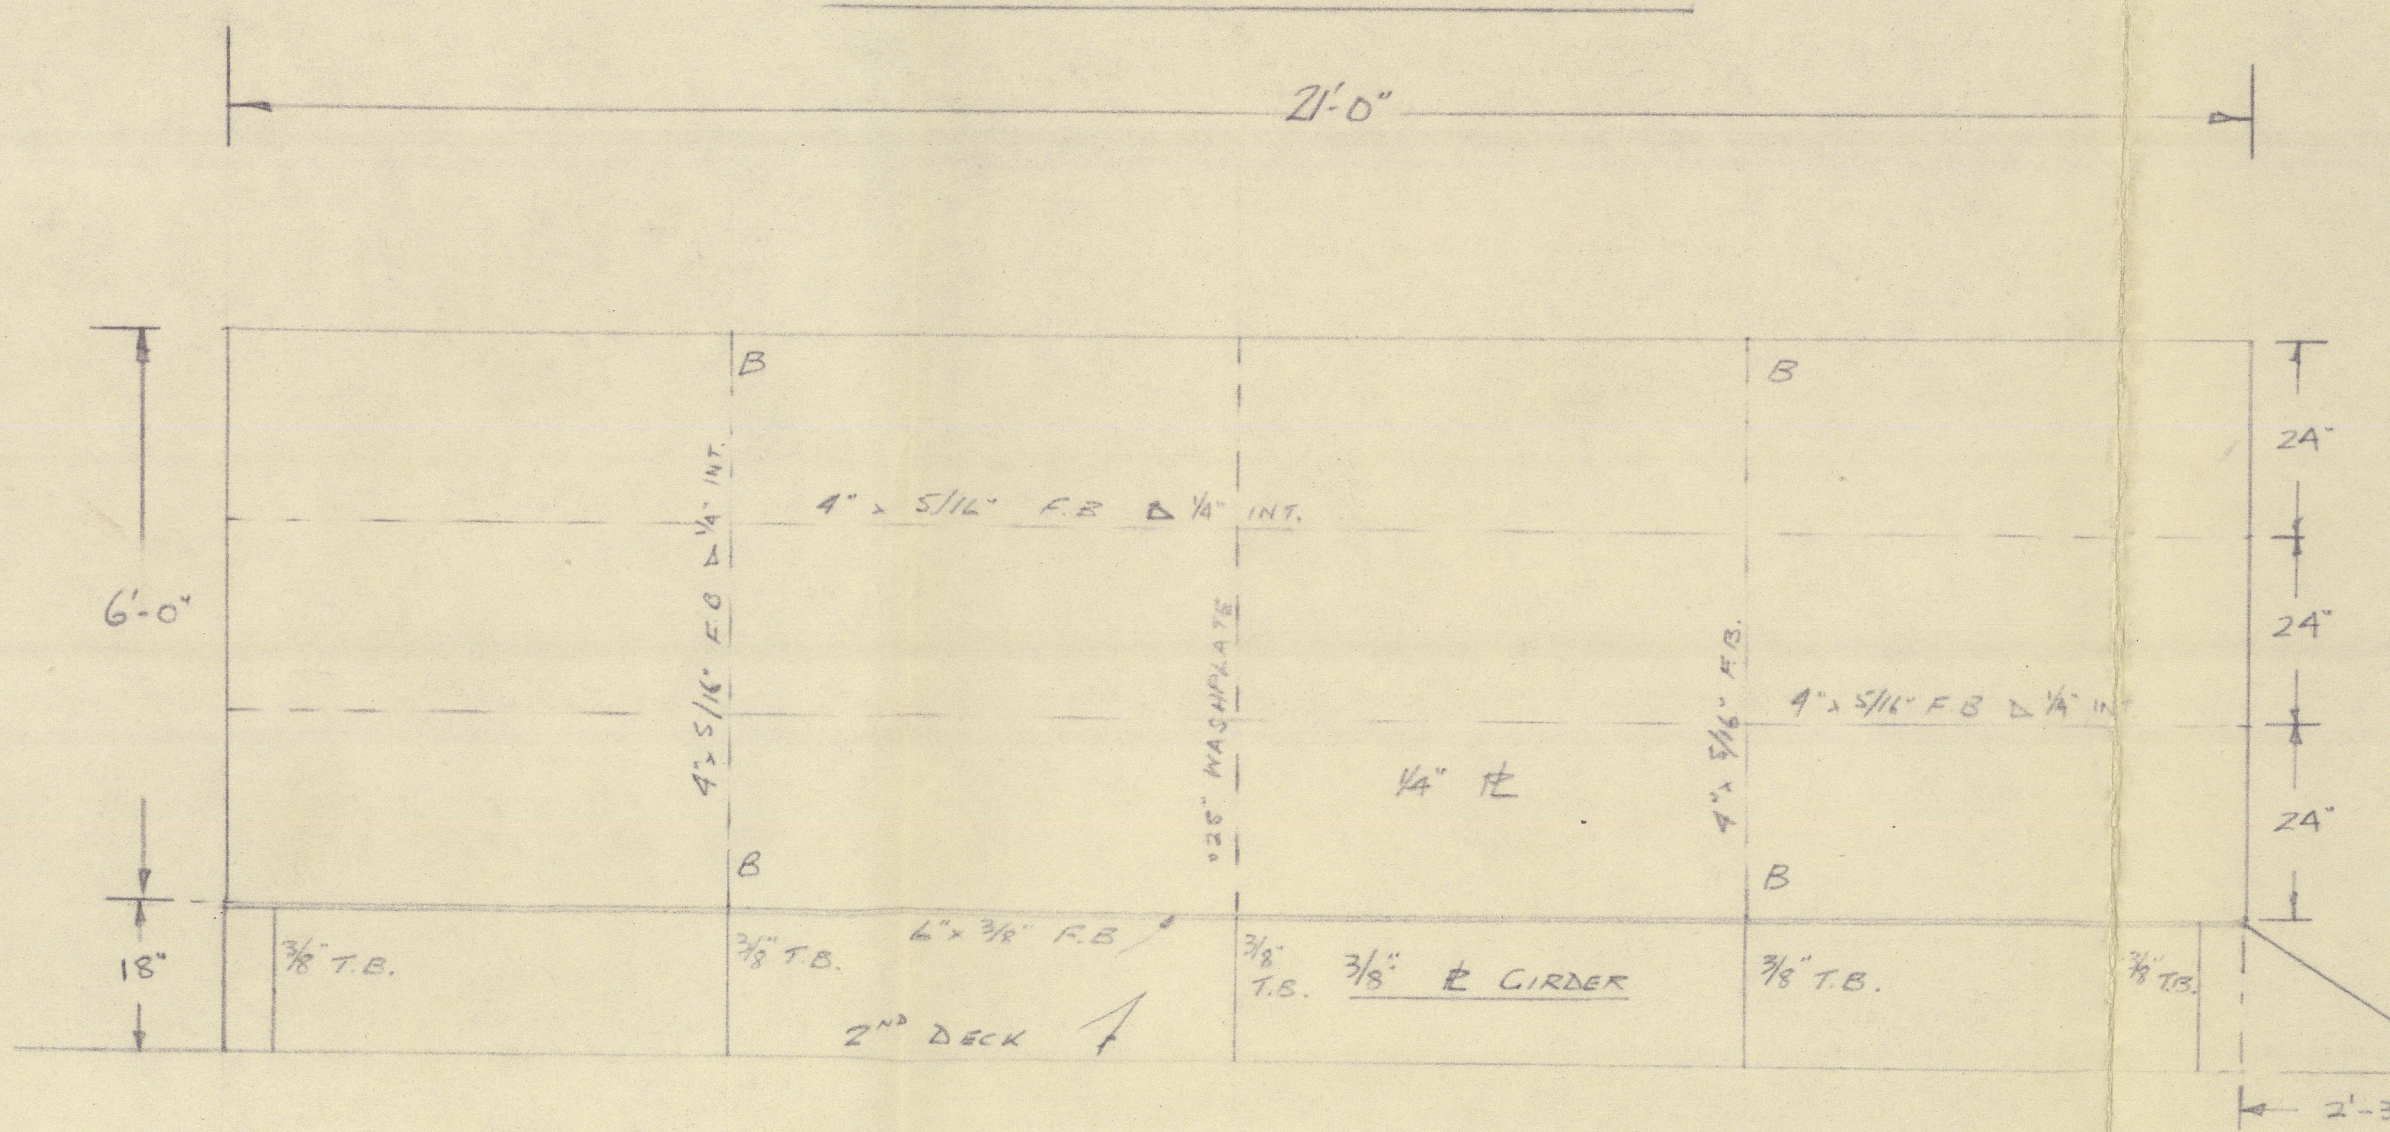


SIDE ELEVATION OF TANK

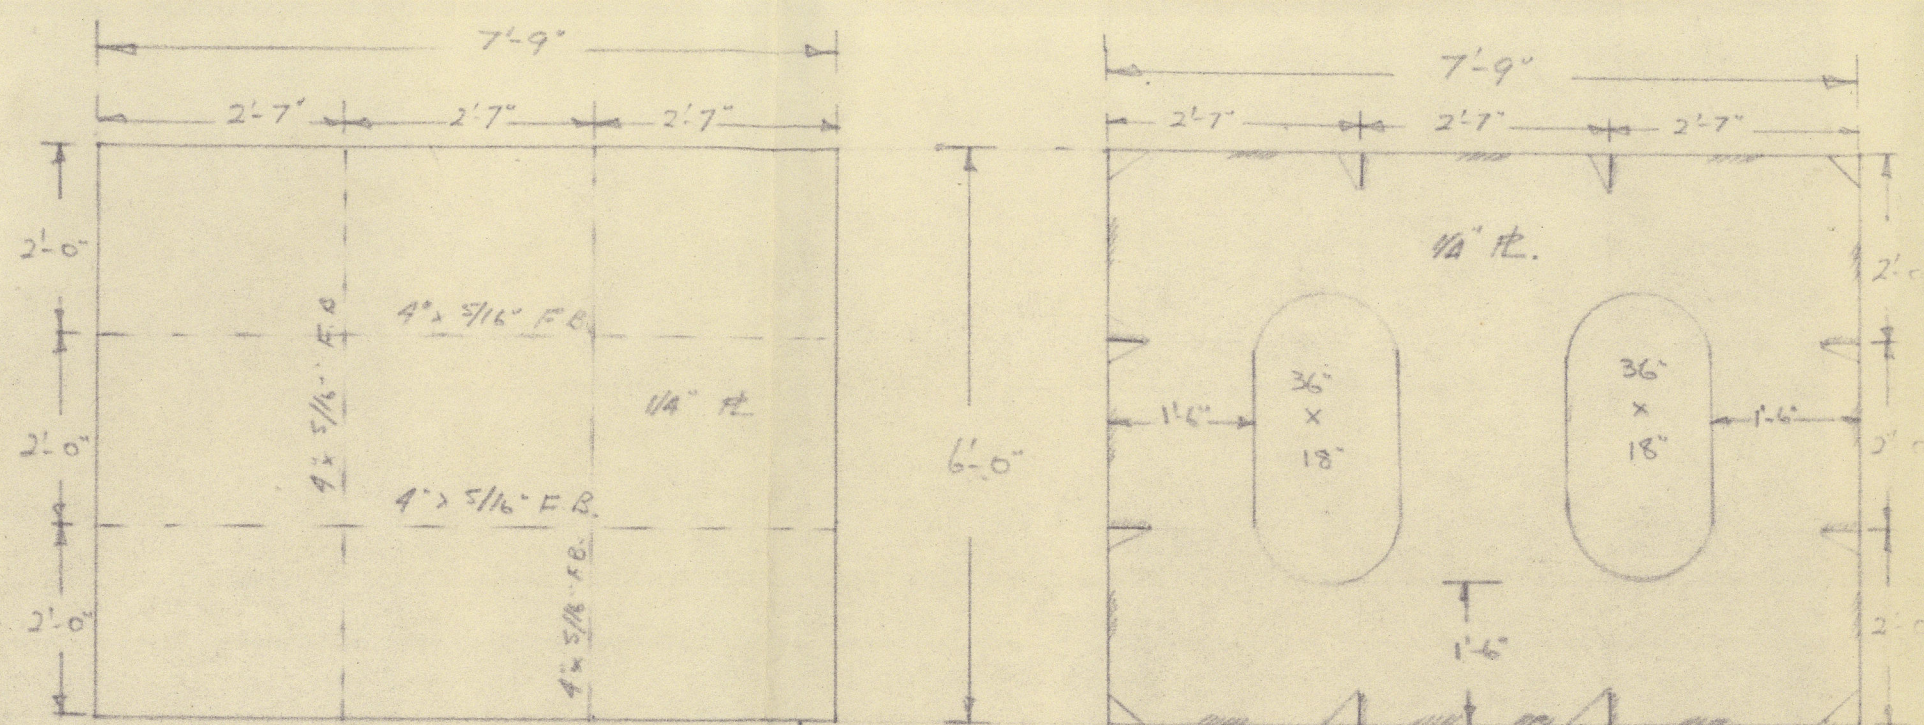


END VIEW OF TANK

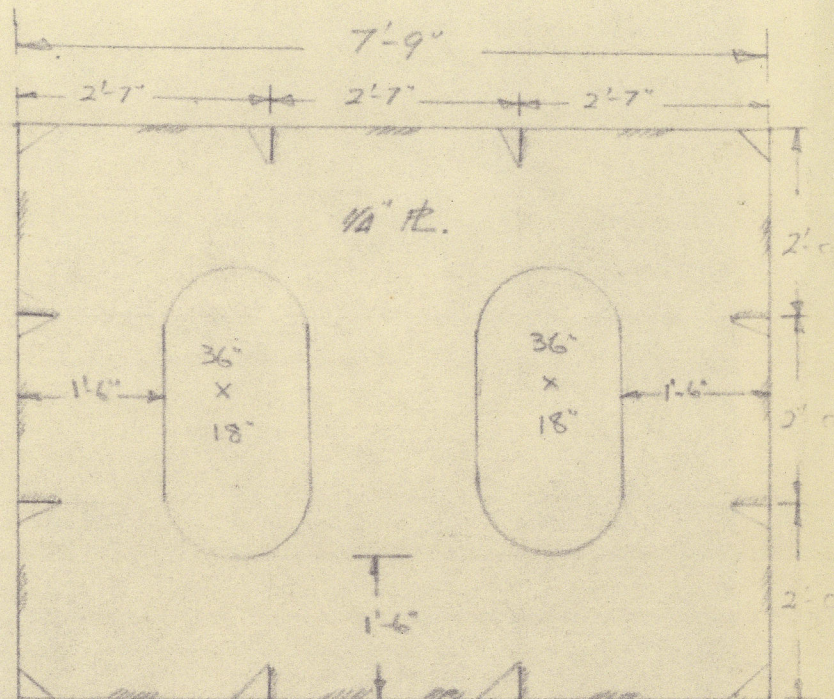


WASH PLATE

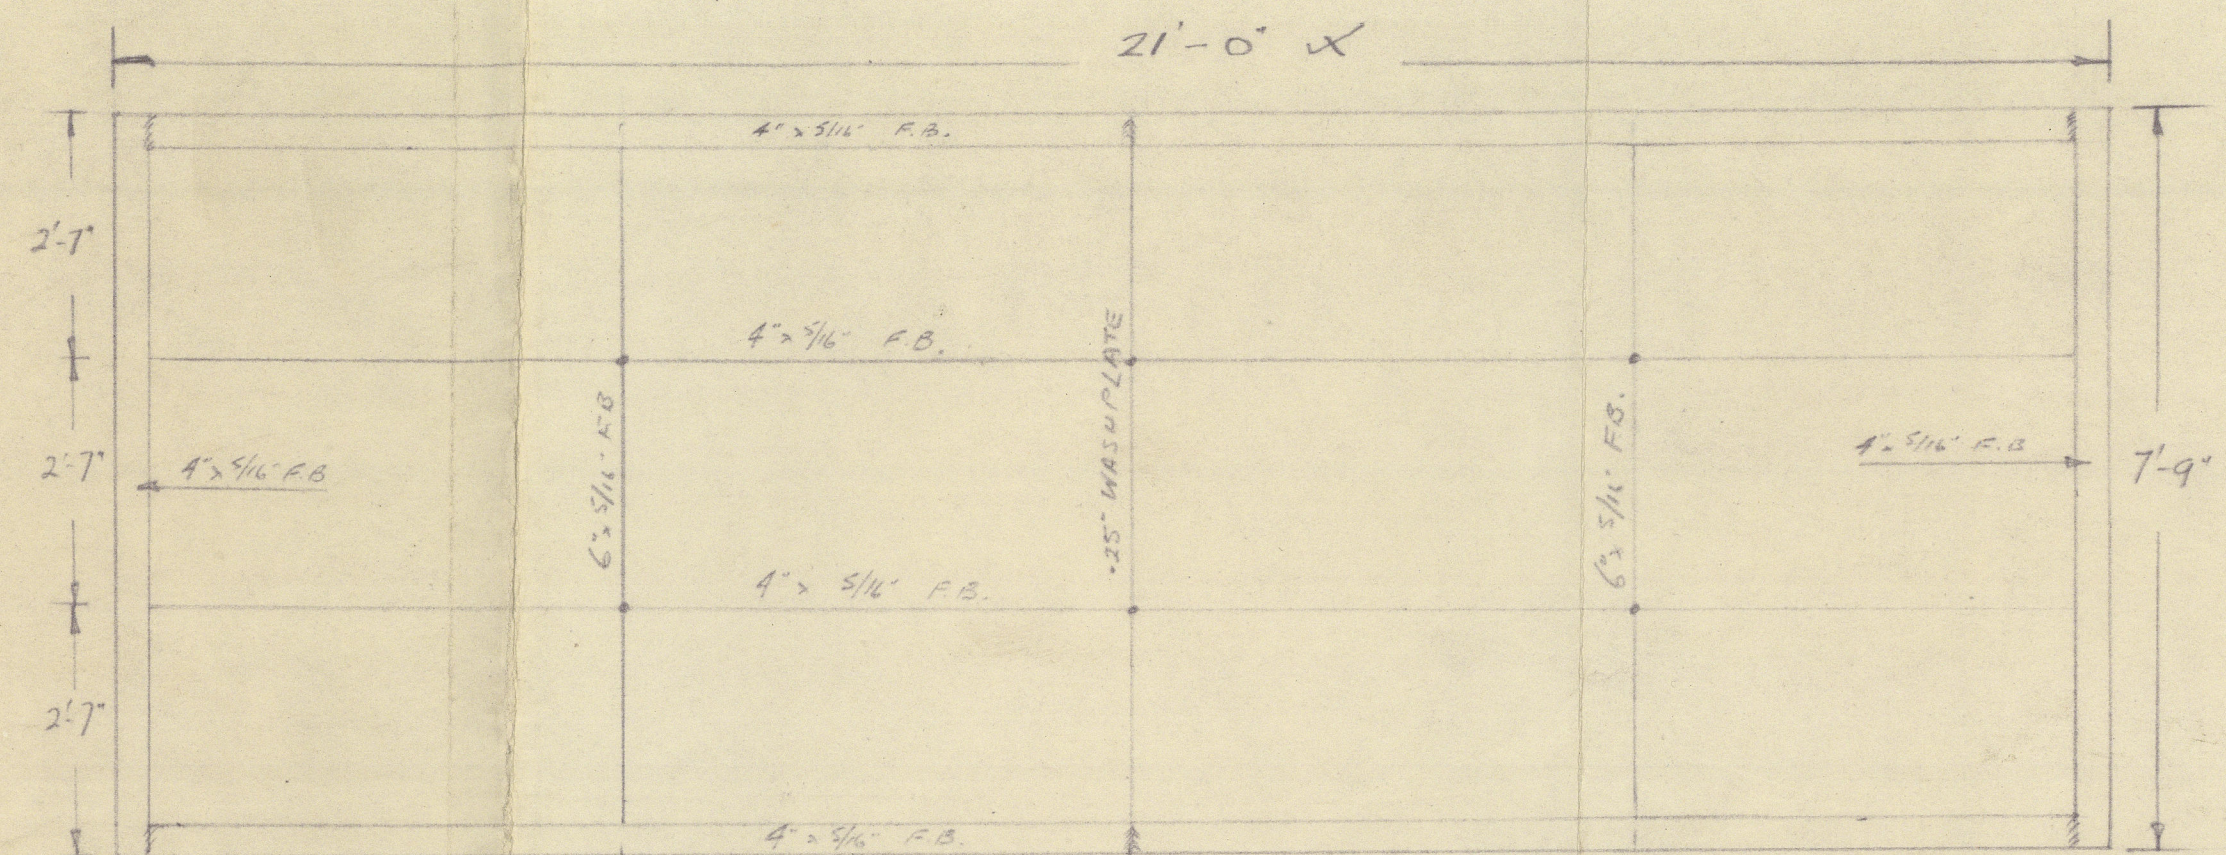

PLAN VIEW 2'-0" ABOVE BOTTOM OF TANK

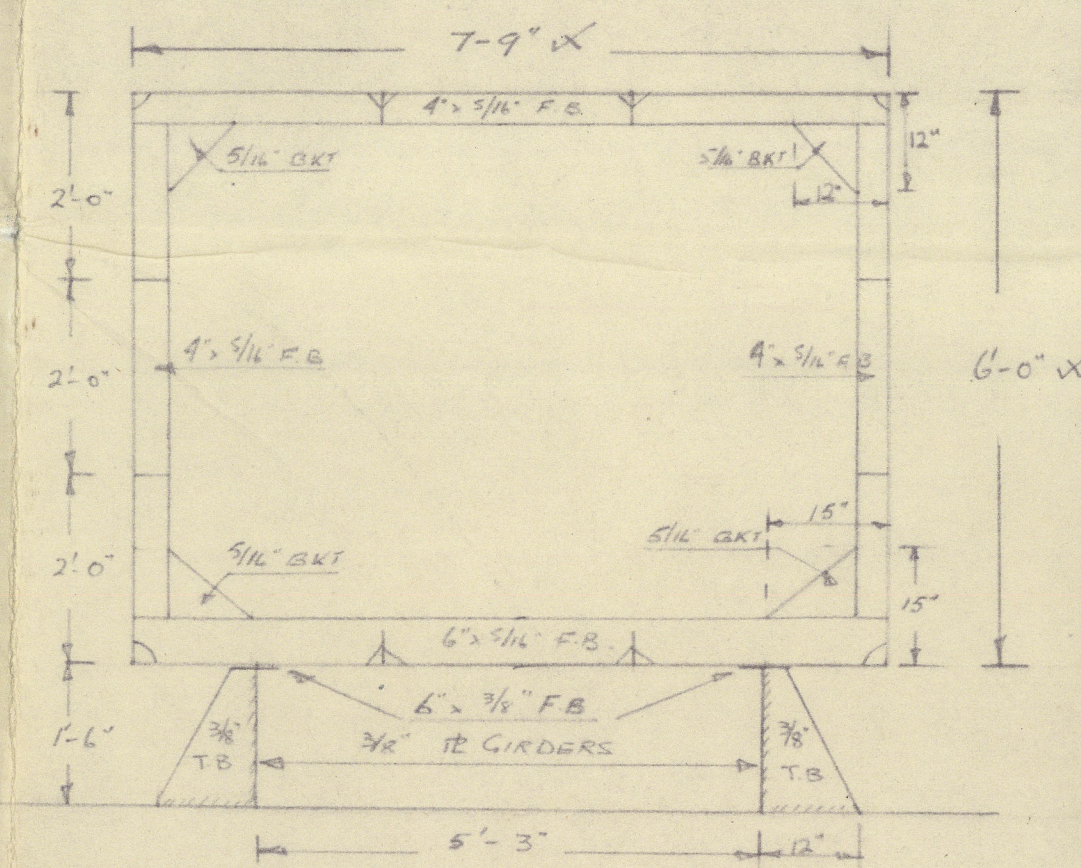

SECTION THRO' TANK

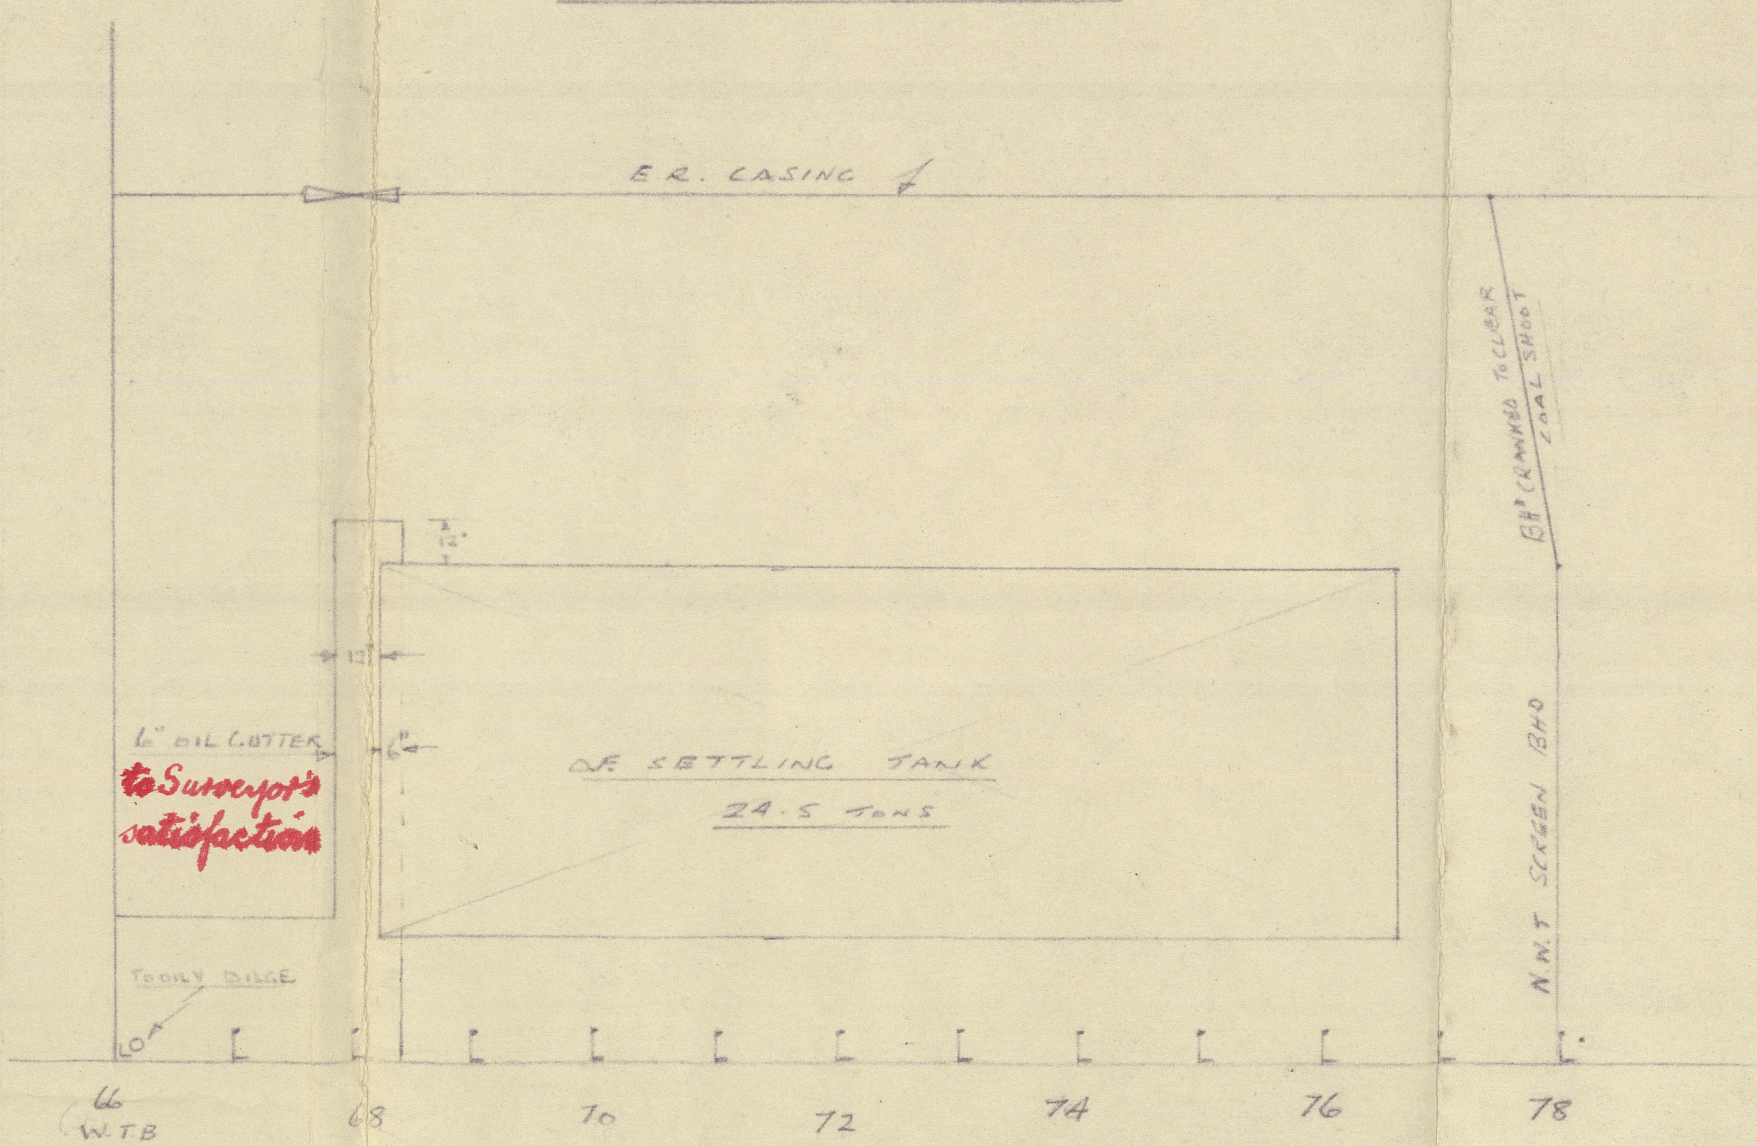

to Surveyor's satisfaction

EXTERNAL DIMENSIONS

SOUTHWICK, EX FORT TAVISTOCK

PROPOSED OF SETTLING TANK  
SCALE: 1/2" = 1'

FLASH POINT OF O.R. ABOVE 150°F.  
HEIGHT OF OVERFLOW 3'-6" ABOVE TOP OF TANK.  
AIR PIPES TO BE 50% GREATER AREA THAN FILLING.  
TANKS TO BE TESTED TO 8 FT HEAD.  
TANKS TO BE EFFICIENTLY STAYED TO SHIP STRUCTURE.

APPROVED  
LLOYD'S REGISTER OF SHIPPING  
UNITED KINGDOM  
CORPORATION REGISTER  
J. B. P. H. H. H.  
Date 8-2-55  
W.H.H.

SURVEYOR'S COPY

