


PROFILE & DECK PLANS


DIMENSIONS: LENGTH B.P. 405-0 BREADTH M² 54-3 DEPTH M² 35-2

ISHERWOOD SYSTEM (PATENT)

SCALE 1/8" = 1'-0"

 


SHEERSTRAKE .90 AT POOP FRONT & BRIDGE ENDS .96
BULKHEAD PLATING .50 AT POOP FRONT & BRIDGE ENDS
POOP SIDE PLATING CARRIED DOWN TO DECK AT POOP FRONT & BRIDGE ENDS

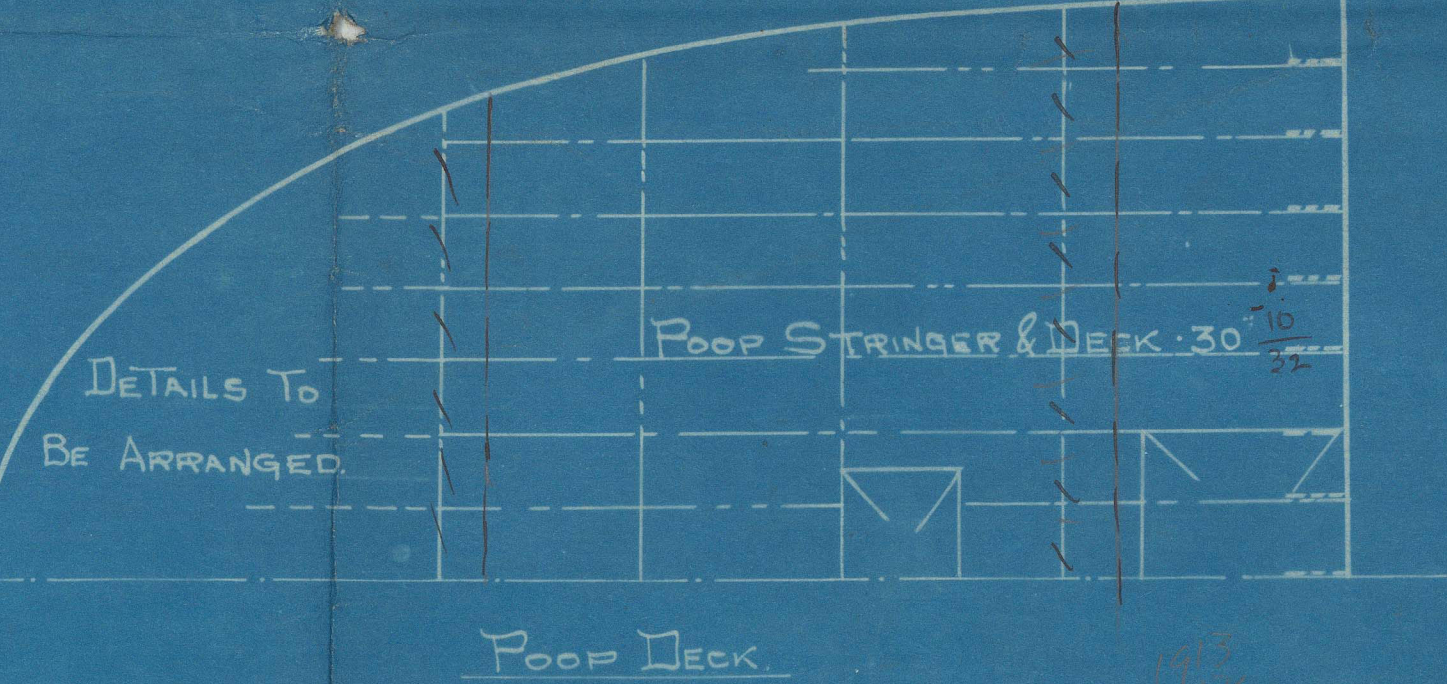

THE LOWER STRAKES OF TRANSVERSE & LONG BMD PLATING EXCLUDING FLOOR PLATE & C² GIRDER, TO BE INCREASED IN THICKNESS WHERE BMD OR INCREASED DEPTH DUE TO SHEER, WHERE ADDITIONAL STIFFS TO TRANS & LONG BMD ARE REQUIRED IN VIEW OF INCREASED DEPTH DUE TO SHEER. STIFFS TO BE GRANTED FROM TOP OF TRUNK, THE ADDITIONAL STIFFS TO BE INCREASED ABOVE SIZE OF LOWEST STIFF, SHOWN ON MIDSHIP SECTION 1/2 IN DEPTH OR 1/4 IN THICKNESS FOR EACH ADDITIONAL ONE. TRUNK DECK TO BE ASSUMED AT A POINT 8-0 BELOW UPPER DECK.

ARRANGEMENTS IN WAY OF INCREASED HEIGHT OF THREE DECKS DUE TO TANK DECK BEING PARALLEL TO BASE TO BE SPECIALLY CONSIDERED.

 

WISHERWOOD
A. W. W. W.
ISHERWOOD SYSTEM OF
SHIP CONSTRUCTION

(2)
Russell & Co No 702

Imports

Profile. Deck Plans

⁴
Drumble Leaf

S S Russell



Grh Pt Entry 17136

4

