SECRET AND CONFIDENTIAL

No. 1015

Sections of Framing in Stern

Scale 1/4" = 1'0"

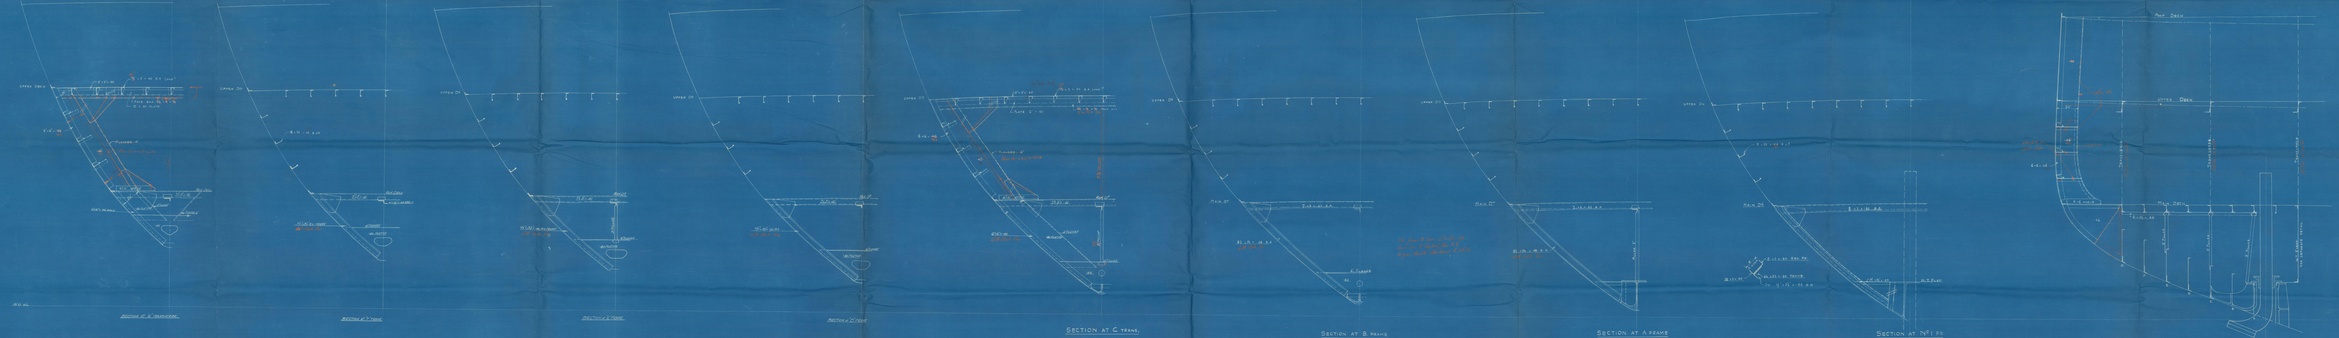

Lloyd's Register Foundation

Russell v Cos Nov/02

Greenock

Stern Framing

82

5

© 2020
Lloyd's Register Foundation
010502-010508-0062