

Lloyd's Register of Shipping.

Ship's Name

BRAMBLELEAF

Official No. 140287

Memorandum of alterations reported since ship was surveyed for assignment of Load Lines

JUNE, 1932.

in

Hatch on forecastle deck 3'11" x 2'11" fitted with $\frac{3}{8}$ " thick steel cover with hinged rubber jointed manhole. 8 stufs spaced 16 $\frac{1}{2}$ "

Hatches on upper deck cofferdams 2 @ 2'5 $\frac{1}{4}$ " x 2'5 $\frac{1}{4}$ "
6 @ 2'5 $\frac{1}{4}$ " x 1'8 $\frac{1}{4}$ "

VENTILATORS.

Foc'le deck 12 @ 5" to 16" diam. 2'0" to 4'6" high x .25" thick

Boat deck 23 @ 8" to 33" " 1'6" to 11'10" " " .375" "

Poop deck 18 @ 6" to 16" " 9" to 6'9" " " .25" "

AIR PIPES.


Foc'le deck 4" and 6" diam., 15" and 16" high

Freeboard dk. 6" diam., 48" and 50" high

Poop deck 4" to 6" diam 13" and 16" high

Boat deck 6" diam., 16" high to store room, medical stores and W.C.

GANGWAY.

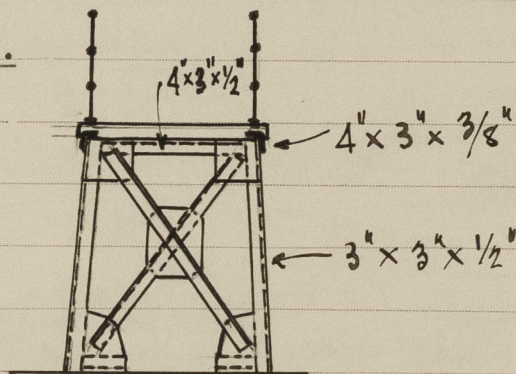

Freeing arrangements.

Forward well freeing ports	5'0" x 1'10"	2) Area 39.8 sq.ft.
)	
	3'10" x 2'0"	1	
)	
	4'0" x 2'4"	1	
)	
	3'0" x 1'6"	1)
)	

(Malta Feb., 1938).

Notes
16 MAR 1938