

25104

Lyd's Register of British & Foreign Shipping. No. 14129.

SURVEYS FOR FREEBOARD.—STEAM SHIPS.

RELATING TO ALL STEAM SHIPS EITHER FLUSH DECKED, OR WITH
TOP GALLANT FORECASTLES, SHORT POOPS AND BRIDGE HOUSES DISCONNECTED, OR
WITH TOP GALLANT FORECASTLES HAVING LONG POOPS, OR RAISED QUARTER DECKS
CONNECTED WITH BRIDGE HOUSES, OR OTHERWISE.

Port of Survey Grenock
Date of Survey 16/4/17
Name of Surveyor J. Bennett

Brambleleaf

Ship's Name Athenaeum
Number in Register Book 702

Ship's Name	Port of Registry and Nationality	Official Number	Gross Tonnage	Date of Build	Particulars of Classification
<u>Athenaeum</u>	<u>Admiralty</u> (32.6 Registered)	<u>14028</u>		<u>1917</u>	* 100 A (Contemplated)
Registered dimensions from Ship's Register.	Length. <u>1405.4</u>	Breadth. <u>54.5</u>	Depth. <u>33.29</u>	Under Deck Tonnage. <u>5275.38</u>	Moulded Depth as measured. <u>35 - 2</u> <i>Wood deck less str</i> <u>32</u> <i>34 - 10 1/2</i>
Length on LOADLINE.	Length. <u>1404.5</u>	Frame Depth. <u>9.7</u>	Ceiling. <u>—</u>	Tanks. <u>7 + 89</u>	NOTE.—If the depth is measured when vessel is afloat, the details of measurement should be reported.
		Rule. <u>7.1</u>	Sheer. <u>+ .31</u>	Below tanks and ceiling on deck floors. <u>- 170</u>	
		—.45	+ .33		
CORRECTED DIMENSIONS.	Length. <u>1404.5</u>	Breadth. <u>54.38</u>	Depth. <u>33.6</u>	Under Deck Tonnage. <u>5194.38</u>	

Co-efficient of fineness.....

70

Any modification necessary
[Para. 4 (a) to (e)]*

Co-efficient as corrected

Sheer { Stem 76 } 104 ÷ 2 = 52 ... Mean
at Sternpost ... 28

Sheer at $\frac{1}{2}$ of the length from { Stem 51 } 68 ÷ 2 = 34 ... Mean
Sternpost 19 .55 = 61.81

Gradual mean Sheer 61.81

Standard mean Sheer [Table, Para. 18] 50.45 34 Correction
Difference 36.36 30.27 3.73 ÷ 4 = - 1

§ If limited as Para. 18 (f).....

Rise in Sheer { At front of bridge house
from amidships } At after end of forecastle

Fall in Sheer { Para. 18 (d) } $\div 2$

Length uncovered

Correction ✓

ALLOWANCE FOR DECK ERECTIONS:—

Freeboard, Table C
Correction for Length, if required (Para. 12, 13, and 14)

6 - 1 1/2

6 - 0 1/2

9 - 0

2 - 11 1/2

18.68

19.25

6.83

6 3/4

Freeboard by Table A, corrected for sheer, and for length, if required (Para. 12, 13, and 14)

Difference

Percentage as below.....

Correction for R. Q. Dk. if engine and boiler openings not covered by bridge house (Para. 11)

Allowance for Deck Erections

Length of Ship

Corresponding percentage { Para. 11, 12, 13, or 14 } 18.68

FREEBOARD recommended amidships from centre of Disc to top of Statutory Deck Line, Wood (Iron) Deck :—

11838-
1404.5 = 7 1/2

11.4.17

Fresh Water Line	above centre of Disc
Indian Summer Line	" " "
Winter Line	below "
Winter North Atlantic Line	" "

If the frames, skin planking, or ceiling are of unusual thickness the breadth of vessel to inside of ceiling should be reported if possible.

In ships of iron, allowances for deck erections under Para. 11 where the sheer drops abeam amidships the height of the R.Q.D. is to be taken from the level of the top of the amidships beam.

In iron-decked vessels the total standard mean sheer means the sheer measured at the stem and stern posts.

In vessels having poops and forecastles it means the sheer measured at points distant one eighth of the vessel's length from stem and stern-post.

n.14. T.


CORRECTION FOR LENGTH.

Length of Ship on Loadline..... 1404.5

Length in Table 1418.5

Difference 14

Correction for 10ft., Table A. 1.7

× Difference divided by 10 2.38 (if required.) 1.12

If $\frac{1}{10}$ ths length covered divide by 2 - 2 1/2 - 1

CORRECTION FOR IRON DECK.

Proportion covered, if less than $\frac{7}{10}$ ths length covered 29.308

Thickness of usual wood deck, less stringer allowed in reduced moulded depth

CORRECTION FOR ROUND OF BEAM.

Breadth at Gunwale amidships..... 53.25

Round of Beam 13.5

Normal round..... 13.31

Difference 1.19 ÷ 2 = .09

Proportion of Deck uncovered (Para. 19)

NOTE.—The round of beam should be reported on the full breadth of vessel at the gunwale.

Freeboard, Table A

Correction for Sheer

Correction for Length

Allowance for Deck Erections

Correction for Round of Beam.....

Correction for fall in Sheer (if any).....

Correction for Iron Deck (if required) Allowed above

Additions for non-compliance with provisions of Para. 11 (d) and (e) {

Other Corrections (if any)

Winter Freeboard

Summer Freeboard 6 1/2

Indian Summer Freeboard

N. A. Winter Freeboard

Correction necessary because clearside amidships, measured in accordance with the Statute is not taken at the intersection of the wood or iron deck with side.

Winter Freeboard from deck line

Summer " " "

Indian Summer " " "

N. A. Winter " " "

Winter Freeboard from deck line

Summer " " "

Indian Summer " " "

N. A. Winter " " "

State dimensions of freeing port area on back of this form.

The Surveyor should state whether the fall in sheer as reported is measured relatively to the straight line of keel or to the water line. If measured relatively to water line the vessel's draft at time of survey, and also the usual load draft forward and aft should be reported.

RECEIVED 16.4.17

Do all the Frames extend to the top height in the Poop?	<i>long fr</i>	Raised Quarter Deck?	<i>yes</i>	Bridge House?	<i>yes</i>	Forecast
To what height do the Reverse Frames extend?	<i>longitudinal framing</i>					
Has the Poop or Raised Quarter Deck an efficient Iron Bulkhead at the fore end?	<i>yes</i>					
Give particulars of the means for closing the openings in Bulkhead	<i>closed front</i>					
Is the Poop or Raised Quarter Deck connected with the Bridge House?	<i>no</i>	Has the Bridge House an efficient Bulkhead at the fore end?	<i>fore end but not watertight</i>			
Give particulars of the means for closing the openings in Bulkhead	<i>hinged door</i>					
What is the thickness of the Bridge Front plating? .40	and Coaming plate? .40	House at centre. Coaming 4 ft. Stiffeners 6x3x34. Plating .40				
Give scantlings and spacing of the Stiffeners 7x3x40 3 ft apart						
Are bracket plates fitted at each end of the Stiffeners Yes to bulkhead each side	Are hor' l. brackets fitted connecting Bridge Bulk'd. with Bulwarks? Brackets to upper deck and hinged to bridge deck in house at centre					
Has the Bridge House an efficient Iron Bulkhead at the after end?	<i>no</i>					
How are the openings closed?						
Is the Forecastle at least as high as the main or top-gallant rail?	<i>yes</i>	Has the Forecastle an efficient Iron or Wood Bulk'd. at after end?	<i>yes</i>			
Are the Engine and Boiler openings covered by a Bridge, Poop, Raised Quarter Deck, or enclosed by a Strong Iron or Steel Deckhouse?	<i>by high casing</i>					
If the openings are not so protected are the exposed parts of the Casings efficiently constructed?	<i>yes</i>					
Give thickness of plating; scantlings and spacing of Stiffeners lower strake of plating .40 upper strake .34, stiffeners 4x2½x36 33 to 39 coamings above bridge deck .30 top .26						
What is the height of the exposed Casings? 10-2½	Are suitable means provided for closing all openings in them in bad weather? yes, hinged with					
Are the Weather Deck Hatchways efficiently constructed and at least equal to the requirements of Section 28 of the Rules for 1904-5? Give particulars below:	<i>oil tight hatches</i>					
Position and Size.						
Item.	Ship.	Rule.	Ship.	Rule.	Ship.	Rule.
COAMING Height above top of DECK						
Thickness { Sides.....	Hatches to oil holds 2-6 x 2-6 x 3-0 high					
Ends.....	Coamings .40 cover .50					
SHIFTING BEAMS OR WEB PLATES. Number						
Section and Scantlings						
Material						
* FORE AND AFTERS. Number						
Section and Scantlings						
Material						
HATCHES Thickness						
Remarks.....						

* When the Fore and Afters are of wood the depth should be stated from the underside of the hatches.

(If the sill of the lowest side scuttle will be less than 6 inches above the Indian Summer Load Line if assigned under the tables, state vertical distance from top of deck at side amidships to lower edge of lowest side scuttle.)

The following information is to be given in all Cases of vessels dealt with under Paras. 11, 12 (under 15 feet Moulded depth) and under Shelter Deck Rules.

What is the thickness of the Bridge Sheerstrake? Strake between Main and Bridge Sheerstrakes?

Delete the words { The Crew are, are not, berthed in the bridge house.
that do not apply { The arrangements to enable them to get backwards and forwards from their quarters are, are not satisfactory.


Length of Bulwarks in well

Area of Freeing Ports required by Para. 11 (e) each side of vessel = Sq. ft.

Ft. Tenths. Ft. Tenths. No.

x	x	Freeing Ports (each side of vessel)	=	Sq. ft.
x	x			

Total deficiency or excess = Sq. ft.

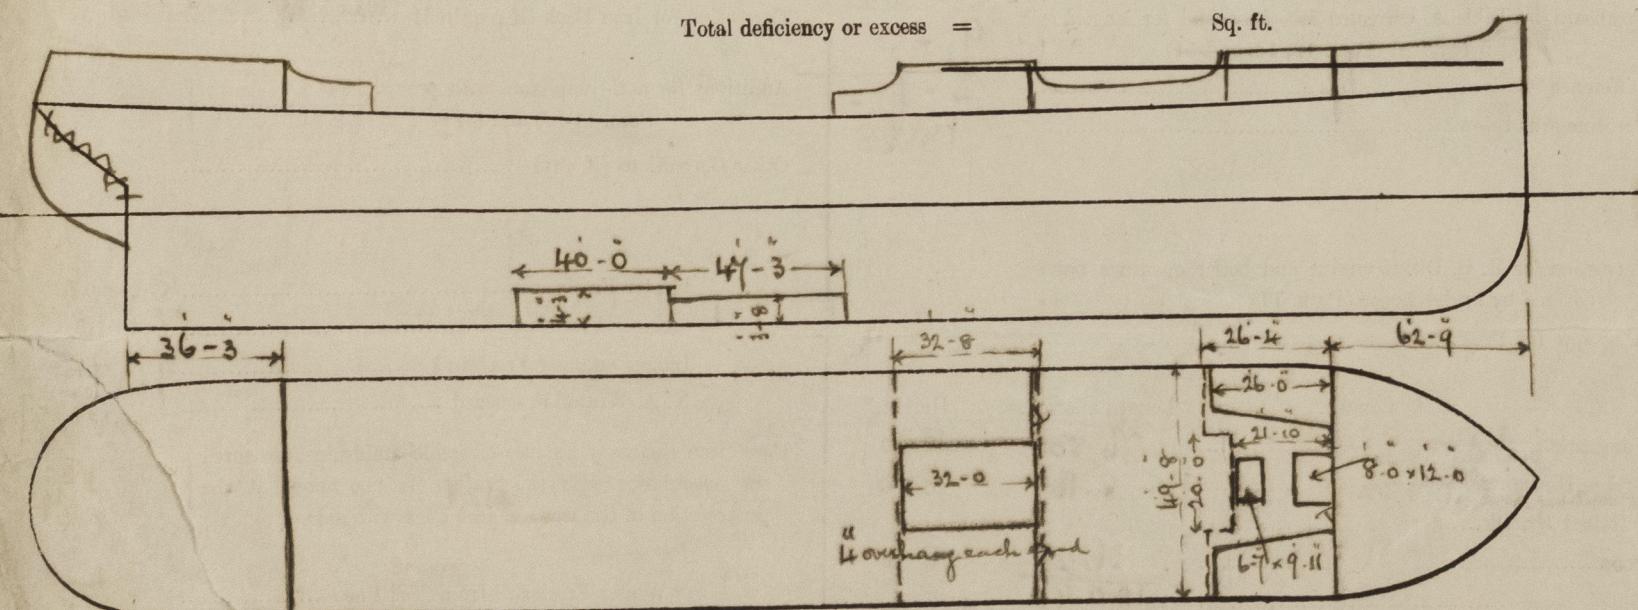

Show hereon line of Floors or Tank Top with position of any Breaks in same; also height of Peak Tank tops, &c., &c.

State any special features in the construction of the Vessel *longitudinal framing, oil tanker, double bottom in engine and boiler spaces*.

lowest sidelight 30-10 from base line. Depth of heel 2 3/4

displacement 2 and tons per inch scale also ship section and profile for owners builders Russell Co.


Sister vessel to 80' min. 1015

Address

Port Glasgow

Fee £

Received by me

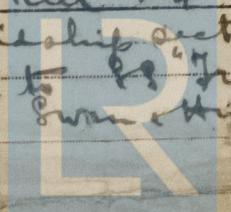

Lloyd's Register
Foundation