


No 5 S.S. Virginia Pierce

# PROFILE & DECK PLAN

LLOYDS D.M.S. - LENGTH 80'0" UPON UPPER DECK 395'6" BREADTH 42'0" DEPTH 26'0"  
TO CLASS 100A1 LLOYDS. SHUTTER DECK WITH FREEBOARD

SCALE 1/8" = 1'0"

MAIN HATCHES  
DETAIL OF SHUTTER DECK HATCH CORNERS  
SCALE 1/2" = 1'0"

Nº 3, 34'0" HATCH  
SIDE COAMING 140  
FLANGED 18  
SIDING PLATE 10-64


FO'CLE DECK

STEAM WINDLASS

FORE PEAK

SHUTTER DECK

UPPER DECK

 

S.N. 197



FOR ENCLOSURE TO

Lloyd's

Middlesbrough

From FURNESS SHIPBUILDING CO. LD.  
HAVERTON HILL-ON-TEES.

Thos. Furness S. B. & Co.

No 5

PROFILE AND DECK PLANS  
(AS BUILT)

S.S. VIRGINIA PEIRCE

Draw. Rpt. No 11008

*Angela Mendi*

\*Mente Salliche\*




© 2020

Lloyd's Register  
Foundation

010502-010508-0117



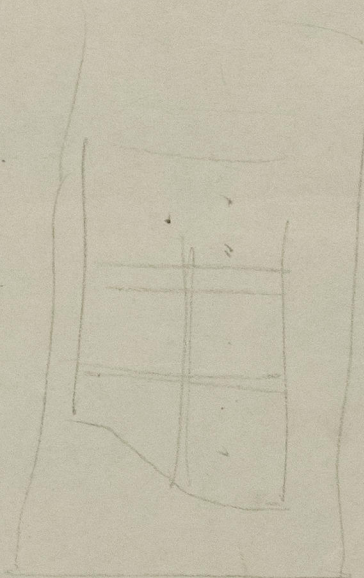

© 2020

Lloyd's Register  
Foundation