

L(B,D) = 19,3 (333 + 14436) =	9200	9213
VOORSCHIP + BRUGDEK = 0,75 x 170 x 754 =	960	961
DEKUIZEN OP BRUGDEK = 0,5 x 86 x 754 =	305	324
<small>Casing 234 x 12-50</small> DEKUIZEN OP BOVENBRUGDEK = 0,5 x 338 x 72 =	422	128

3 - KLIPANKERS STOKLOOS ELK 1850 KG.  
1 - STROOMANKER GEWICHT MET STOK 420 KG.  
425 METER DAMANKERKETTING (17,25 LENGTEN).  
140 METER STAALDRAAD OMTREK 89 m.m.  
165 METER  $3\frac{1}{4}$ " - 6 x 12 SLEEPTROS.  
165 METER  $2\frac{1}{4}$ " - 6 x 12 MEERDRAAD.  
165 METER  $1\frac{3}{4}$ " - 6,12 MEERDRAAD


3430 by total  
380 by.  
385 hbr.

DUBBEL SCHROEF MOTORSCHIP.  
CLASSE LLOYD'S  $\div$  100 A1


<u>HOOFDAFMETINGEN.</u>	
LENGTE OVER ALLES	64,50 M.
LENGTE OP DE C.W.L.	60 - M.
BREEDTE.	10,15 M.
HOLTE TOT BOVENDEK.	4,40 M.
DIEPGANG	3 - M.

SPANT 65.

SPANT 30.

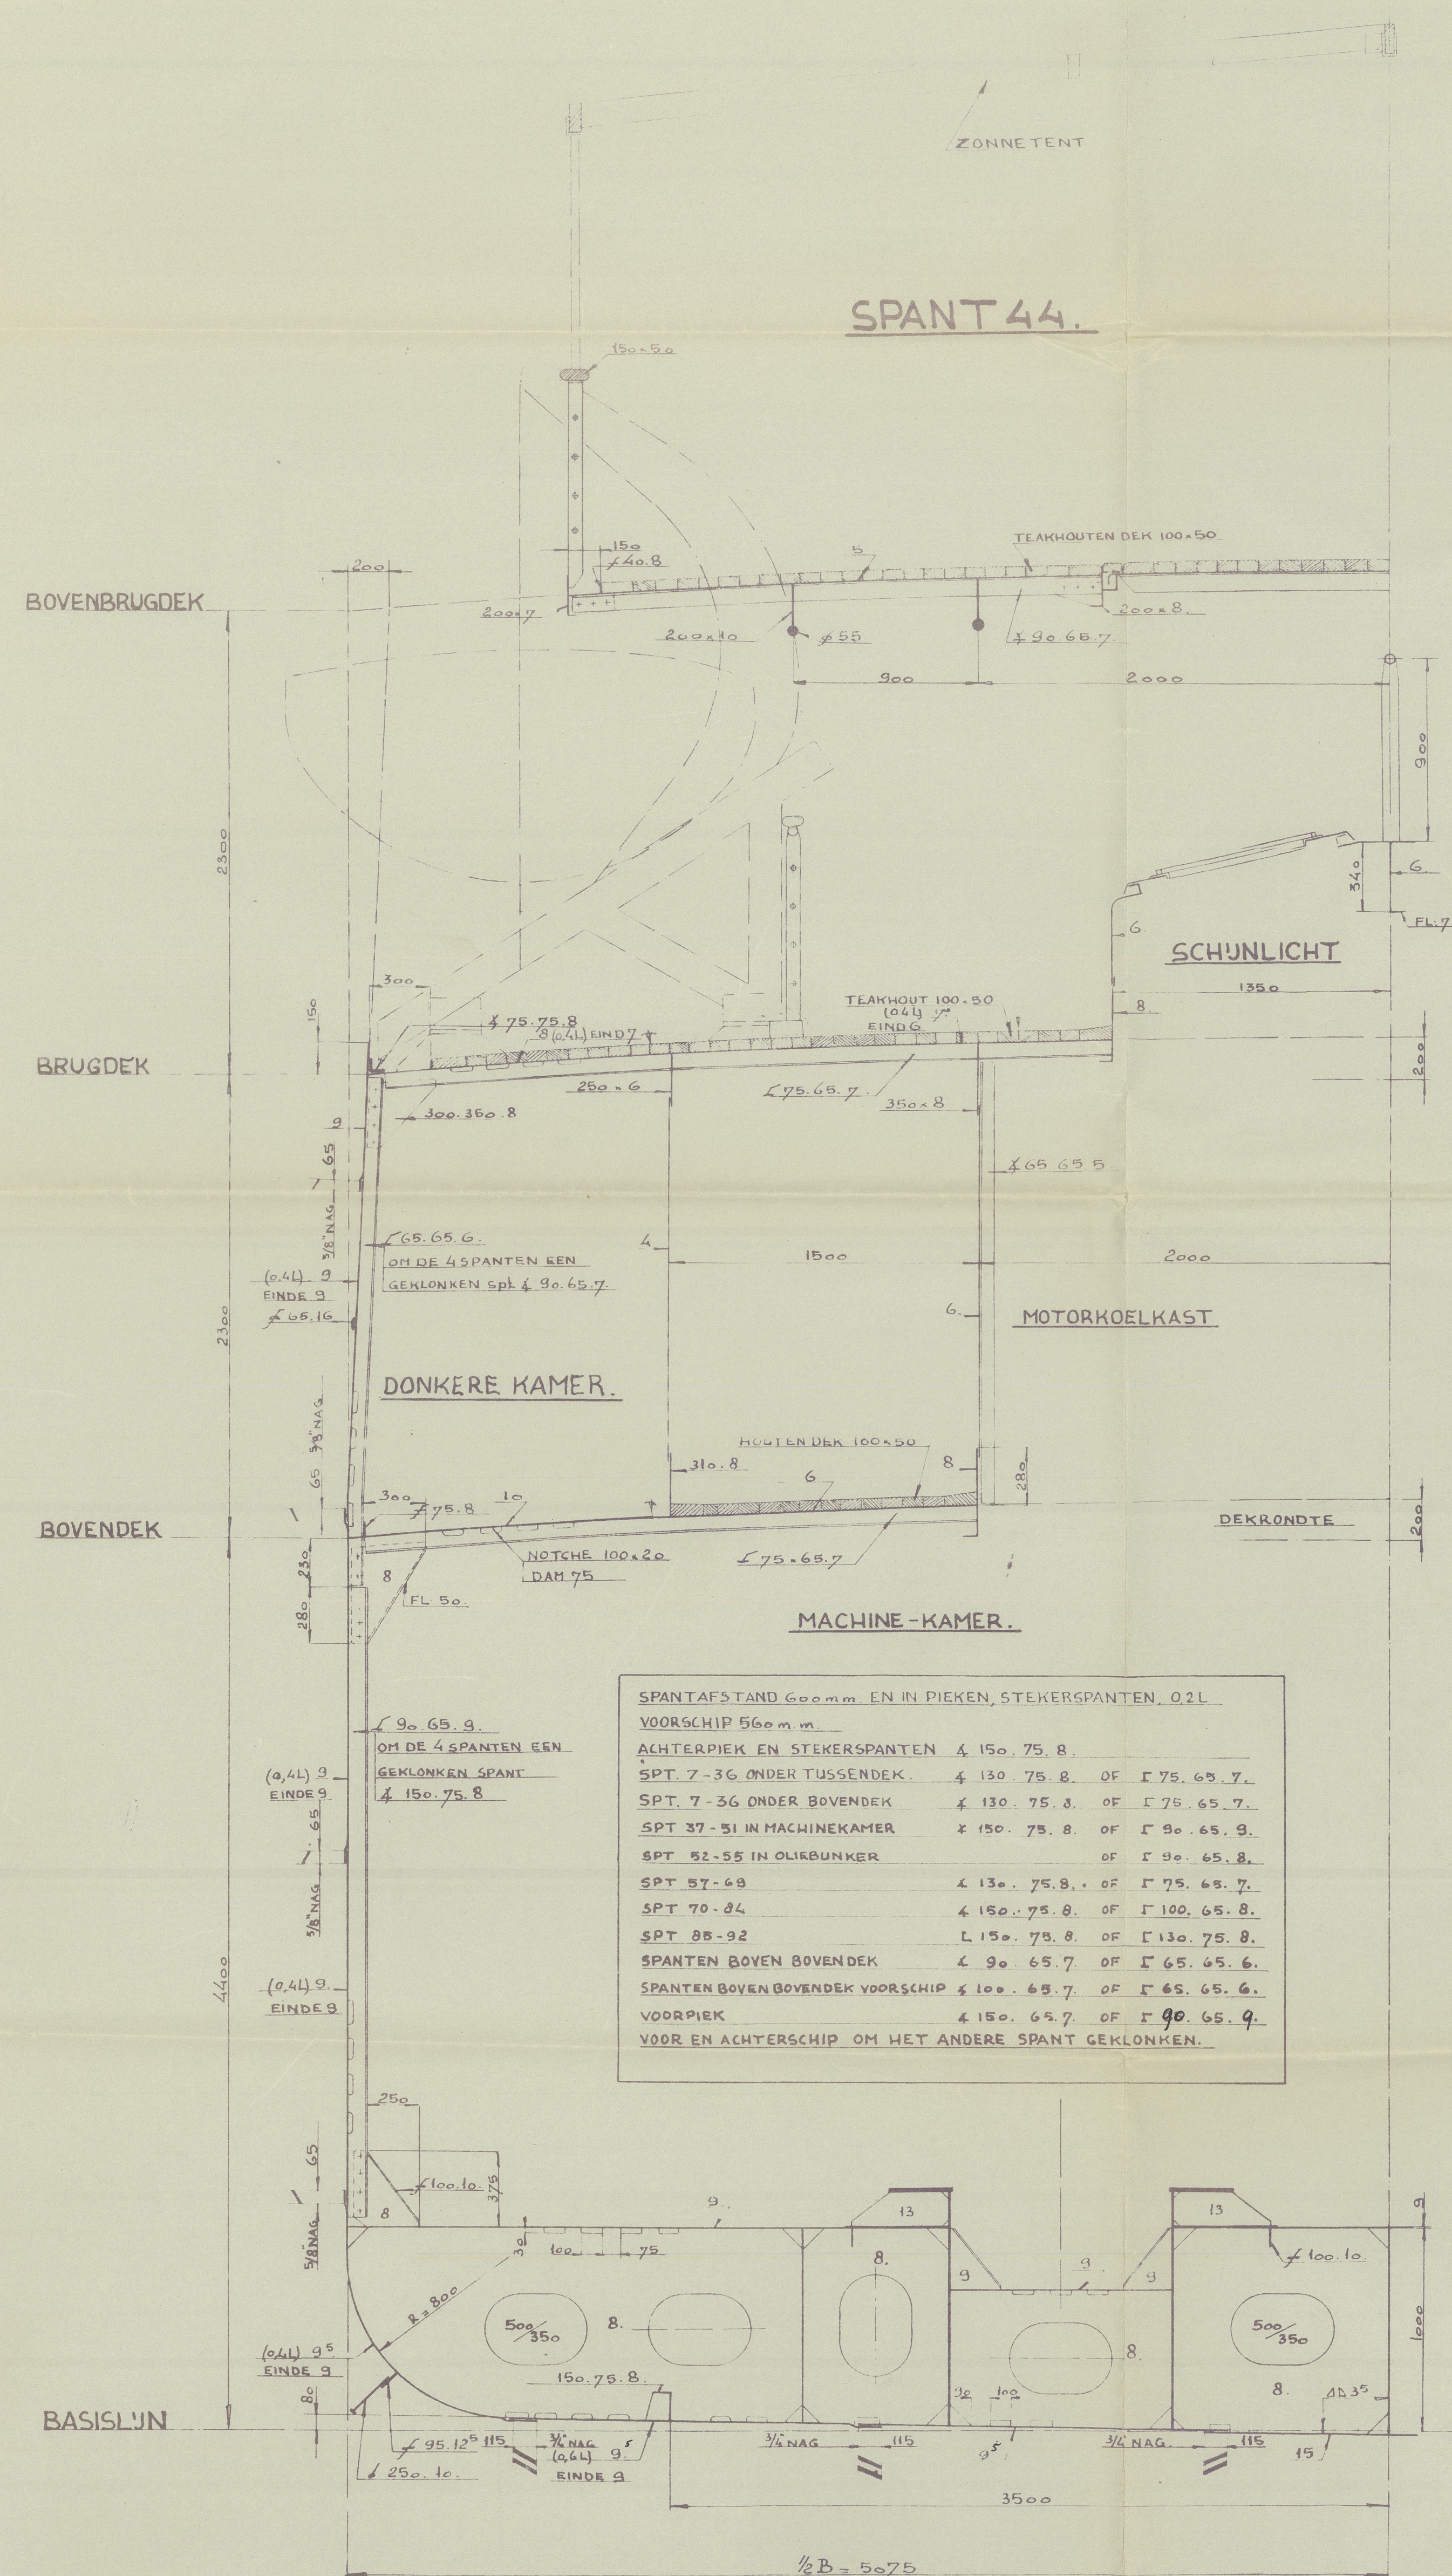

WD VRANGEN 9mm - STULEN 1 65.65.6. GELAST - AFSTAND 760mm.

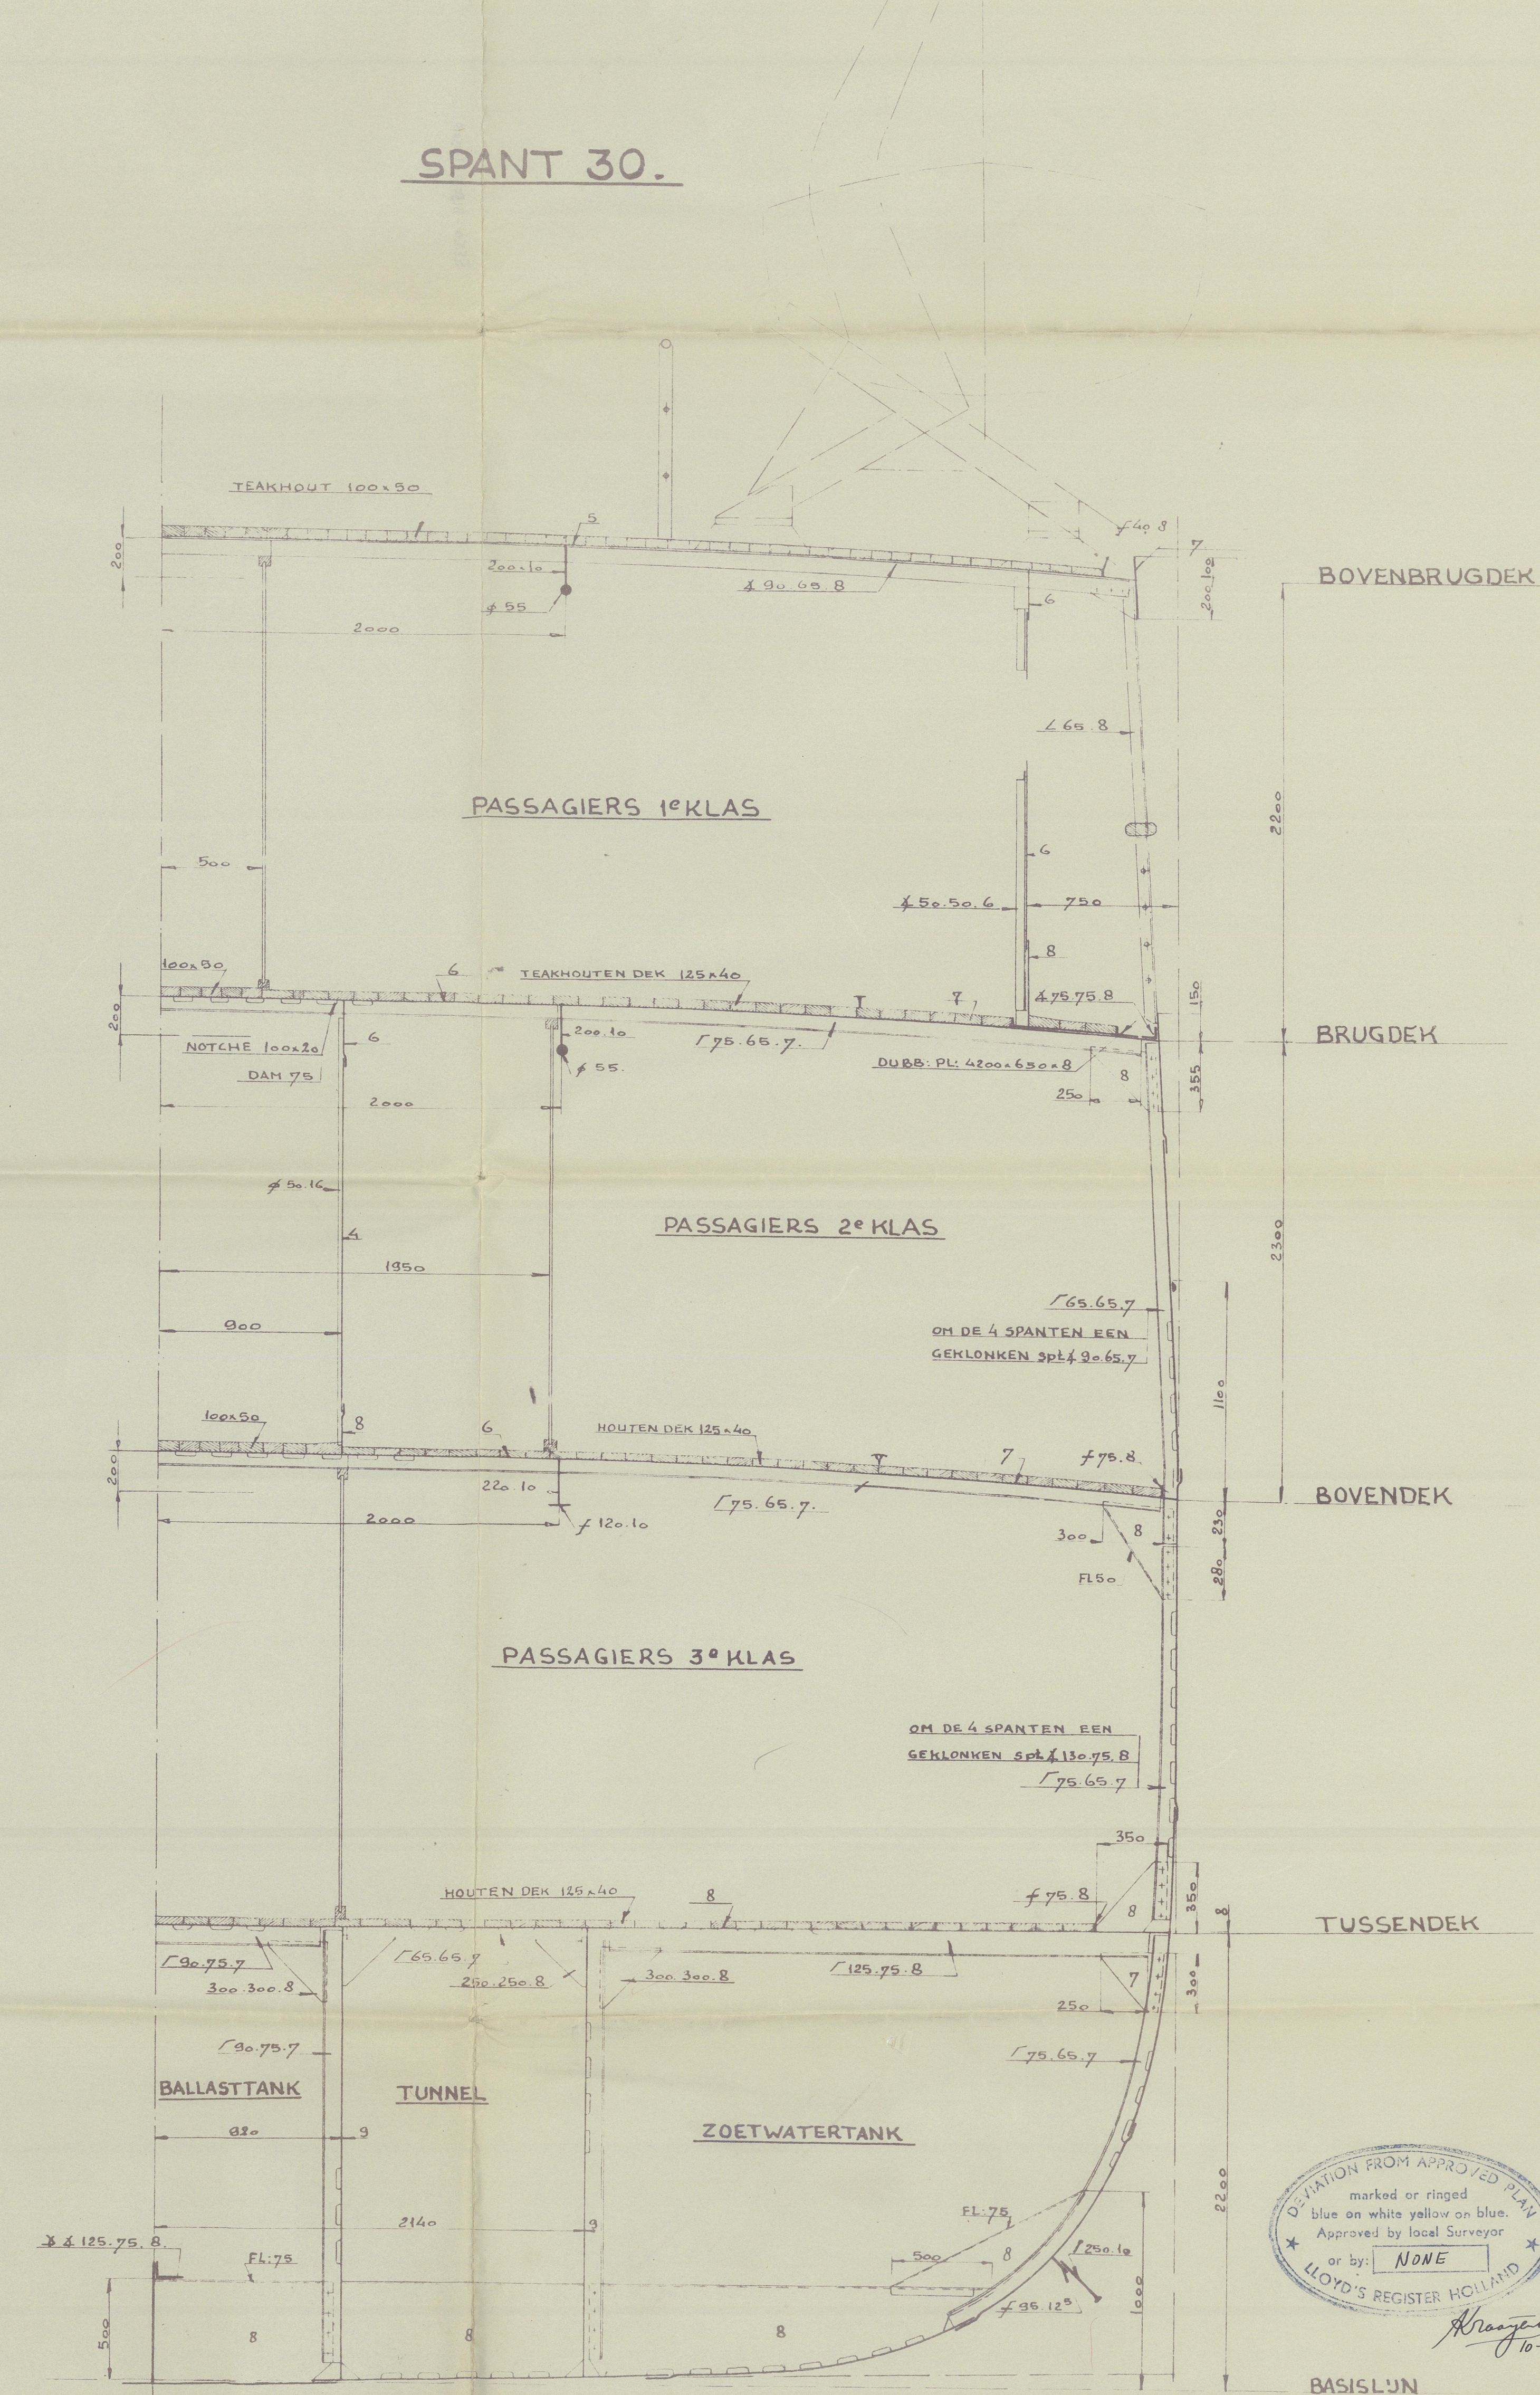


REVISIE - TEKENING

[illegible]



RECORDS DEPT.,  
LONDON

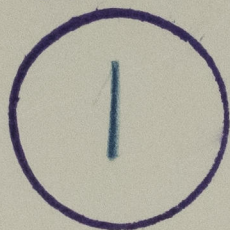

Mengkara ★  
Midship Section



© 2021

Lloyd's Register  
Foundation

010509-010518-0333