


Lloyd's Register of Shipping.
SURVEYS FOR FREEBOARD.
(CONDITIONS OF ASSIGNMENT.)

Ship's Name LA PLATA Port of Survey Rotterdam
Official Number _____ Surveyor's Signature J. Wiskoot
Nationality and Port of Registry Argentine, Buenos Aires Date of Survey October 1950

Disposition and dimensions of superstructures, trunks, deckhouses and machinery casings to be inserted in the diagrams and tabular statement:--

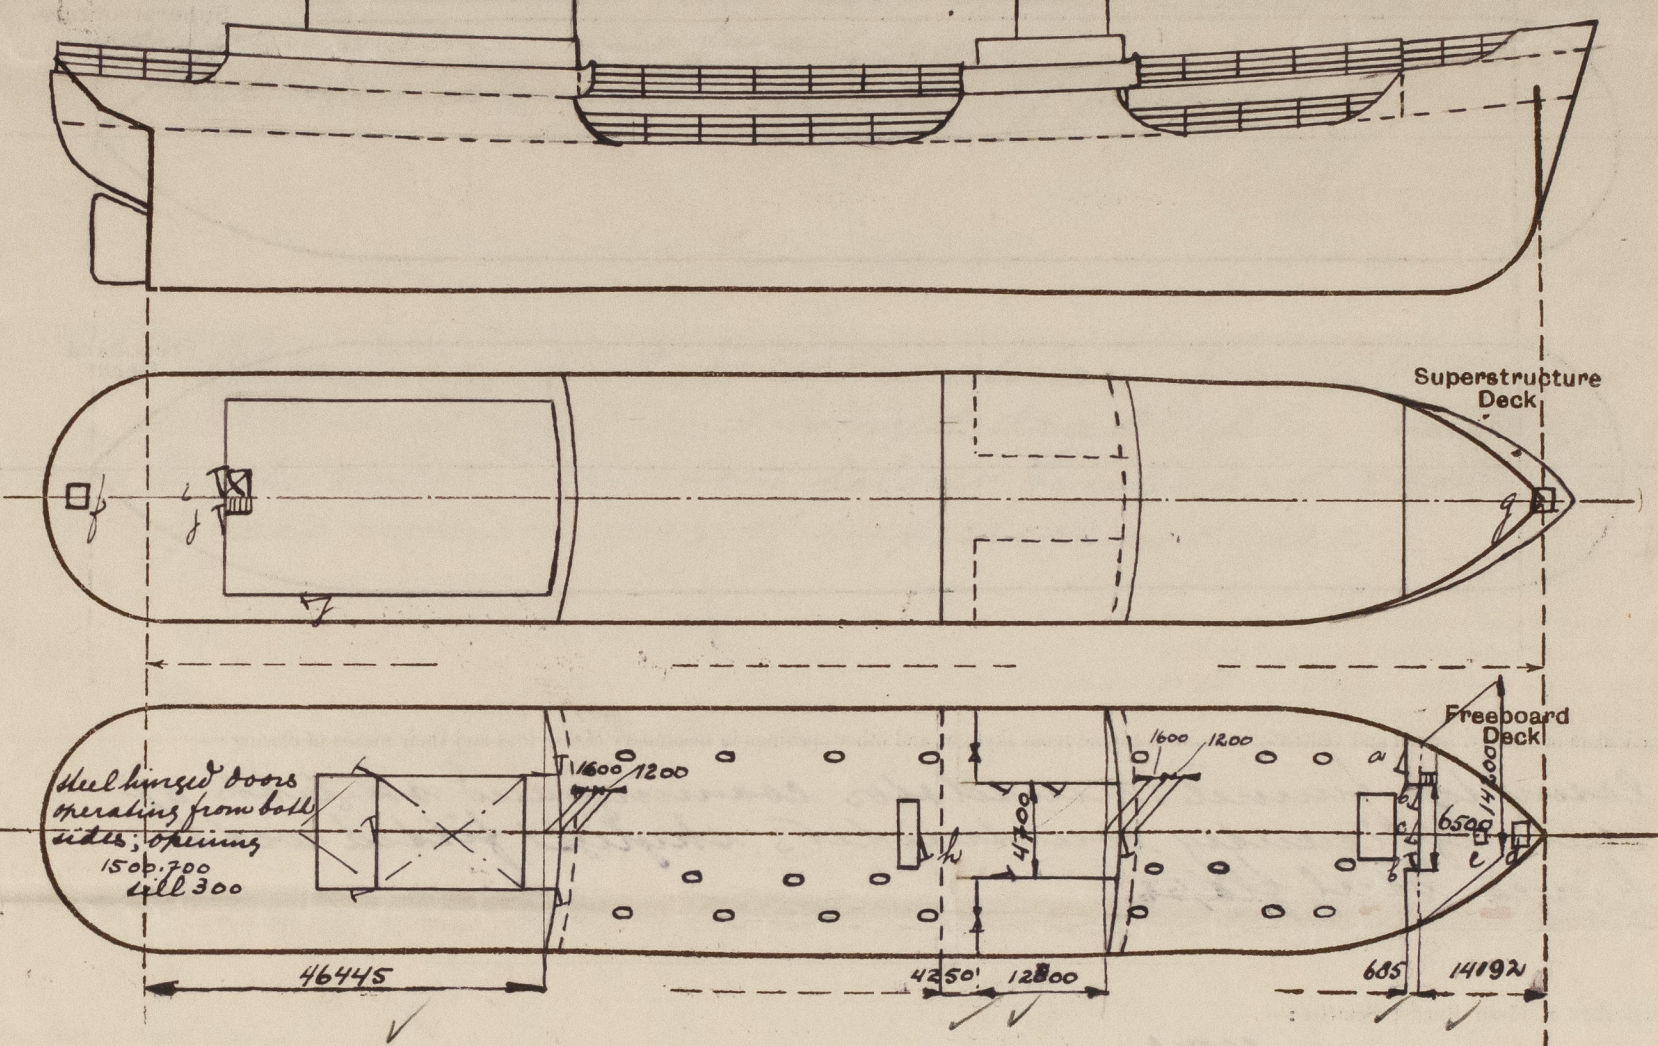


Particulars of Superstructures, Trunks, Casings, Deckhouses.								
	Coaming	Plating	Stiffeners	Spacing mm	End Attachments of Stiffeners	Size of Openings	Height of Sills	Height of Casings
Poop Bulkhead	12	11	L240.90.14	760	elect. welded	1350.700	610	
Raised Quarter Deck Bulkhead ...								
Bridge, After Bulkhead	10	7 1/2	L100.65.8	800	none	5'x4'	610	
Bridge, Forward Bulkhead	11	11	L250.90.14	760	elect. welded	1600.700	350	
Forecastle Bulkhead	10	7 1/2	L100.75.8	760	none	21500.700	500	
Trunk, Aft						61750.630	230	
Trunk, Forward						c 1600.630	370.	
Exposed Machinery Casings on Free- board or Raised Quarter Decks ...								
Exposed Machinery Casings on Super- structure Decks								
Machinery Casings within Superstruc- tures not fitted with Class I Closing Appliances								
Deckhouses on Flush Deck Ships ...								

Particulars of Closing Appliances (state if capable of being manipulated from both sides).	
Poop Bulkhead	Steel hinged, w. l. doors capable of being manipulated from both sides
Raised Quarter Deck Bulkhead ...	
Bridge, After Bulkhead	Steel doors on hook bolts not passing through bulkhead
Bridge, Forward Bulkhead	Steel hinged, w. l. door, capable of being manipulated from both sides
Forecastle Bulkhead	
Exposed Machinery Casings on Free- board or Raised Quarter Decks ...	a
Exposed Machinery Casings on Super- structure Decks	b, c steel hinged doors capable of being manipulated from both sides.
Machinery Casings within Superstruc- tures not fitted with Class I Closing Appliances	
Deckhouses on Flush Deck Ships ...	

PARTICULARS OF PROTECTION TO OPENINGS, ETC.

The following diagrams should be used to indicate the positions of cargo and coaling hatchways, gangway, cargo and coaling ports, ventilators, companionways, etc., which would affect the seaworthiness of the ship:—

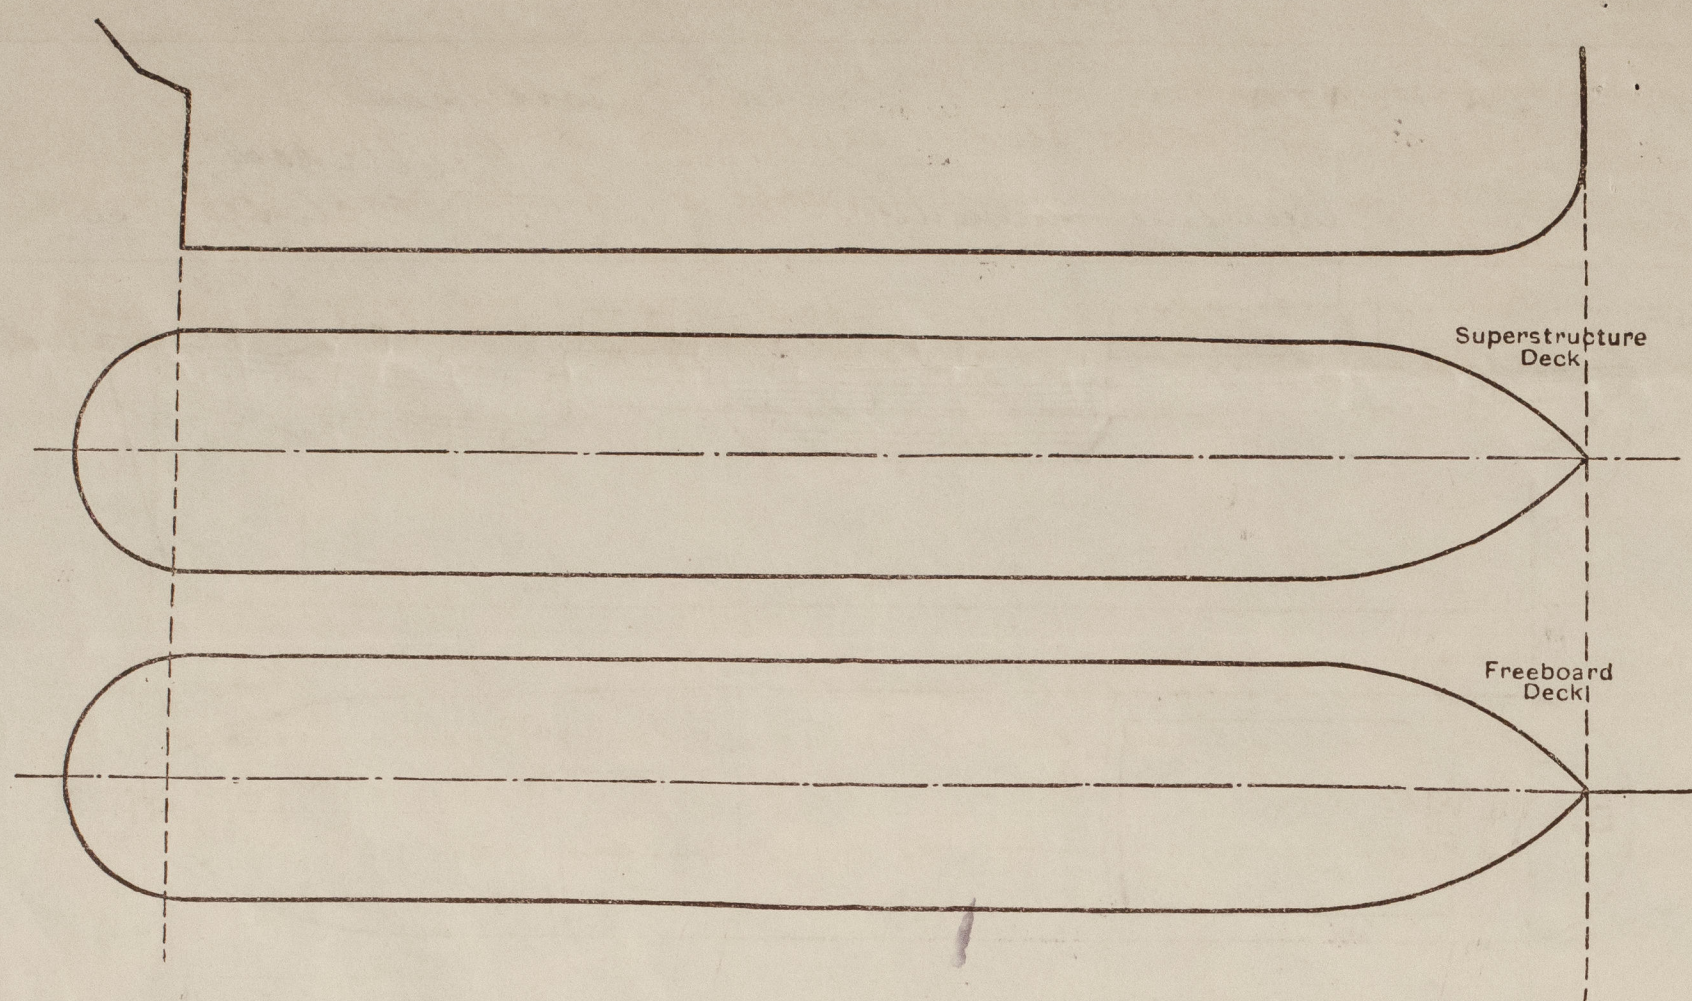

Particulars of fiddle, funnel and ventilator coamings, engine room skylight and other openings in machinery casing tops and their means of closing:—

Casing top, funnel, ventilator coamings and skylights of steel; efficiently constructed; skylight fitted with hinged steel flaps.

Particulars of Flush Bunker Scuttles:—

none

Particulars of Companionways:—

Leading to	Door opening	Sill	Door
a forward pumproom	1500. 700.	500	hinged steel,
2 pumproom amidships	1500. 700.	610	10.1.
1 engine room (escape)	1600. 750.	460	hinged, strong, teak
1 poop space	1450. 750.	550	

Particulars of Ventilators in exposed positions on freeboard and superstructure decks:—

Situated	dia	height and thickness.
fore	640	11 000 10x
	297	965 8 1/2 x
	640	992 10 x
pumproom (bridge deck level)	484	102 40 12 1/2 x
Poop deck	145	915 7 x
	453	11 240 12 1/2 x

* filled with wooden plugs and canvas covers
* filled with rain caps.

Ventilator coamings over 920 mm in height efficiently stayed or bracketed.

Particulars of Air Pipes in exposed positions on freeboard, raised quarter, or superstructure decks:—

Air pipes 460 mm high on poop deck and fore deck
" 920 " " " main deck.

foose-neck type air pipes fitted with wooden plug (chain attachment)

Air pipes over fuel tanks fitted with canvas covers



Particulars of Gangway Cargo and Coaling Ports:—

none

Particulars of Scuppers and Sanitary Discharge Pipes:—

Scuppers in wells: strong steel bends through ships sides
Sanitary discharges from spaces on bridge deck and poop deck: automatic non-return valves.

Sanitary discharges from poop space: 2 automatic non-return valves; one fitted to shell

Casings enclosing the valves of funnels

Particulars of Side Scuttles:—


Of substantial construction; bronze frame; fitted with efficient hinged deadlights, made of bronze where situated below freeboard deck and of cast iron in way of superstructures.

Vertical distance of Sill of lowest Side Scuttle above top of keel 10150

Particulars of Guard Rails:—

On fore deck, wells, after part of poop deck
height 1100; 3 rails; stanchions 1300 apart; efficient.
By construction

Particulars of Gangways, Lifelines, etc:—

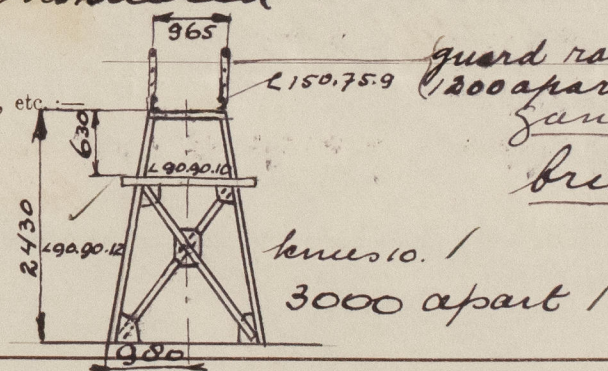

Particulars of Freeing Arrangements.

	Length of Bulwark	Height of Bulwark	Size of Freeing Ports	Number each side	Area each side	Rule area each side
After Well ...						
Forward Well ...						

State position of each freeing port ... (After Well:—
(F. and A. position and height above deck edge) (Forward Well:—

sheer stroke edge above deck
edge 300 mm

State whether the freeing ports are fitted with shutters, bars, or rails, and give particulars of such:—

Additional area where sheer is less than standard.

PARTICULARS OF PROTECTION TO OPENINGS, ETC.

HATCHWAYS ON FREEBOARD AND SUPERSTRUCTURE DECKS.									
Description of Hatchway	over dry cargo hold	over cargo tanks				
Dimensions of Hatchway	6200.4180	315x675				
COAMINGS	{	Height above Deck	...	460	915				
		Thickness	Sides	11	10				
			Ends	11	10				
		Stiffeners	180.90.11	-			
		Brackets, Stays	...	300.16	-				
HATCH BEAMS	{	Number	...						
		Spacing	...						
		Scantling and Sketch	...	none	none				
		Bearing Surface	...						
FORE AND AFTERS	{	Number	...						
		Spacing	...						
		Unsupported Lengths	...	none	none				
		Scantling* and Sketch	...						
		Bearing Surface	...						
HATCH COVERS	{	Material	...	steel *	steel				
		Thickness	...	1 1/2	1 1/2				
		How fitted	...	hinged	hinged				
		Bearing Surface	...						
Spacing of Cleats	407 (loggles)	365 (loggles)				
Number of Tarpaulins						
*Are wood fore and afters steel shod at all bearing surfaces? * stiffened by L130.50.12									
Are battens and wedges efficient and in good condition? 3 bars longitudinal									
Are tarpaulins in good condition and in accordance with rule requirements? 9 " transverse									
Are lashings provided in accordance with rule requirements?									

Particulars of any special features :—


small hatchways.

marked	opening	coaming	cover
d	1000.1000	230.10	} steel hinged w.s. closed with loggles.
e	770.600	230.10	
f	800.520	230.9	
g	1000.1000	610.10	

Skylight over pumproom efficiently constructed and fitted with hinged steel flaps.

Endorsement at first survey and at surveys for renewal of Certificate :—

The fittings and appliances are in accordance with the particulars shown on this form (or as now modified) and are in good condition.

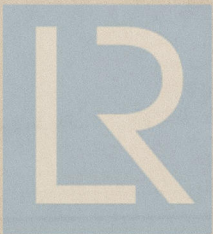

© 2021

Lloyd's Register Foundation