



LOCKING AFTER.

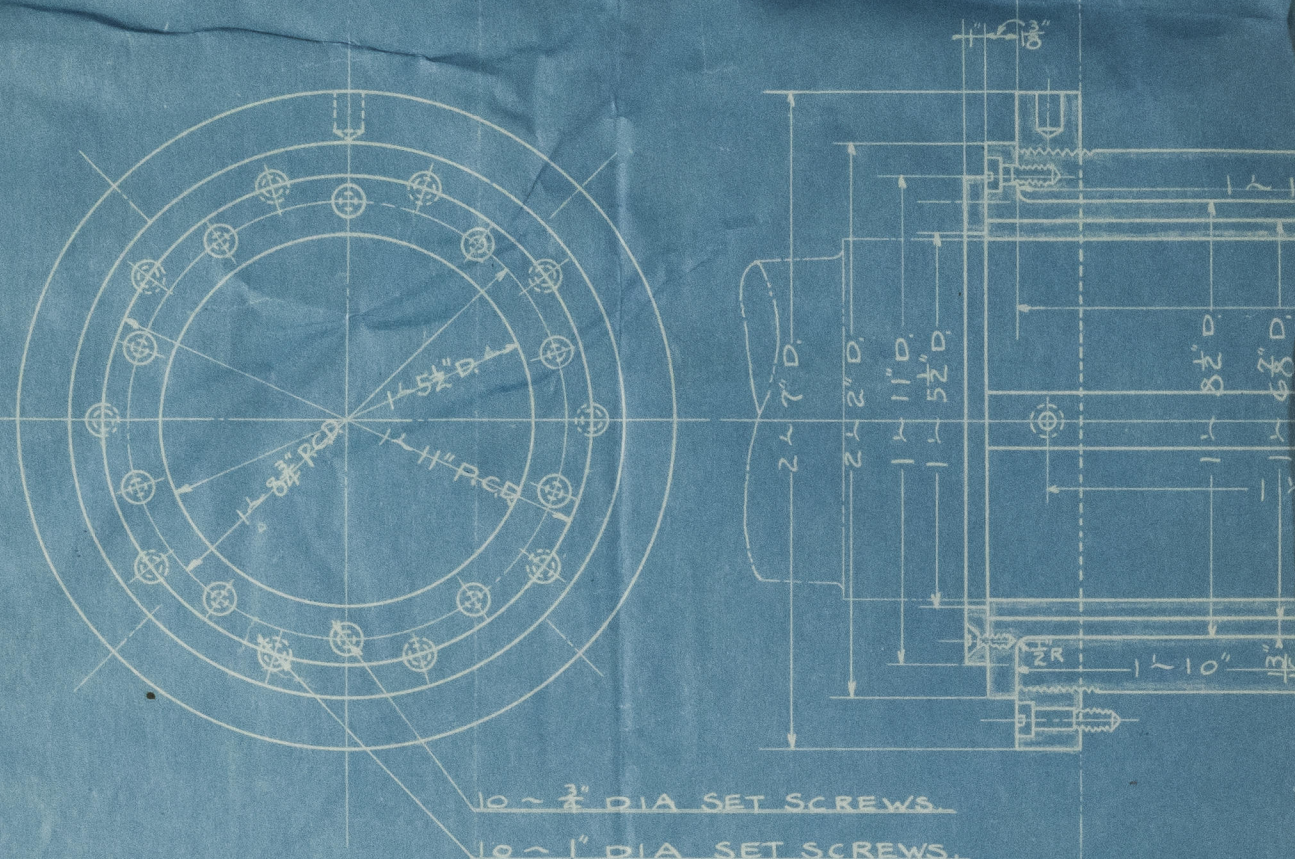

10 ~ 3/8\" DIA SET SCREWS.
10 ~ 1\" DIA SET SCREWS.

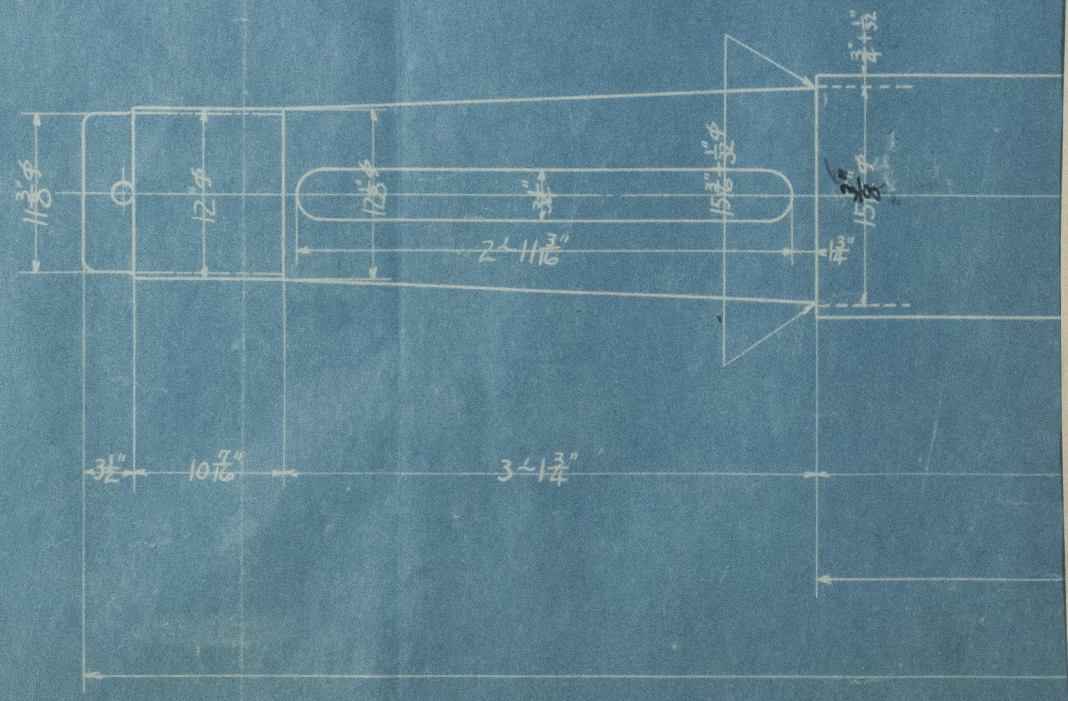

5/8\" ITALY MARU
ALTERATION
OF
TAIL SHAFT
AND
STERN TUBE

Kob. 11554

To Land

010526 - 010536 - 0013

