

LLOYD'S REGISTER OF SHIPPING

UNITED WITH THE BRITISH CORPORATION REGISTER

Ship's Name M.V. MELTEM II.Official No. -


Memorandum of alterations reported since ship was surveyed for assignment of Load Lines in Alterations

converting forward hold for carriage of Aviation Spirit or Petroleum in Bulk.

(1) Existing hold hatch cover removed and opening efficiently plated-over, access openings (1P & 1S) cut in and efficient oil tight hatch covers fitted as per existing main cargo oil tank covers.

(2) Air pipe fitted from each tank leading to a combined outlet pipe above hatch


(3) After pump room casing removed and opening efficiently plated-over gauges incorporated on air pipes and bannes covers supplied.

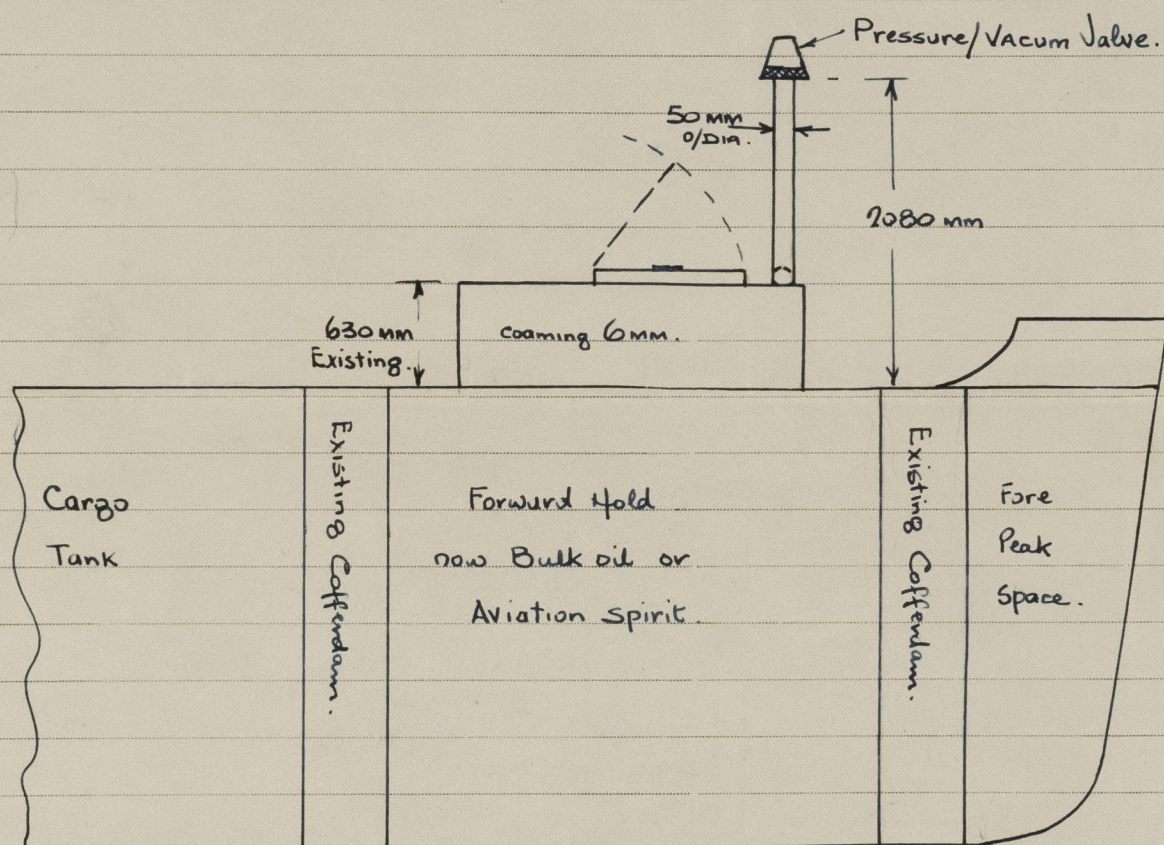

Hatch opening (1P & 1S) 600 x 600 x 50 mm high coaming.

Cover and coaming 6mm Thick, toggles spaced 140mm from ends

Packing on underside of cover of the greasy hemp type.

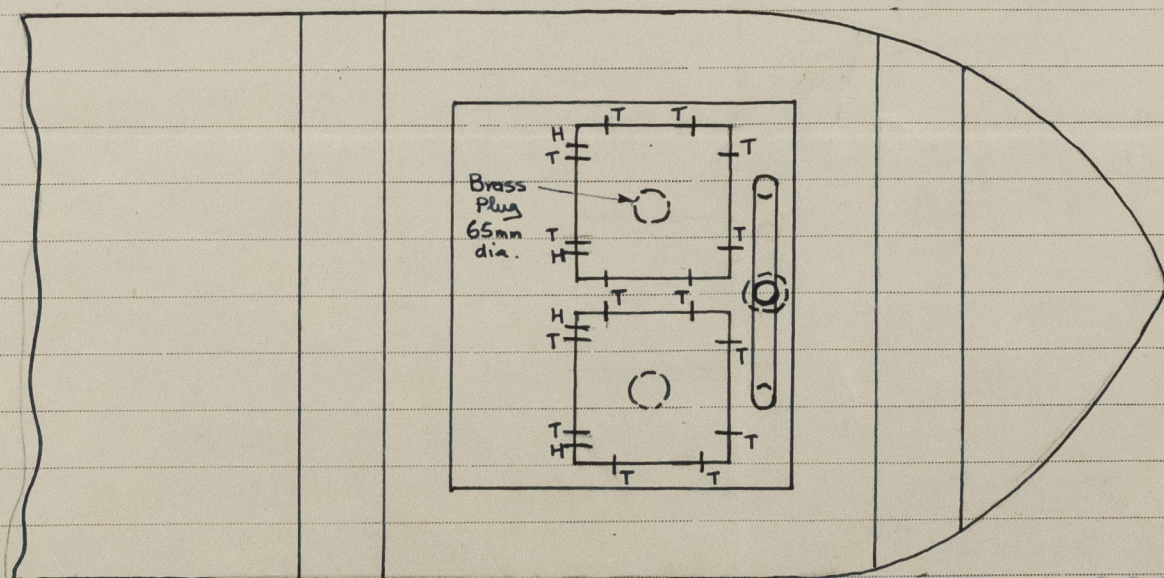

A. copy of this report has been placed onboard