L7818.

L7818.

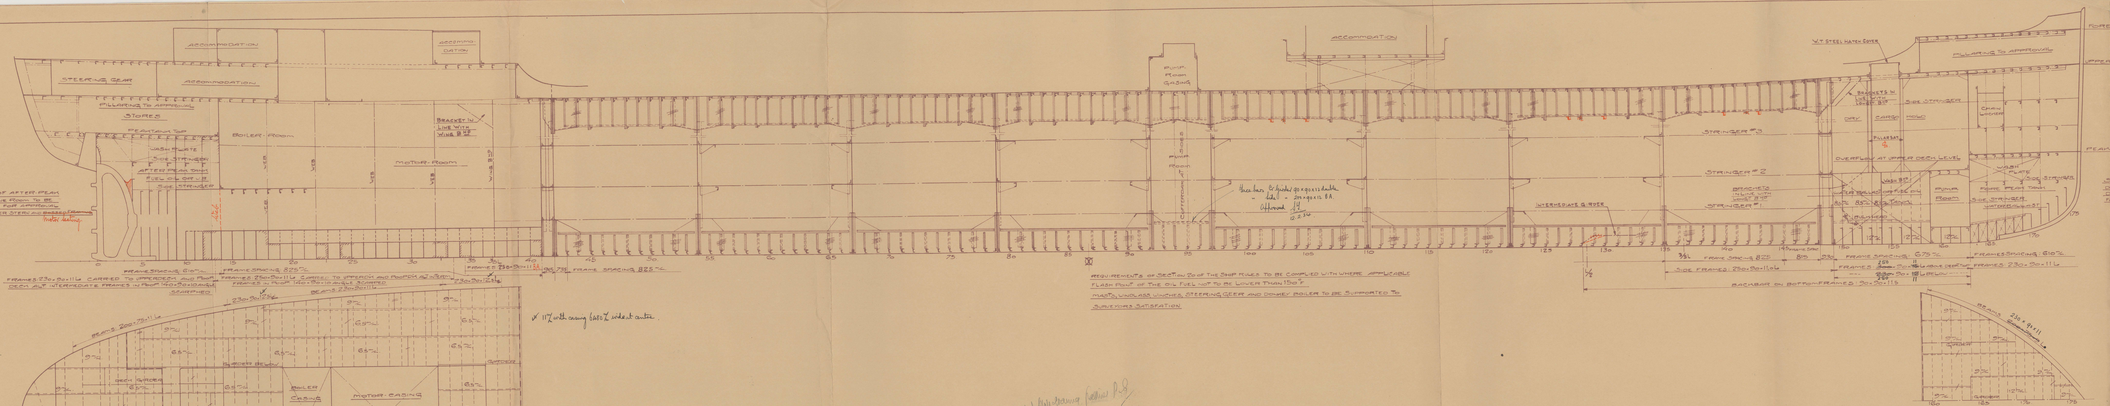

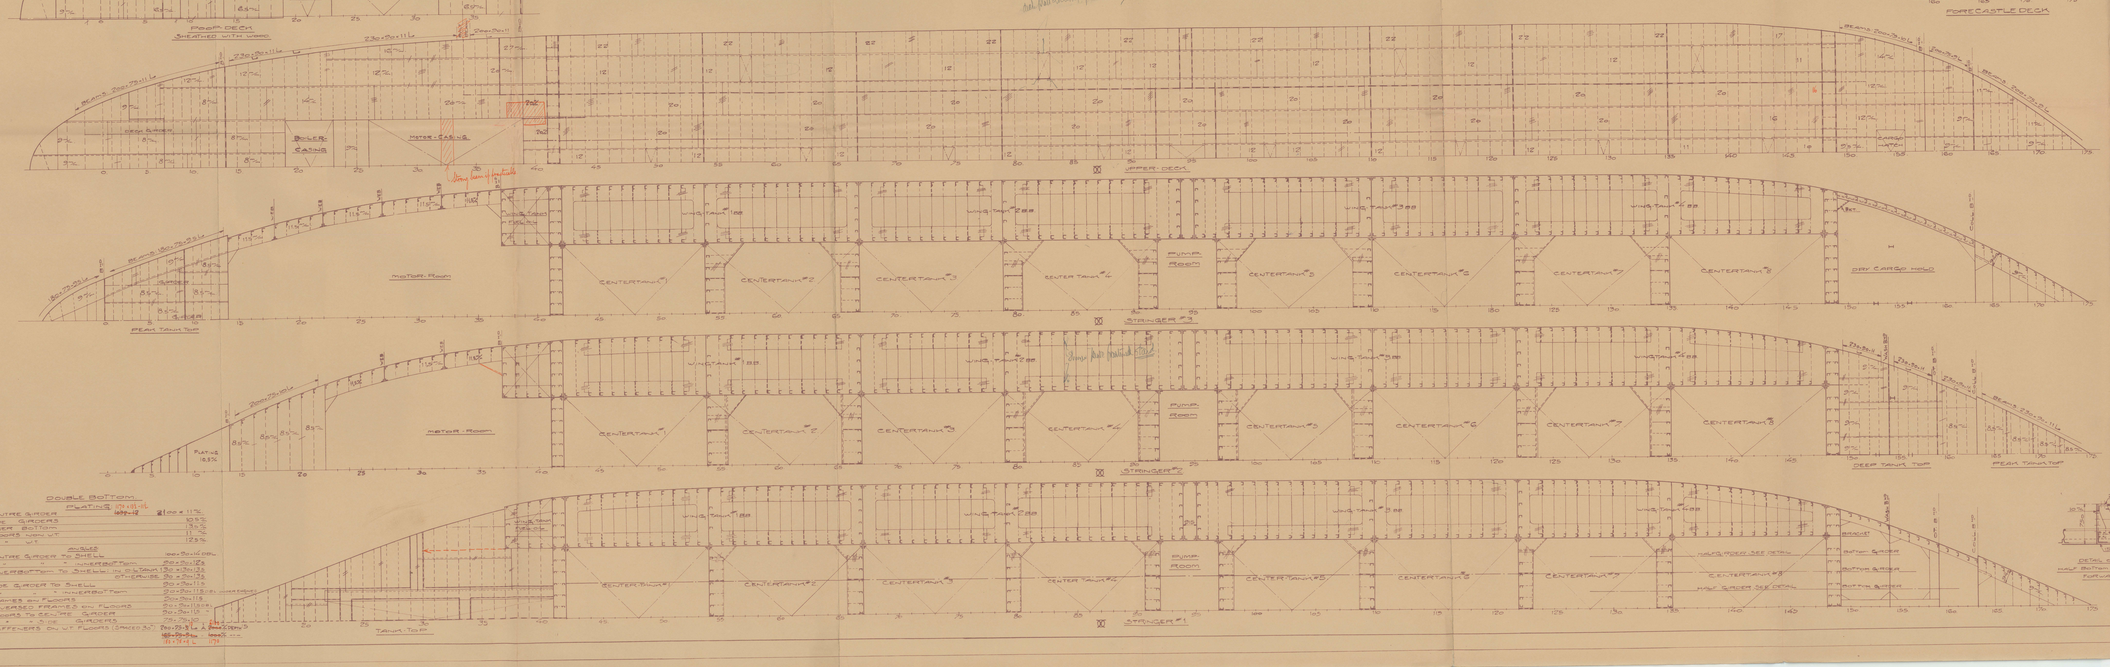
DOUBLE BOTTOM
CENTRE GIRDER PLATING
SIDE GIRDERS
FLOORS BOTTOM
FLOORS WING VT
ANGLES
CENTRE GIRDER TO SHELL
" " INNERBOTTOM
INNERBOTTOM TO SHELL IN DEEP TANK
OTHERWISE
SIDE GIRDER TO SHELL
" " INNERBOTTOM
FRAMES on FLOORS
REVERSED FRAMES on FLOORS
FLOORS TO CENTRE GIRDER
" " SIDE GIRDERS
STIFFENERS on VT FLOORS (SPACED)
SIDE FRAMES
FRAMES SPACING
FRAMES SPACING
FRAMES SPACING
FRAMES SPACING
FRAME SPACING
FRAME SPACING
FRAME