

PACKED CARGO
SINGLE SCREW MOTOR VESSEL
MIDSHIP SECTION.
CLASS LLOYDS 100 A1.7, FULL SCANTLING VESSEL

N.V. WERF GUSTO
FIRMA A.F. SMULDERS
SCHIEDAM HOLLAND
SMITH'S DOCK CO. LTD
RIVERTEES DOCKYARD
SOUTH BANK ON TEES
YARD N° 726.
YARD N° 1054.

DIMENSIONS.

LENGTH 305'-0"
BREADTH 41'-9"
DEPTH TO UPPERDECK 25'-0"
" " SECOND DECK 18'-0"


NUMERALS.

D 25,00
L x D 305 x 25 = 7625,00
L x (B + D) 305 x (41,75 + 25,0) = 20358,75
L/D 305/25 = 12,20
d 14,00

PERCENTAGE COVERED BY ERECTION
EQUIPMENT TO RULE & OWNERS REQUIREMENTS.

EQUIVALENT PROFILES.

4 1/2" x 2 1/2" x 33	4 65 x 65 x 8
4 3" x 3" x 30	4 75 x 75 x 7
4 5" x 5" x 44	4 130 x 130 x 11
4 6" x 6" x 44	4 150 x 150 x 11
4 4" x 3" x 38	4 100 x 75 x 9
4 5" x 3" x 40	4 130 x 75 x 10
4 6" x 3" x 30	4 150 x 75 x 7
4 6" x 3/2" x 48	4 150 x 90 x 12
4 5/2" x 3" x 38	4 140 x 65 x 9
4 6" x 3" x 34	4 150 x 75 x 8
4 7" x 3" x 40	4 180 x 75 x 10
4 8" x 3" x 42	4 200 x 75 x 10
4 8" x 3/2" x 42	4 200 x 90 x 10
4 9" x 3/2" x 40	4 230 x 90 x 10
4 6" x 4" x 50	4 180 x 90 x 14
4 6" x 6" x 50	4 160 x 160 x 15

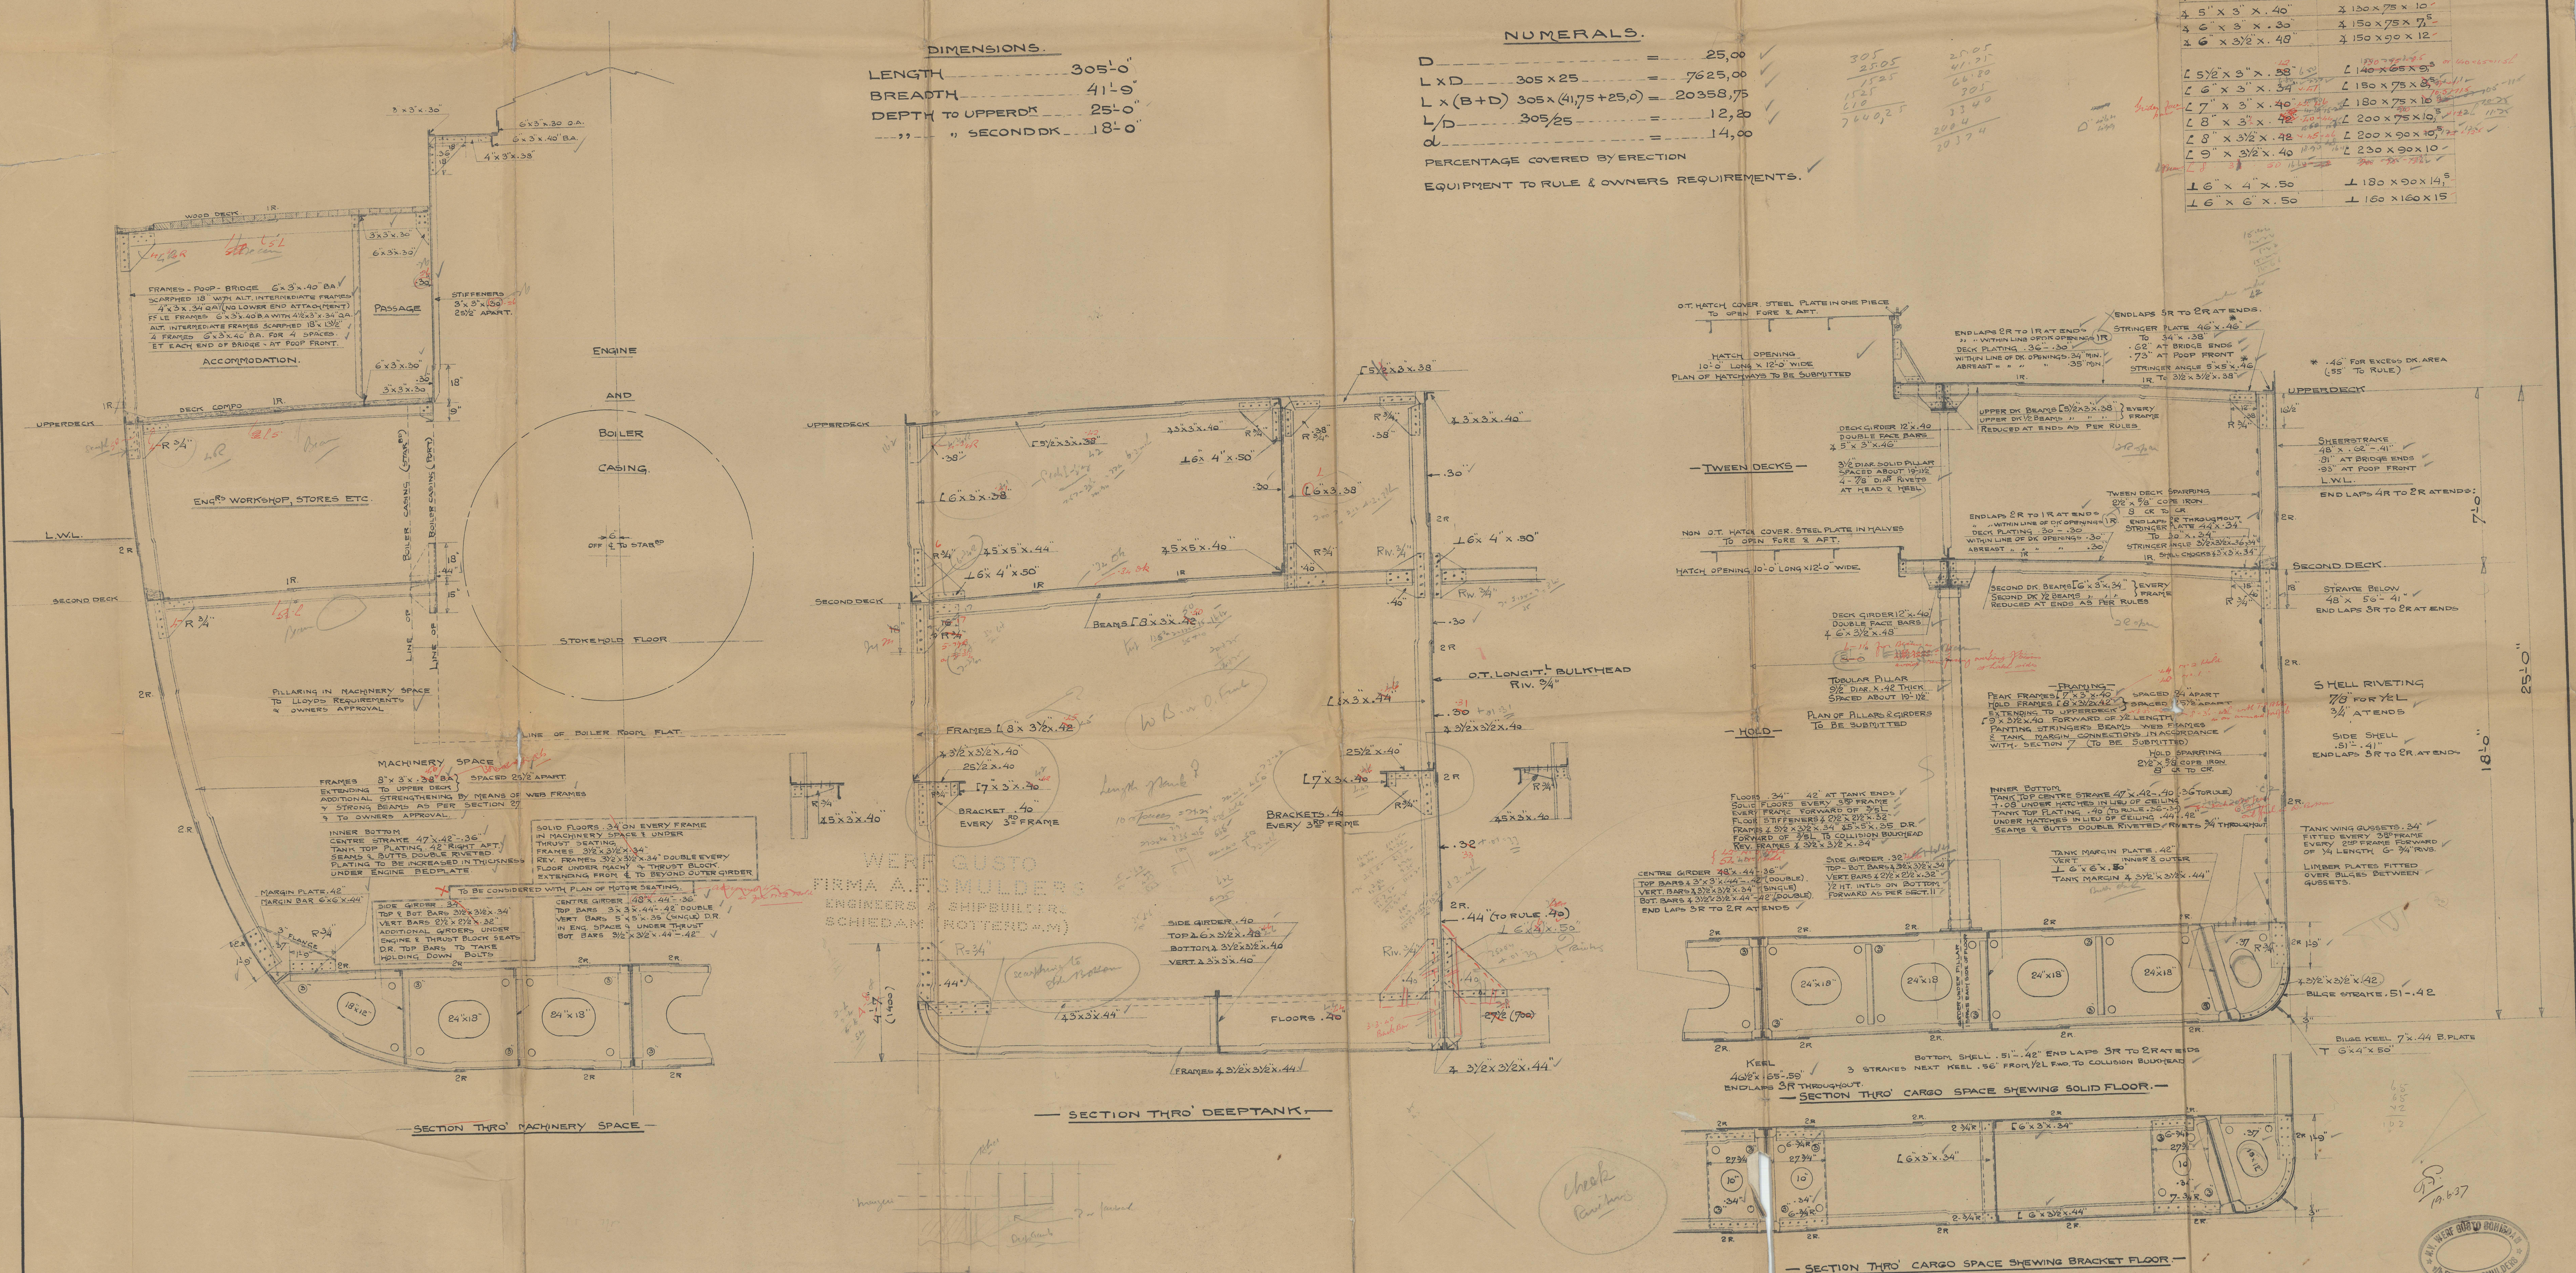

N° 35287.

WATER

"Crista"

Wend Gorko 726
Smiths' Dock 1084

of section

(2)

M/S

010580-010580-0081



© 2021

Lloyd's Register
Foundation