

SECTION B-B

SECTION C-C

N.V. "WERF GUSTO"
H. FIRMA F.A. SMULDERS
SCHIEDAM - HOLLAND.

SMITH'S DOCK CO LTD
YARD No 1054.

Transf. 40.
Steel 57.
Ranch 40. 251.
6 x 92 = 552.
4.9" 762.
6.52.

12 Pairs in Stemframe to be 1"

THIS HOLE ACCORDING TO
RUDDER CARRIER.




FILLED FLUSH WITH CEMENT.

CYLINDRICAL RUDDERPOST
MAT. FORGED-IRON.

RUDDER AREA
110 sq ft. 10.21 m².

PROPELLOR 3600.
DIAM. OF PROPELLOR SHAFT
300 1/2"

FINISHED DIAM.
ROUGH BORED.

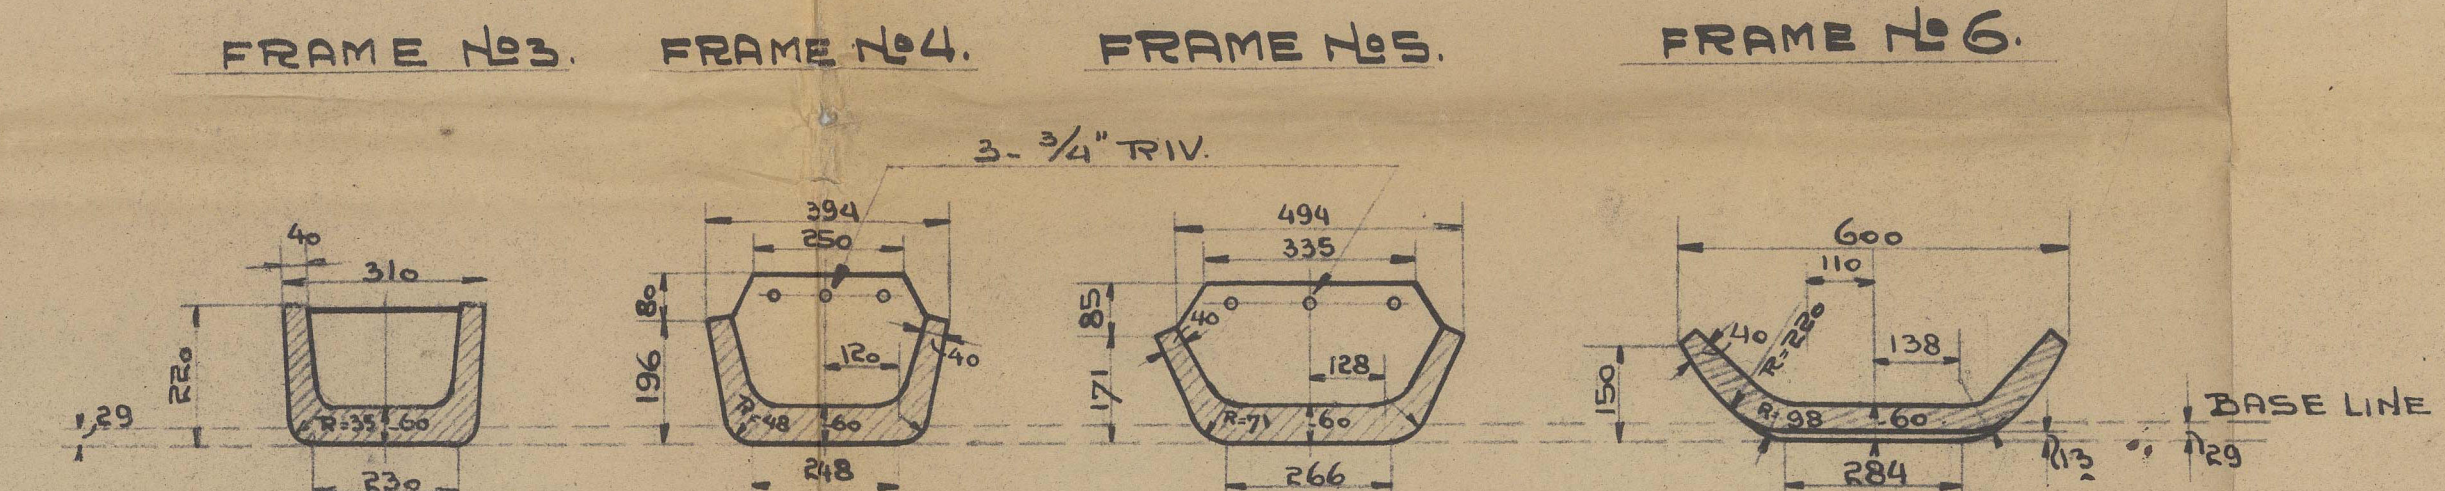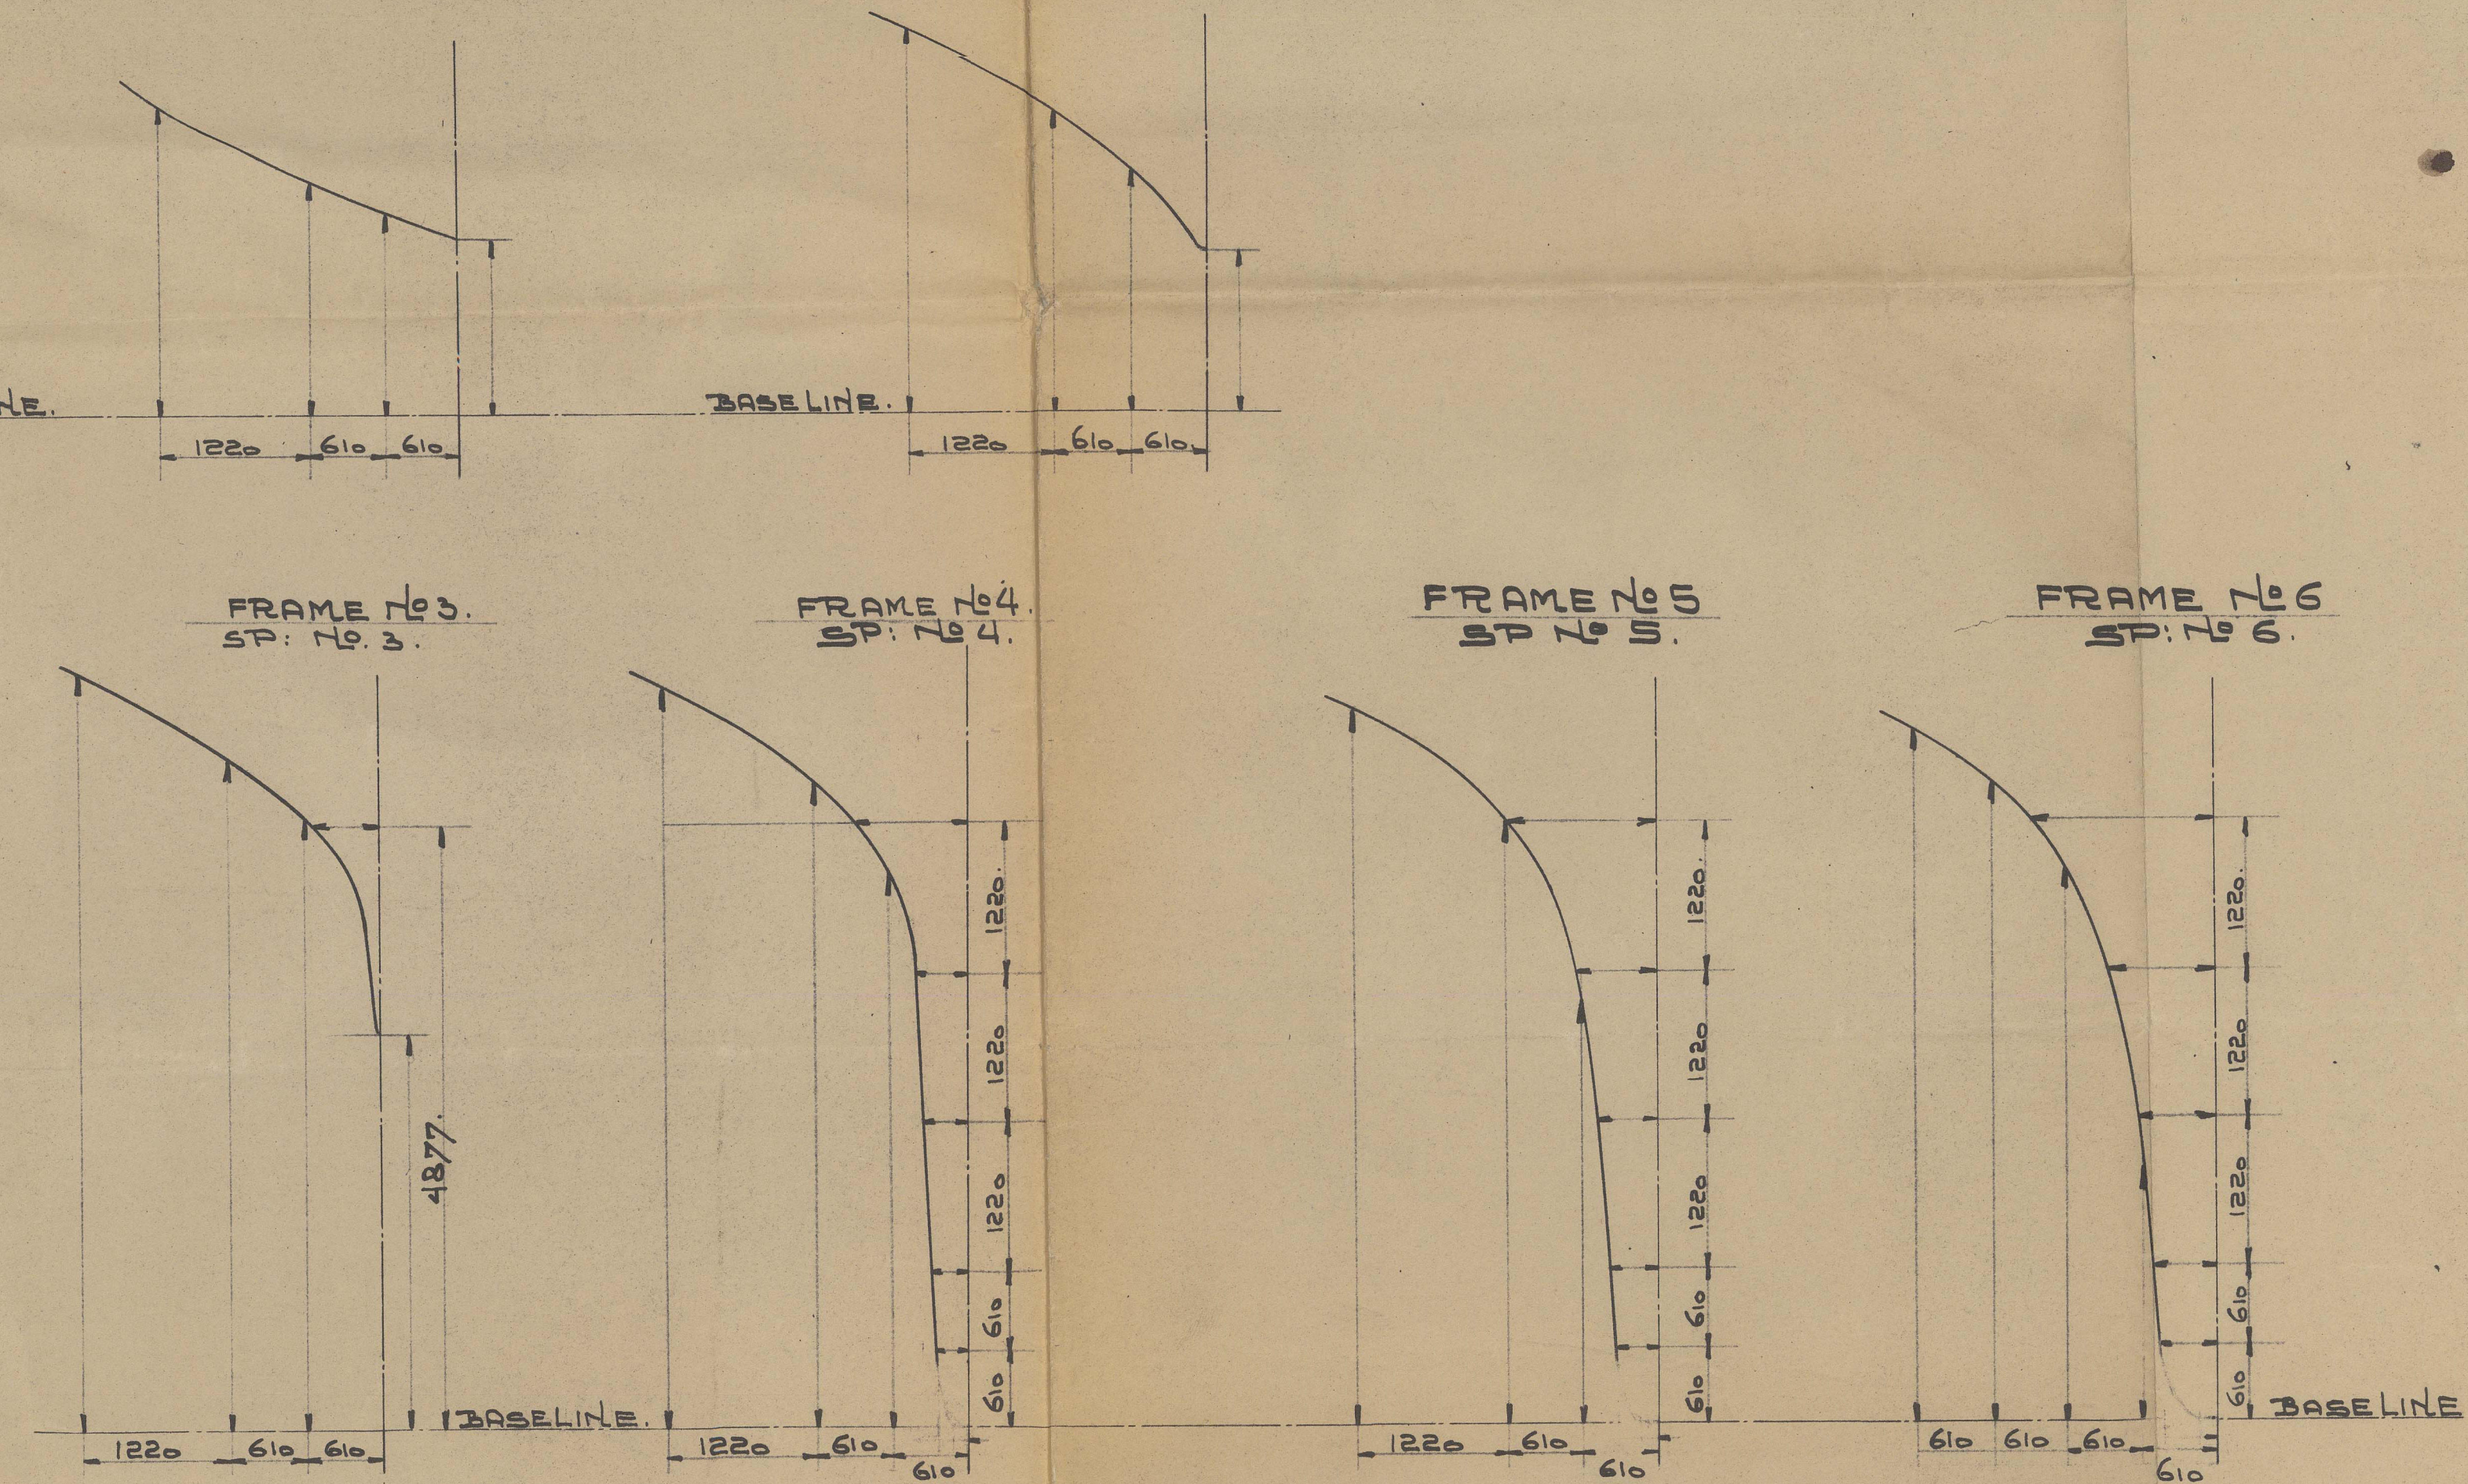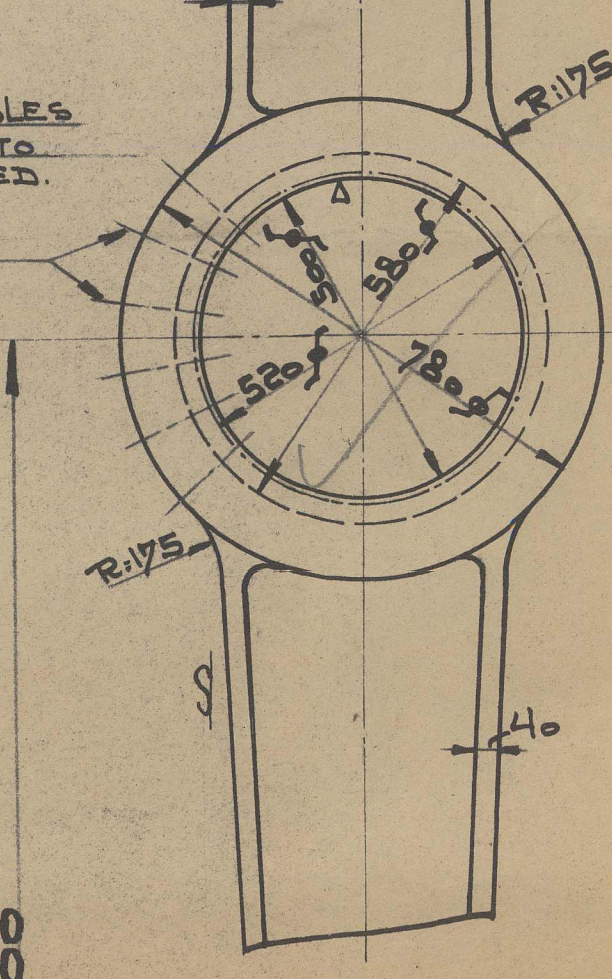

WITH ENG. HLOUD'S CERTIFICATE.

STERN FRAME.

SCALE 1"=0' 1" AND 1/4"=1'-0."

No 35297.

VLAK GEGOTEN, OF GESMEED.
RUW, NIEVE VOEL-EN ZICHTBAAR.
ZUVERGLAD, NIEVE NIET ZICHTBAAR.



WERF "GUSTO" 726.
SMITH'S DOCK CO. 1054

STERN FRAME



© 2021

Lloyd's Register
Foundation