


AUG 28 1939

Index No.

Lloyd's Register of Shipping. F. 197 (SNG.)Ship's Name "M. V. CRISTA"Official No. 166611.

Memorandum of alterations reported since ship was surveyed for assignment of Load Lines in _____

The poop front bulkhead has been altered as indicated below:—

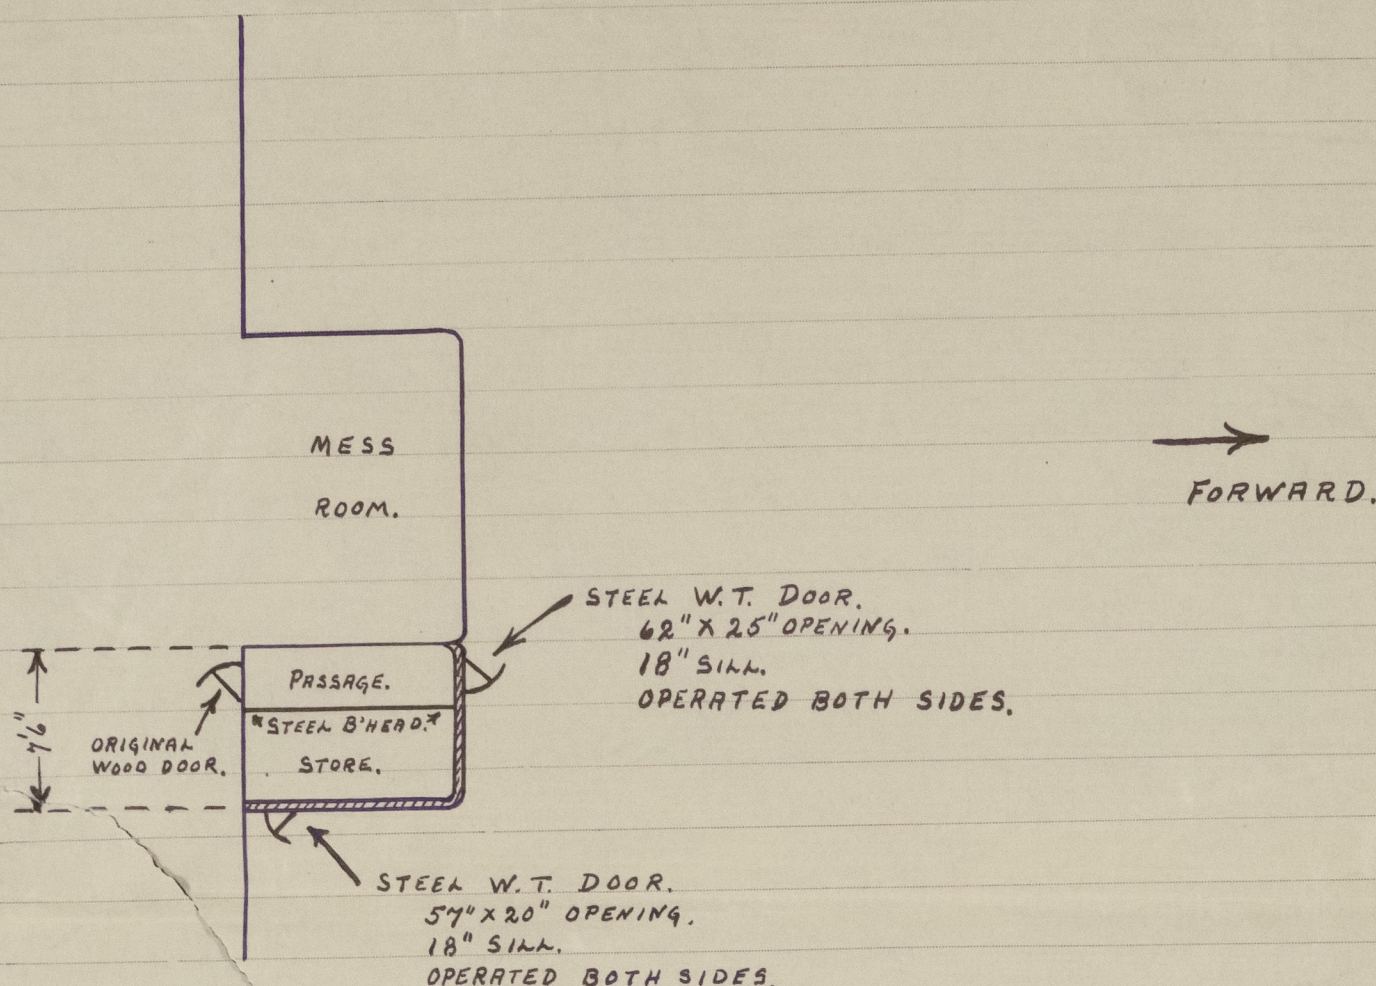

The addition is indicated in double lines with hatched lines. The new plating is $\frac{1}{20}$ " thicker than the original poop front plating, the additional stiffener in the store is of the same scantlings as other poop front stiffeners.

(A copy of this memorandum has been placed on board the ship because the photostatic copy of the original freeboard report was not available.)

John Wormald.
Singapore.
3/8/39.

S.F.B.
29.8.39