


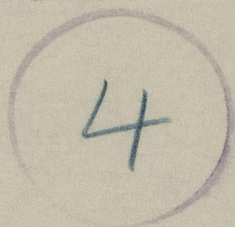




RECORDS DEPT.  
LONDON



SEIHO MARU 

MIDSHIP SECTION


AS APPROVED



MODIFIED AS BUILT

TO LLOYD'S REGISTER OF SHIPPING

FOR APPROVAL

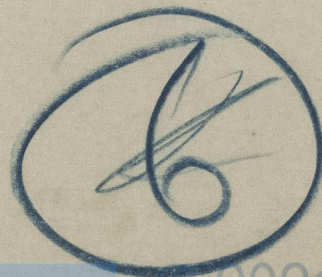

© 2021

Lloyd's Register  
Foundation

JAN 27 1951



109

22

225

21

335

225

555

6

4, 025

11

625

91

102

090



© 2021

Lloyd's Register  
Foundation