


# — RIVETING —

BUTTS OF SHELL PLATING TO BE LAPPED AND  
DOUBLE RIVETED EXCEPT GARBOARD AND SHEERSTRAKE  
WHICH ARE TO BE STRAPPED AND DOUBLE RIVETED  
ALL LANDINGS DOUBLE RIVETED  
BULWARK SINGLE RIVETED

To class  $\star$  100 A.I. STEAM TRAWLER

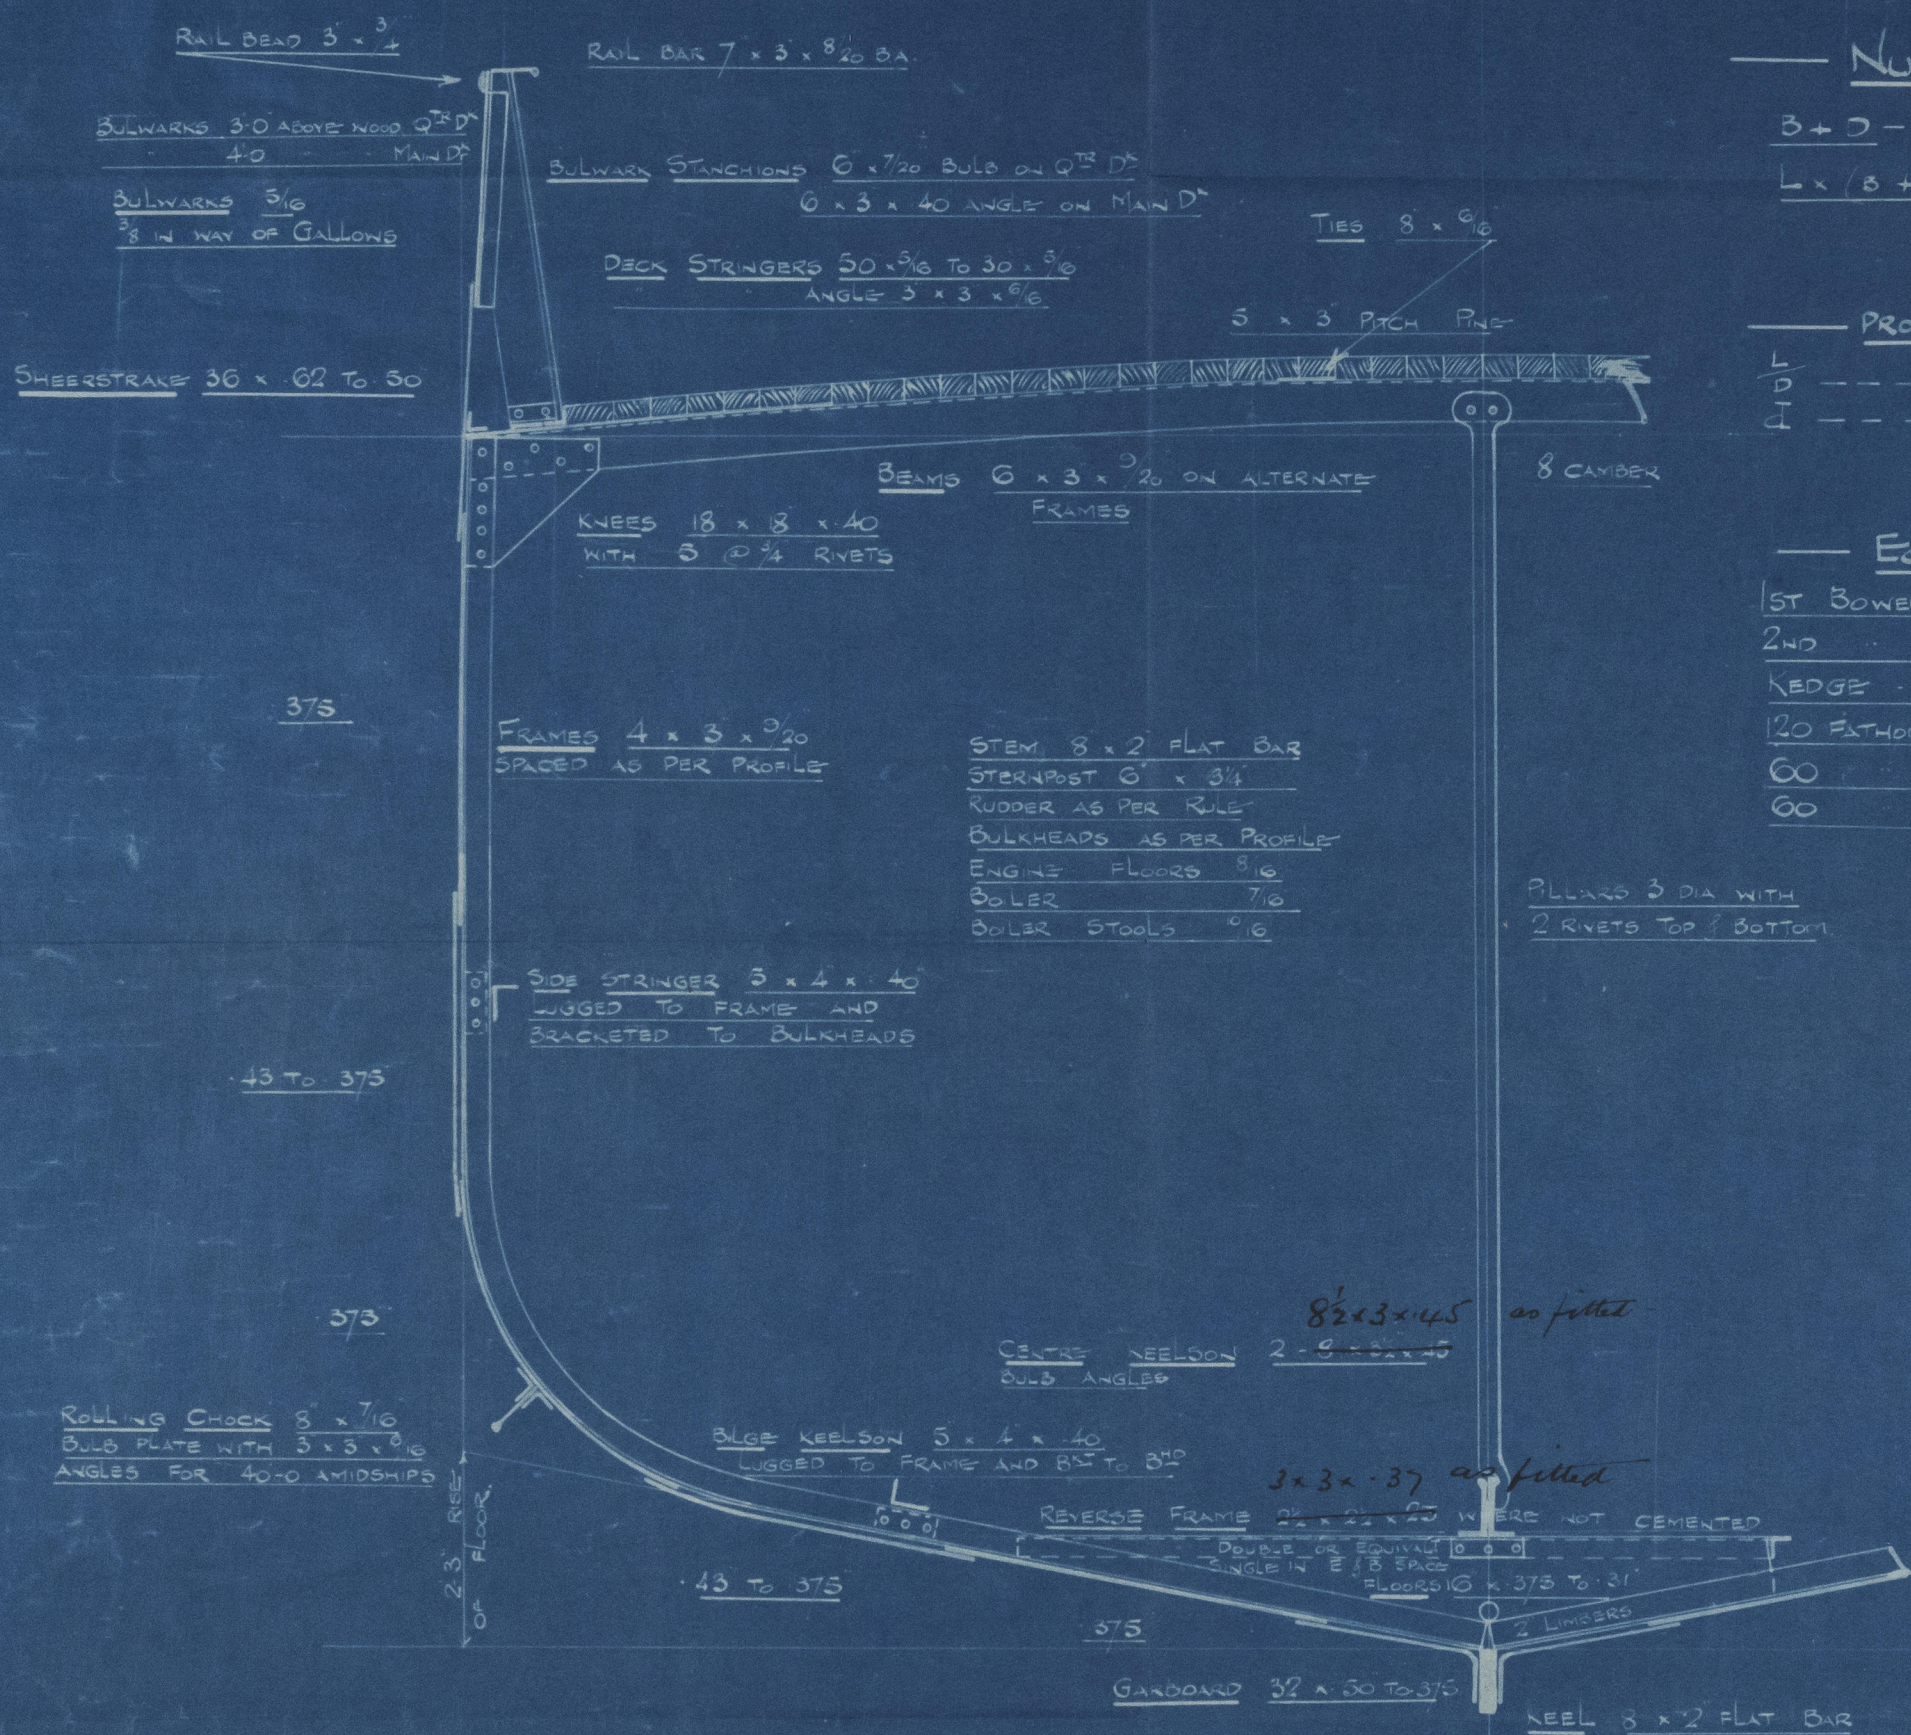

## — NUMERALS —

B + D ----- 37.87

L x (B + D) --- 5301.80

## — PROPORTIONS —

L/D ----- 10.00

L ----- 12.67

## — EQUIPMENT —

1ST BOWER ANCHOR  $8 \frac{1}{2}$  CWTs STOCKLESS

2ND " 7'2

KEDGE "  $3 \frac{1}{4}$  Ex STOCK

120 FATHOMS  $1 \frac{1}{6}$  STUD LINK CABLE

60 " 6 HAWSER

60 " 3 WARP

PLATES 3 DIA WITH  
2 RIVETS TOP & BOTTOM

## MIDSHIP SECTION

No 984

STEEL SCREW TRAWLER

DIMNS :- 140'-0" BP x 23'-10 1/2" MLD x 14'-0" MLD

1/2" SCALE.

PLAN No. 5244

FOR ENCLOSURE TO

Messrs The Surveyors  
Lloyd's Hull FROM

COCHRANE & SONS, LTD.

SHIPBUILDERS, SELBY.

DATE 18/5/20



Lloyd's Register  
Foundation



994 Ship.

Cochranes Sons Ltd.

Selly.

Midship Section.

"Foam Flower"

Bull F. E. Report No 34144



© 2021

Lloyd's Register  
Foundation

010589-010604-0068