

# Lloyd's Register of Shipping.


## SURVEYS FOR FREEBOARD.

### (CONDITIONS OF ASSIGNMENT.)

 Index No. 39245  
 (For London Office only.)

Ship's Name M/T "GAUTHIOD" Port of Survey Malmö.  
 Official Number 1 Surveyor's Signature A. Barring  
 Nationality and Port of Registry Swedish, Stockholm. Date of Survey Whilst building.

Disposition and dimensions of superstructures, trunks, deckhouses and machinery casings to be inserted in the diagrams and tabular statement:—

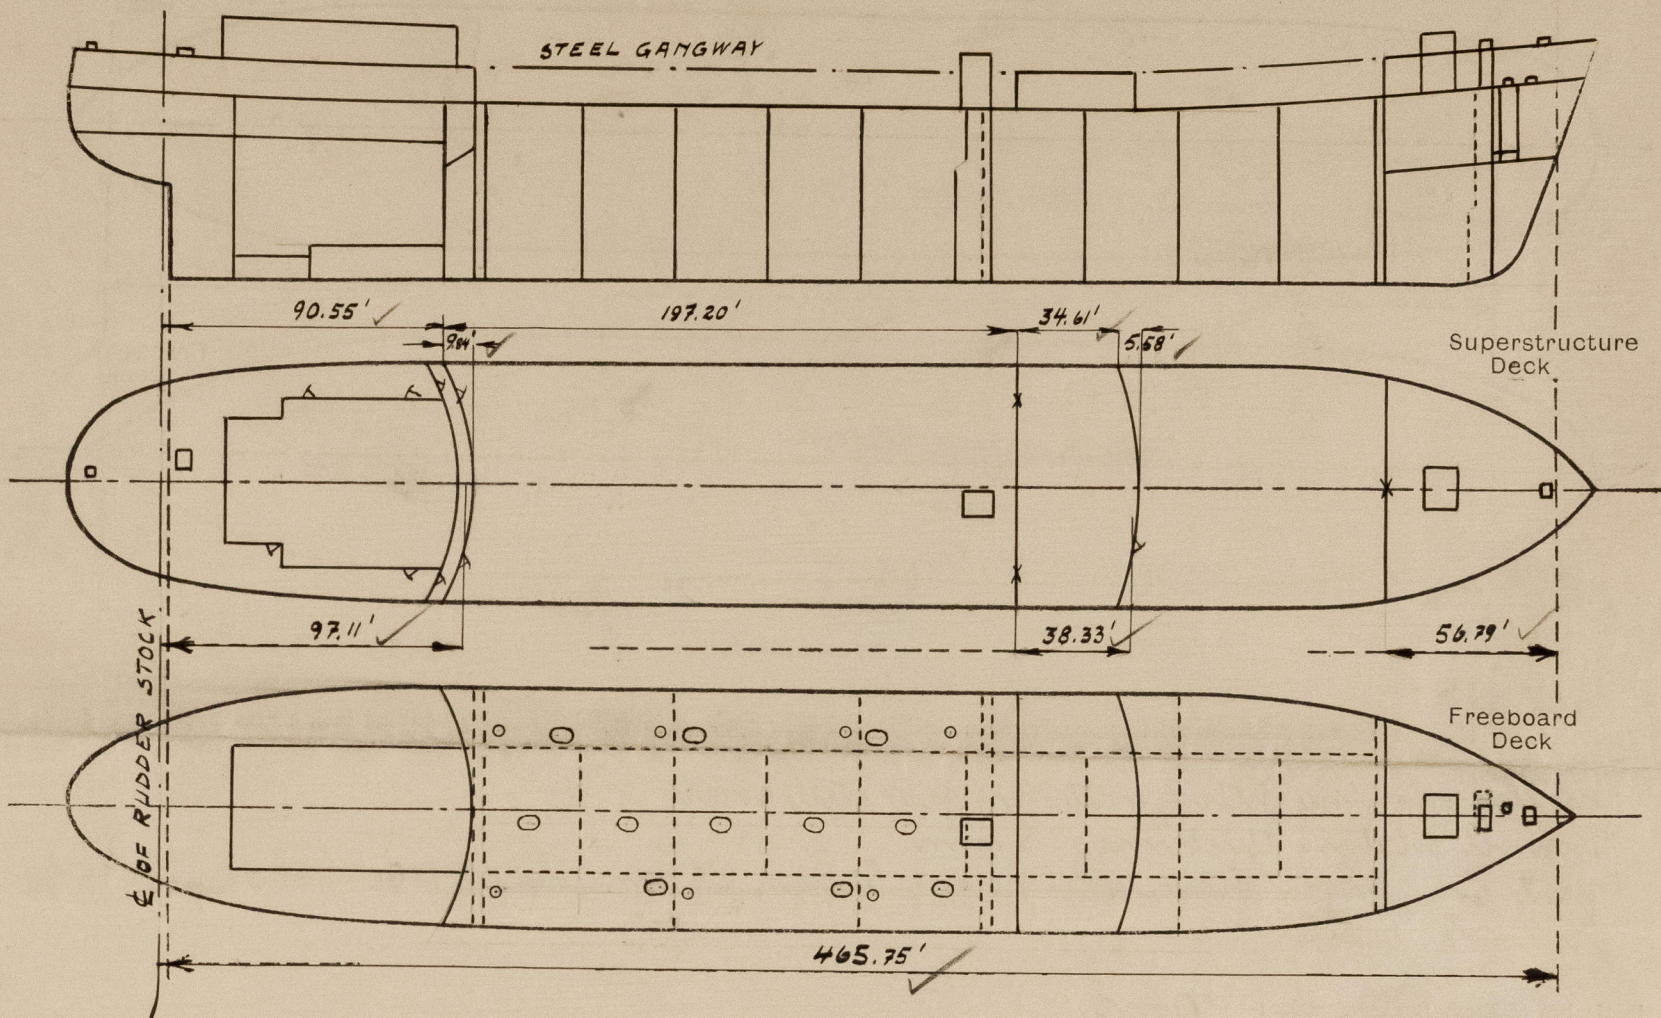

Particulars of Superstructures, Trunks, Casings, Deckhouses.

	Coaming	Plating	Stiffeners	Spacing	End Attachments of Stiffeners	Size of Openings	Height of Sills	Height of Casings
Poop Bulkhead <i>Sides...</i>	<i>to W. to dle.</i>	12	230×90×12 I	755	<i>Bot. Top.</i>	1500×640	640	7.75
<del>Raised Quarter Deck</del> Bulkhead <i>Centre.</i>	<i>" "</i>	12.5	250×90×12 I	755	<i>" "</i>	None.	✓	7.75
Bridge, After Bulkhead ...	<i>" "</i>	9	80×65×10 I	855	<i>Bridge dle. long. Top.</i>	2210×935	None	7.75
Bridge, Forward Bulkhead...	<i>" "</i>	13.5	250×90×12 I	855	<i>Bridge dle. long. Top.</i>	1530×970	460	7.75
Forecastle Bulkhead...	<i>" "</i>	7.5	90×75×8 I	790	<i>Forecastle dle. long. Top.</i>	2145×1235	None	7.5
<i>Main Pump Room.</i>	<i>" "</i>	8	90×75×8 I	520-600	<i>to W. Top.</i>	1470×840	1325	9.75
Trunk, Forward ...								
Exposed Machinery Casings on Freeboard or Raised Quarter Decks...								
Exposed Machinery Casings on Superstructure Decks <i>Boat dle.</i>		7.5	90×75×8 I	760	<i>Bot. Top</i>	None.	✓	3.5
Machinery Casings within Superstructures not fitted with Class I Closing Appliances ...					<i>Cont. Bottom.</i>			
Deckhouses on Flush Deck Ships ...								


Particulars of Closing Appliances (state if capable of being manipulated from both sides).

Poop Bulkhead ...	<i>Hinged W.T. steel door, manipulated from both sides.</i>	✓
Raised Quarter Deck Bulkhead ...		
Bridge, After Bulkhead ...	<i>Portable plates with hook bolts, spaced 305 mm.</i>	✓
Bridge, Forward Bulkhead ...	<i>Hinged W.T. steel door, manipulated from both sides.</i>	✓
Forecastle Bulkhead ...	<i>Portable plates with hook bolts, spaced 305 mm.</i>	✓
Exposed Machinery Casings on Freeboard or Raised Quarter Decks ...	<i>Hinged W.T. steel door, manipulated from both sides.</i>	✓
Exposed Machinery Casings on Superstructure Decks ...		
Machinery Casings within Superstructures not fitted with Class I Closing Appliances ...		
Deckhouses on Flush Deck Ships ...		



## PARTICULARS OF PROTECTION TO OPENINGS, ETC.

The following diagrams should be used to indicate the positions of cargo and coaling hatchways, gangway, cargo and coaling ports, ventilators, companionways, etc., which would affect the seaworthiness of the ship:—

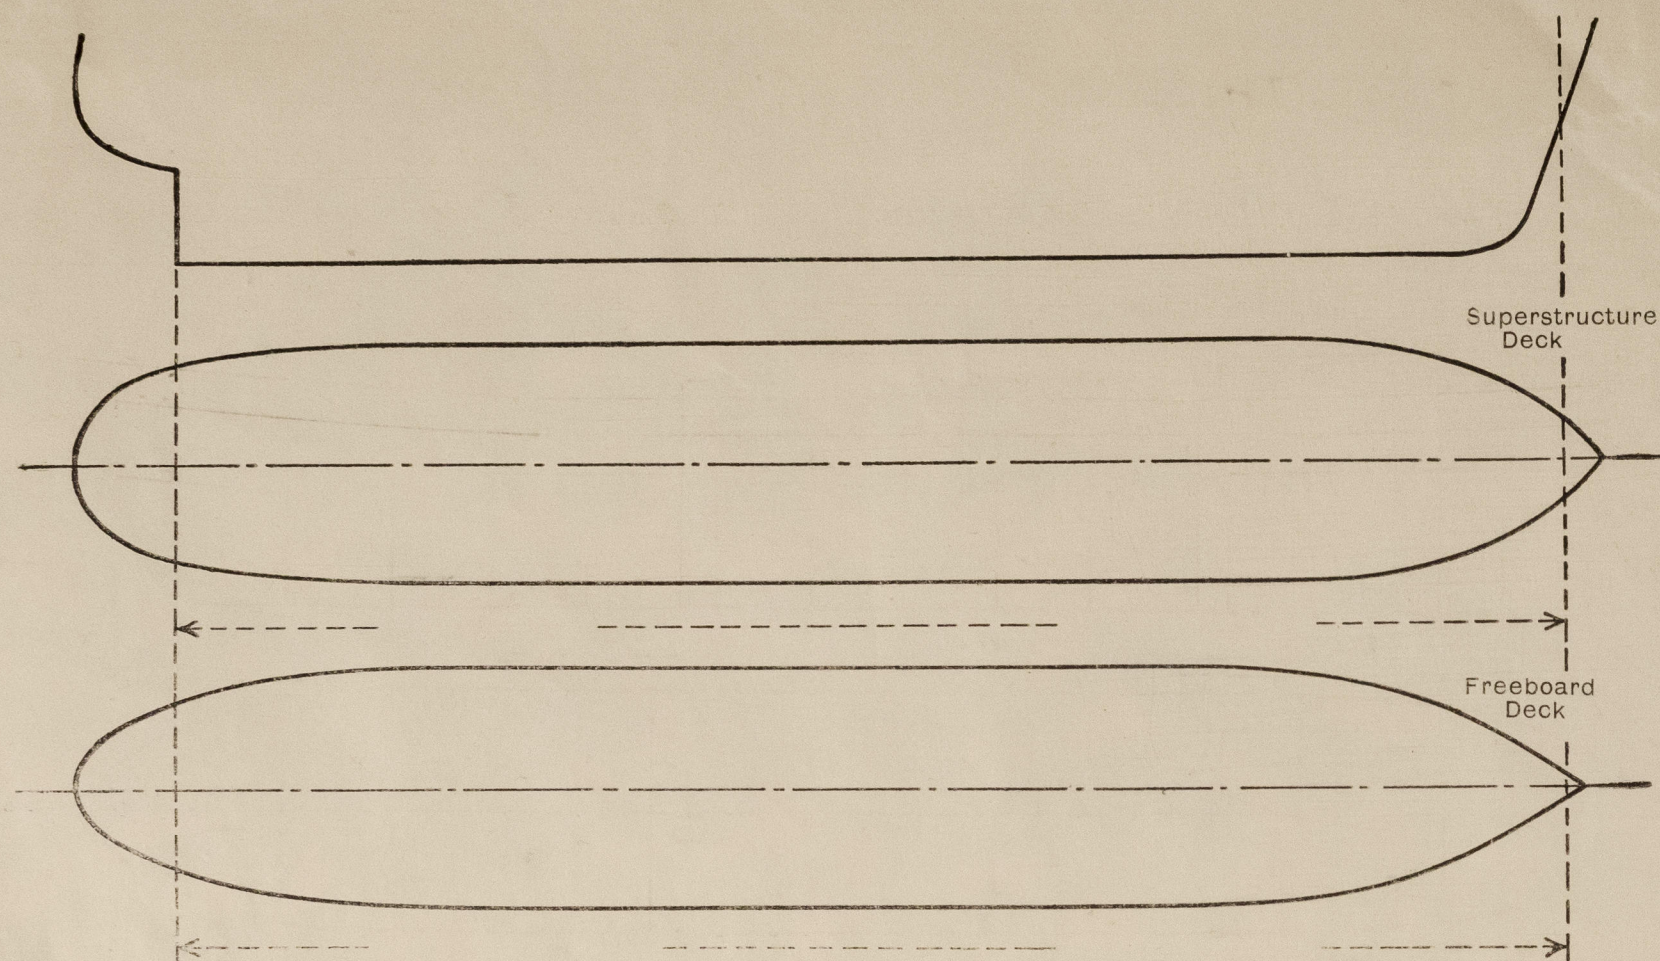

Particulars of fidley, funnel and ventilator coamings, engine room skylight and other openings in machinery casing tops and their means of closing:—

Fidley opening fitted with hinged steel cover. ✓  
 Funnel plating thickness 5 mm. ✓  
 Vent. coamings:— Diam. 600-910 mm. Thickness 6.5 mm. Height 1800-2550 mm. ✓

Particulars of Flush Bunker Scuttles:— None. ✓

Particulars of Companionways:— Poop space entrance at sides of poop deck house.

Size of openings 1535 × 650 mm. Height of rails above deck 460 mm. ✓  
 50 mm. thick solid teak doors manipulated from both sides. ✓

Eng. pump room in forecabin space:— Size of openings 1280 × 740 mm. Height of rails above deck 290 mm. ✓  
 Hinged W.T. steel door, manipulated from both sides. ✓

Particulars of Ventilators in exposed positions on freeboard and superstructure decks:—

Poop deck:— Diam. 140, 210 & 290 mm. Thickness 9 mm. Height 750 mm. ✓  
 Bridge deck:— " 290 mm. " 9 " " 750 mm. ✓  
 Side deck:— " 290 " " 8 " " 915 mm. ✓  
 Fore. deck:— Derrick posts of strong construction. ✓

The coamings are electrically welded to decks and are provided with means for closing. ✓

Particulars of Air Pipes in exposed positions on freeboard, raised quarter, or superstructure decks:—

Poop and forecabin decks:— Coamings 530-940 mm. high. ✓  
 Freeboard deck:— Coamings 1025-2300 mm. high. ✓

Provided with means for closing. ✓



© 2021

Lloyd's Register  
Foundation



Particulars of Gangway Cargo and Coaling Ports :—

None.

M/T. Gauthiod.

Particulars of Scuppers and Sanitary Discharge Pipes :—

No scuppers below freeboard deck.

Sanitary discharge pipes from poop deck house and from poop space are led overboard about 300 mm. above 2nd deck (accessible in motor space) and those from bridge deck house led overboard above freeboard deck. All discharge pipes are fitted with storm valves and drain pipes from the poop space also provided with non-detachable screw plugs at their inner ends.

Particulars of Side Scuttles :—

All side scuttles are of strong construction and fitted with hinged deadlights.

Vertical distance of Sill of lowest Side Scuttle above top of keel


About 39'.

Particulars of Guard Rails :—

Bulwarks at fore part of fore well on bridge deck and on fore part of poop deck 1100 mm. in height. Open rail elsewhere, 1060 mm. in height. Bulwarks & open rail are substantially constructed.

Particulars of Gangways, Lifelines, etc. :—

Gangway between poop, bridge & fore. as per sketch.

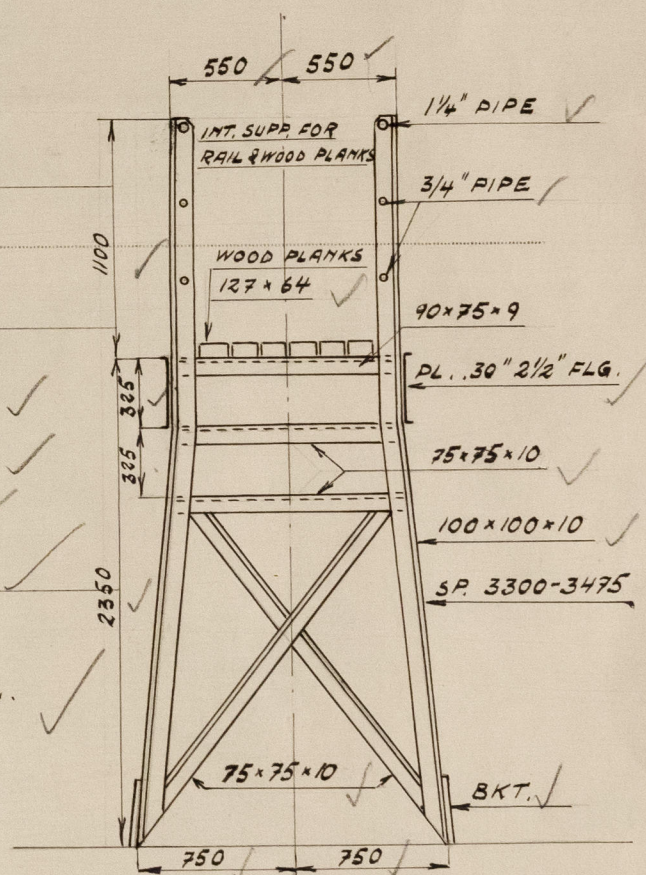

Particulars of Freeing Arrangements.

	Length of Bulwark	Height of Bulwark	Size of Freeing Ports	Number each side	Area each side	Rule area each side
After Well						
Fore part of Forward Well	10500	1100		2 pairs.	60 dm <sup>2</sup> .	

State position of each freeing port ... { After Well :—

(F. and A. position and height above deck edge)

Forward Well :— From fore. 4300 & 7400 mm. Height above dk. edge 110 mm.

State whether the freeing ports are fitted with shutters, bars, or rails, and give particulars of such :—

Additional area where sheer is less than standard.



© 2021

Lloyd's Register  
Foundation

203 2/2



# PARTICULARS OF PROTECTION TO OPENINGS, ETC.

HATCHWAYS ON FREEBOARD AND SUPERSTRUCTURE DECKS.										
Description of Hatchway ... ..		Inboard deck			Chain locker & FP.	Poop deck		Forecastle deck		
		Cargo	OFB & V hatch	Mammoth		Stons.	Hold.	Forecastle	Ind. framing room.	
Dimensions of Hatchway ... ..		1810 x 1050	680	400 x 460	815 x 650	1200 x 1200	1200 x 740	3425 x 3400	1170 x 860	620 x 520
COAMINGS	Height above Deck ...	830 ✓	230 ✓	110 ✓	230 ✓	320 ✓	160 ✓	830 ✓	380 ✓	460 ✓
	Thickness { Sides and Ends ...	10 ✓	10 ✓	10 ✓	7.5 ✓	11 ✓	10.5 ✓	11 ✓	7.5 ✓	7.5 ✓
	Stiffeners <i>Vertical</i> ...	75 x 50 x 10 ✓						150 x 75 x 11 ✓		
	Brackets, Stays ...							1. 2 at fore end		
HATCH BEAMS	Number ... ..									
	Spacing ... ..									
	Scantling and Sketch ...									
	Bearing Surface ... ..									
FORE AND AFTERS	Number ... ..									
	Spacing ... ..									
	Unsupported Lengths ...									
	Scantling* and Sketch ...									
HATCH COVERS	Material ... ..				Steel					
	Thickness ... ..	12	10	11.5 & 9.5	7.5	7.5	7.5	10	7.5	7.5
	How fitted ... ..	Plated & hinged	hinged	Plated	hinged	Plated & hinged	hinged	Plated hinged	hinged	hinged
	Bearing Surface ... ..									
Spacing of <del>cleats</del> <i>Bolts</i> ... ..		350	350	100	520-610	350-600	350-460	430	875	330-380
Number of Tarpaulins ... ..										
<p>*Are wood fore and afters steel shod at all bearing surfaces?</p> <p>Are battens and wedges efficient and in good condition?</p> <p>Are tarpaulins in good condition and in accordance with rule requirements?</p> <p>Are lashings provided in accordance with rule requirements?</p>										

Particulars of any special features :- *Longitudinal framing. Electrically welded.*



© 2021

Lloyd's Register Foundation