

27-11-23

(944/45) 22.5.24.

(946/47) 8.10.24.

(977/8/9) 14.2.25

(989/90) 25.6.25.

MIDSHIP SECTION.

N^{os} 934-5-6 AND 7. 1944/5. 1946/7.

STEEL SCREW TRAWLERS.

DIMENSIONS 138'-4" B.P. x 23'-7 1/2" MLD. x 14'-0" MLD.

SCALE 1/2" ONE FOOT.

PLAN No. 944.


FOR ENCLOSURE TO

Messrs. The Sunning
Lloyd's Register of Shipping, Hull.

COCHRANE & SONS, LTD.

SHIPBUILDERS, SELBY

D.T. 23/11/23.

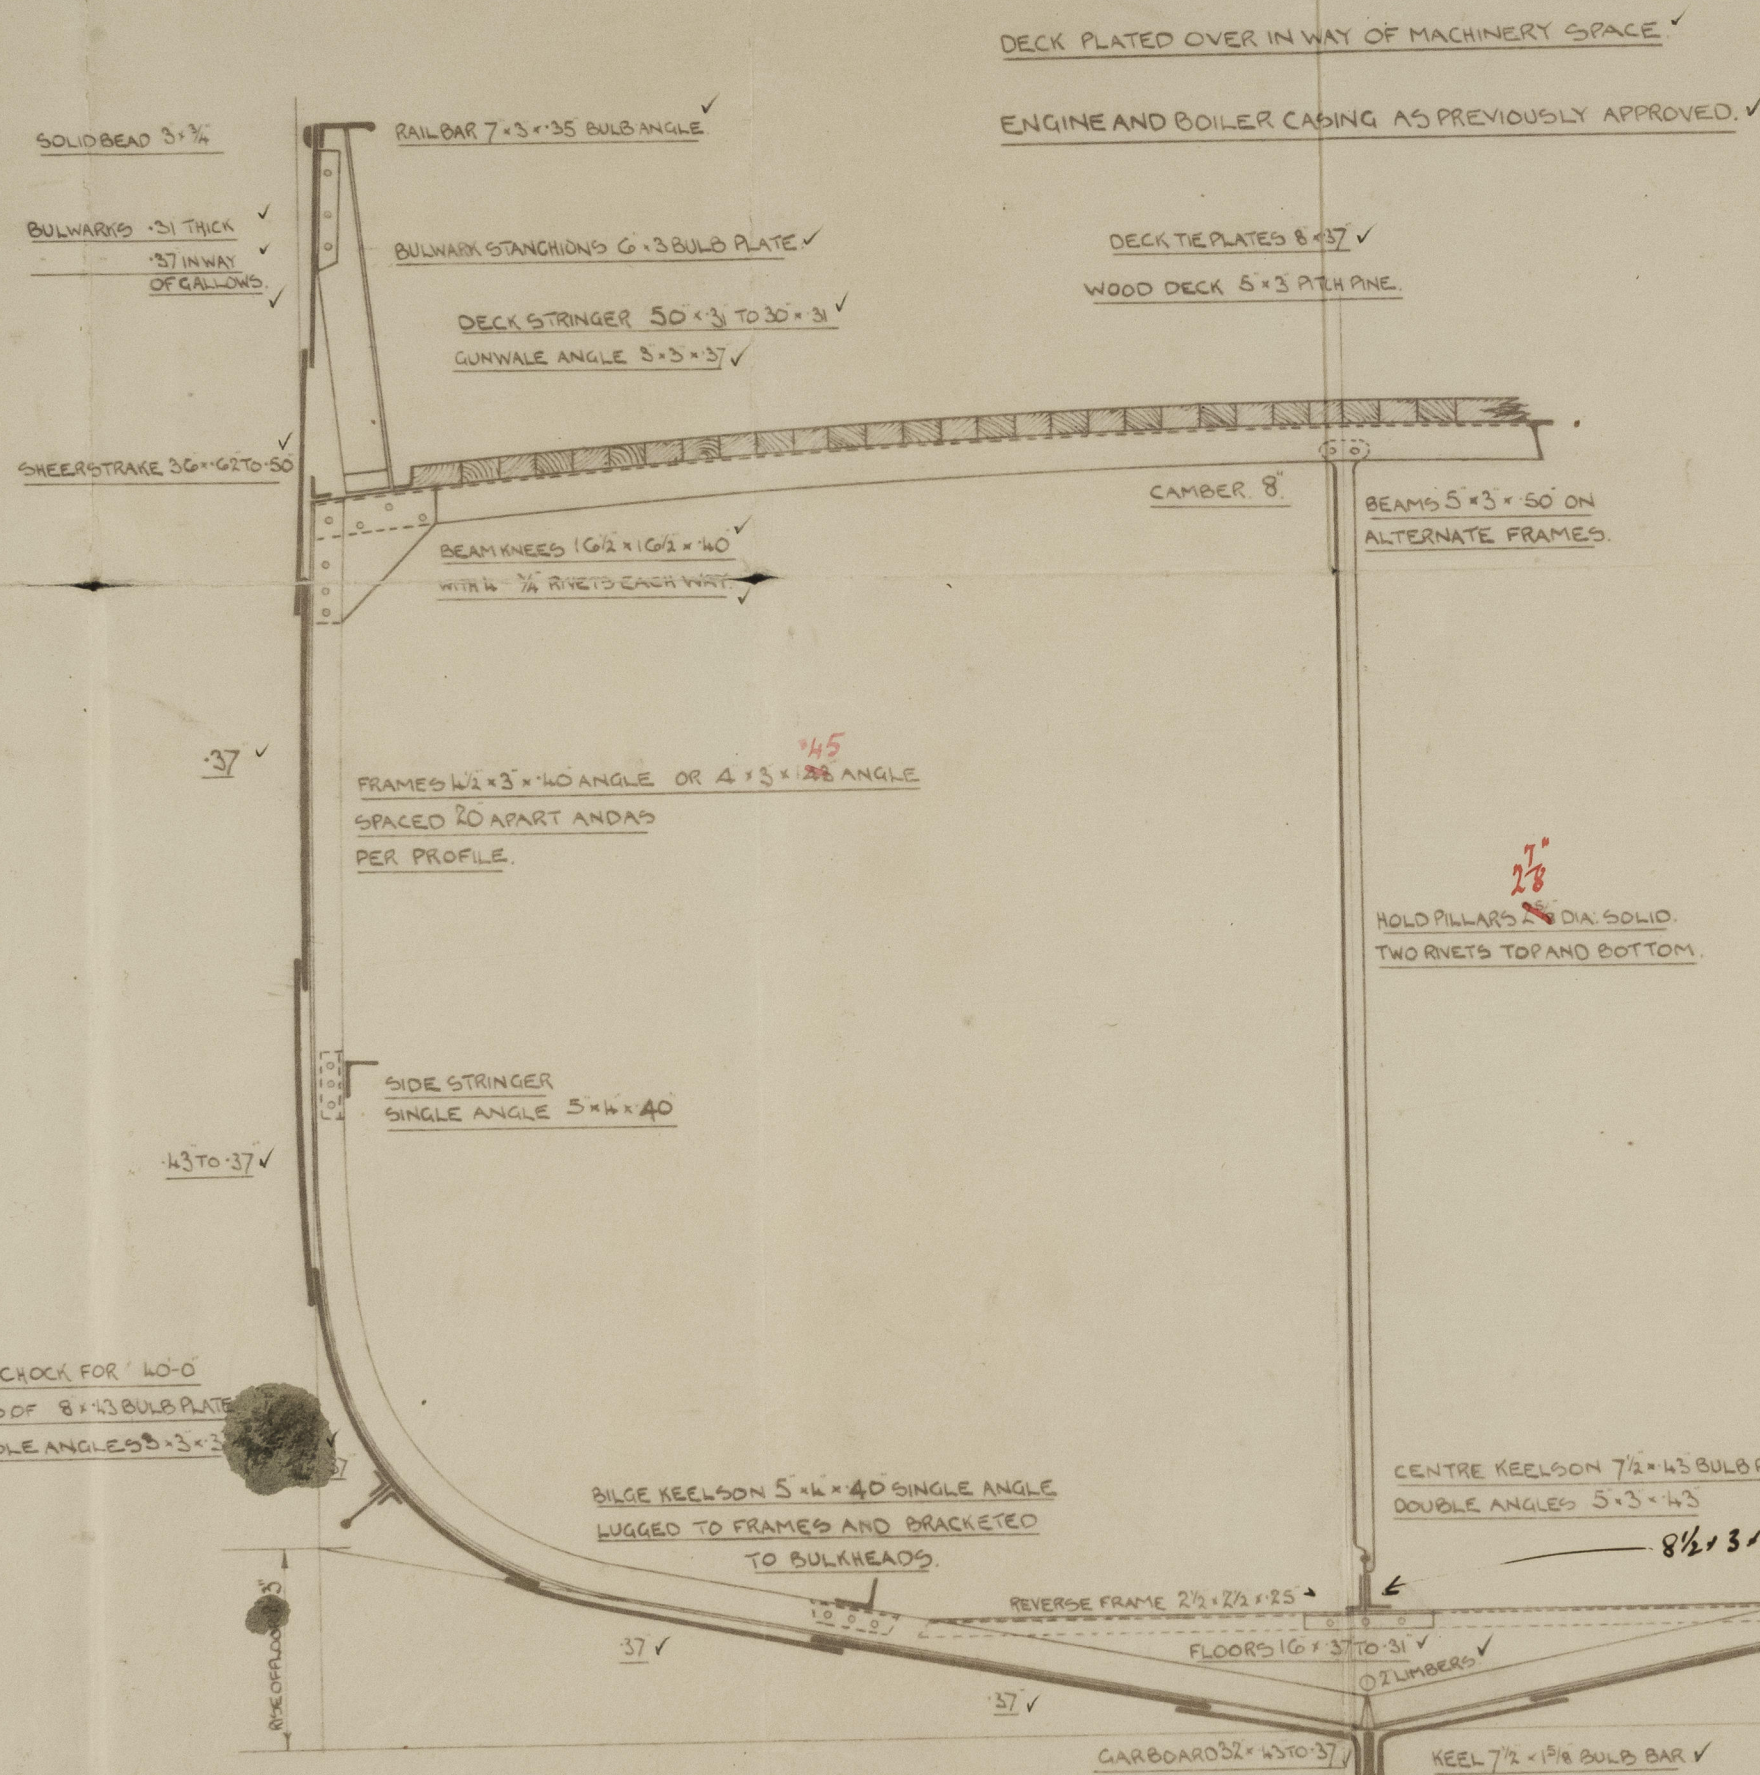

NUMERALS.

B+D ----- 37.62 ✓

L x (B+D) ----- 5203.97 ✓

EQUIPMENT.

1ST BOWER ANCHOR ----- 8 CWT'S STOCKLESS ✓

2ND " ----- 7 1/4 " ✓

KEEDGE ANCHOR ----- 3 1/4 " EX STOCK ✓

120 FATHOMS 1 1/2" STUD LINK CABLE. ✓

GO " 6" HAWSER. ✓

GO " 5" WARP. ✓

RIVETING.

BUTTS OF SHELL PLATING LAPPED AND DOUBLE RIVETED, EXCEPT GARDBOARD AND SHEER STRAKE WHICH ARE STRAPPED AND DOUBLE RIVETED. LANDINGS DOUBLE RIVETED. BULWARKS SINGLE RIVETED.

STEM 7 1/2" x 1 1/2" BULB BAR ✓

STERNPOST 6" x 3 1/2" ✓

RUDDER AS PER RULE ✓

BULKHEADS AS PER PROFILE ✓

ENGINE FLOORS 50" ✓

BOILER ROOM FLOORS 43" ✓

lcl
27.11.23.



© 2021

Lloyd's Register
F010615-010623-0289

990 $\frac{5}{s}$ Lord Penruik
Hull Report 36822.

989 $\frac{5}{s}$ Lord Weir.
Hull Report no. 36771.

PLANS TRANSFERRED
TO SISTER VESSEL

GEORGIOUS L

Middle Section.

W.S. 291
Rocheanes yard no. 934-5-bⁿ

1944/5 1946/7

1977/8/9

1989/90

For II ex" Lord Londonderry
934

88 Hull report no 35346

935 $\frac{5}{s}$ Lord Balfour of
Burleigh.

Hull Report no. 35393.

937 $\frac{5}{s}$ Overdale Wyke.

Hull Report no. 35494.

936 $\frac{5}{s}$ Lord Derby

Hull Report no. 35603.

944 Lord Chelmsford

Hull Rpt no. 35692

945 $\frac{5}{s}$ Lord Incheape

Hull Report no. 35744.

$\frac{5}{s}$ Lord Winkerton

946 Hull Rpt no. 35793

$\frac{5}{s}$ Lord Islington.

947 Hull Report no. 35824.

977 $\frac{5}{s}$ Lord Mountbatten

Hull Report no. 36453.

978 $\frac{5}{s}$ Lord Bradbury

Hull Report no. 36558

979 $\frac{5}{s}$ Lord Devonport.

Hull Report no. 36745.