

5.31

CHARLES HILL & SONS, LTD.
- 7 MAY. 1935
No. 3860
ALBION DOCKYARD, BRISTOL.


TO CLASS LLOYDS 100A - BARGE CARRYING PETROLEUM IN BULK
FOR SERVICE ON RIVER SEVERN, LIMITING PORT SEAWARDS AVONMOUTH
MOULDED DIMENSIONS 83'-3" x 18'-6" AT DECK x 7'-3" DEEP
OVE CROWN OF TANK SCALE: 1/2" = 1 FOOT

EQUIPMENT

1 BOWER ANCHOR 3 1/2 CWTs EX STOCK

1 STREAM " 3/4 " " "

45 FATHOMS 1 1/8" CABLE

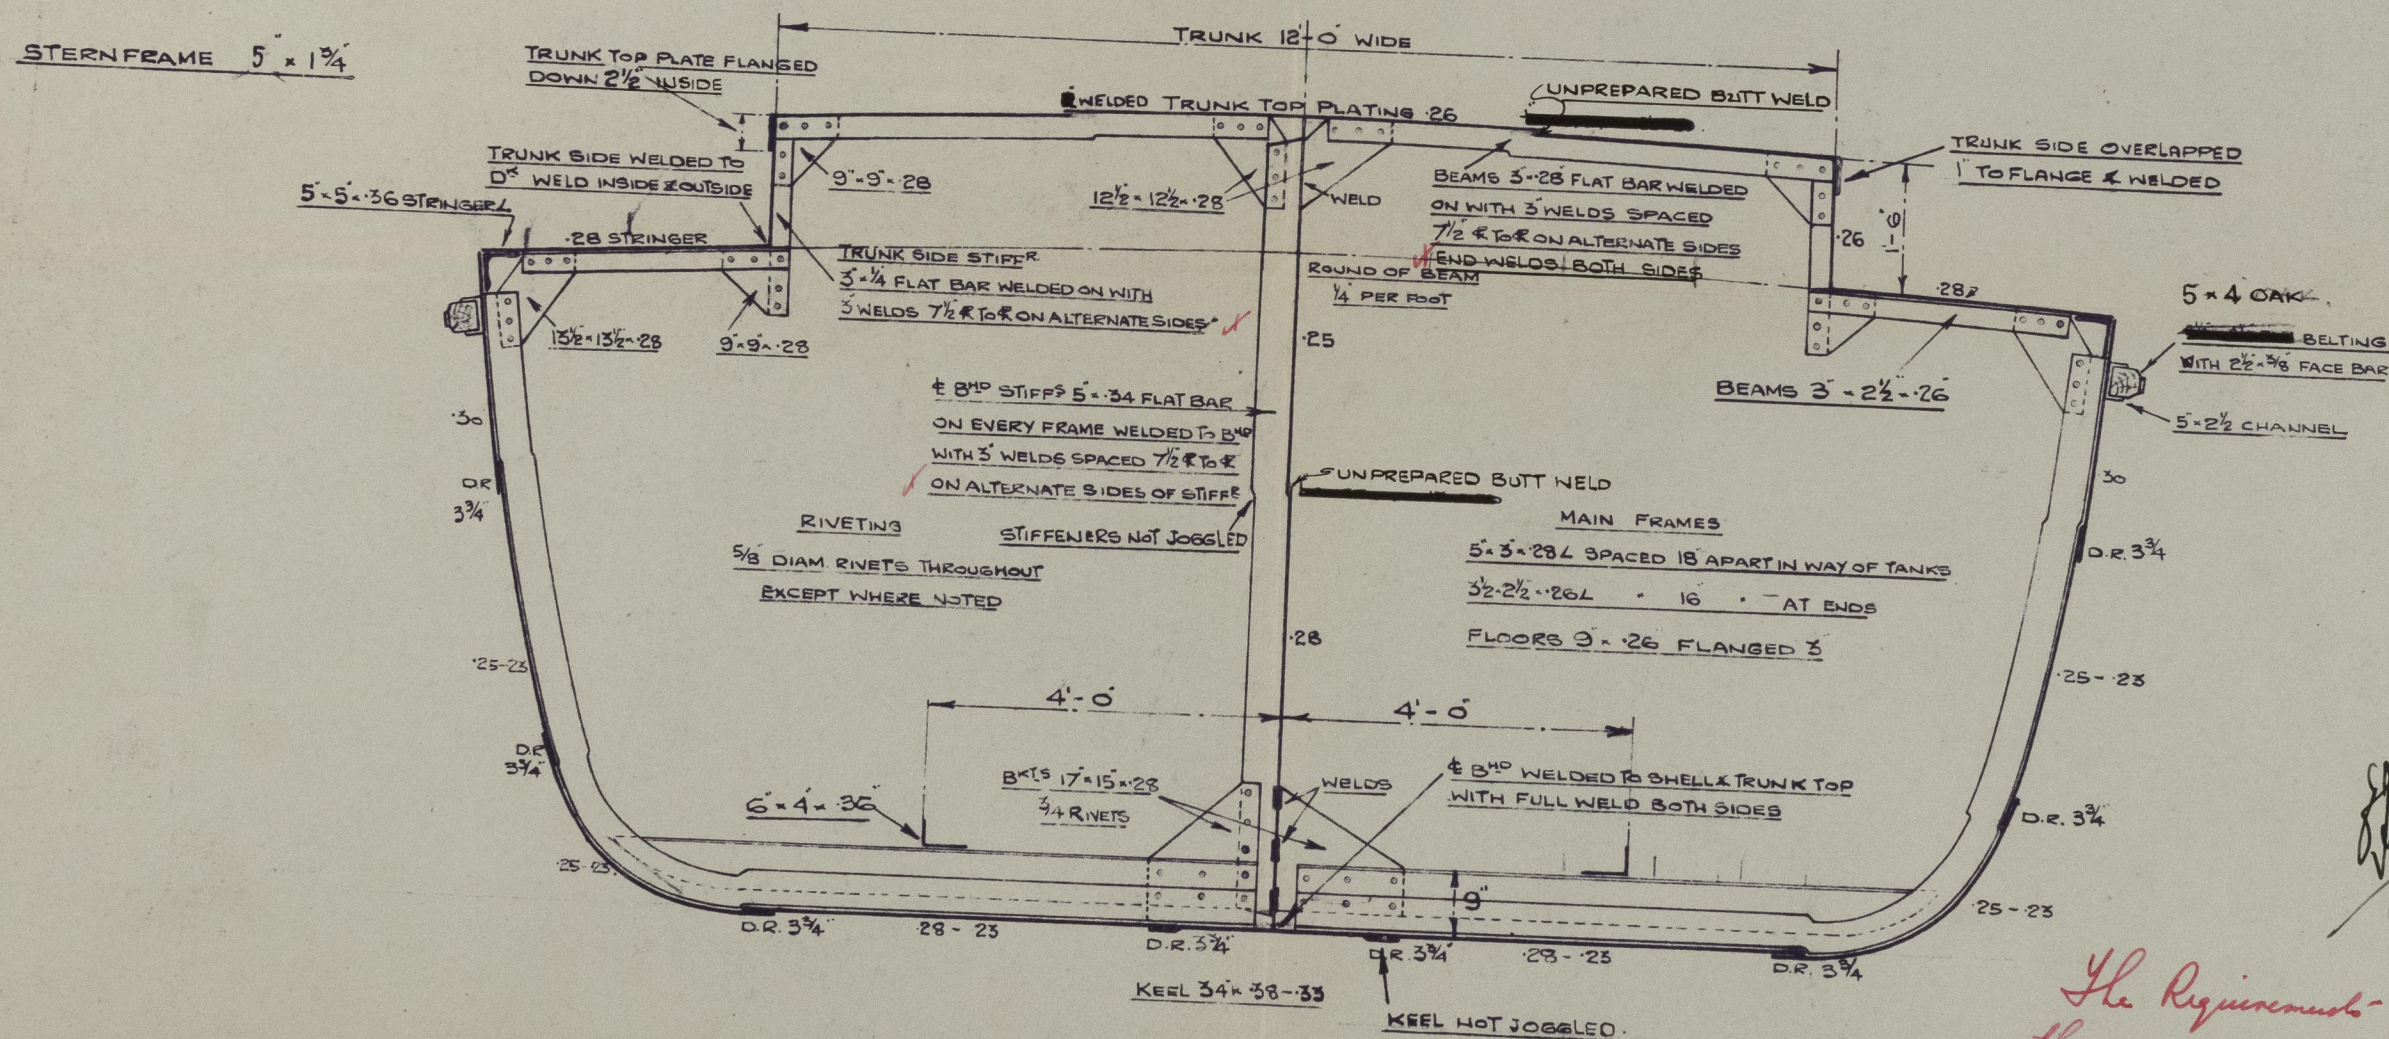

The Requirements of the Rules for
the application of Electro welding
to Ship Construction to be
complied with Lloyd's Reg.

Glas. Hill & Sons Ltd.

No 232.

midship section.

"SEVERN TRAVELLER"



© 2020

Lloyd's Register
Foundation

010631-010639-0003