

PROPOSED BALANCED REACTION RUDDER

TRAWLER'S DIMENSIONS :- 130' x 23'-10½" x 13'-9"

LLOYDS REQUIREMENTS & SURVEY

SPEED NOT EXCEEDING 10½ KNOTS

SCALE :- 1" = ONE FOOT.

Copy of Plan as previously
approved for Messrs
Balanced Reaction Rudder Co
Sunderland.

Means/Floyds Register of Shipping

PINTLES AT A, B AND F ~ 4½" DIAM.

RADIUS OF TILLER 3'-2" ARM 4" x 2½"

BOSS $3\frac{3}{4}$ DEEP $6\frac{1}{4}$ " OUTSIDE DIAM.

CHAINS $\frac{9}{16}$ " DIAM. RODS $\frac{5}{8}$ " DIAM.

COUPLING 14" DIAM.

PALMS $1\frac{1}{2}$ " TK 6 ~ $1\frac{1}{2}$ " DIAM BOLTS

PLATE $\cdot 78'' + \cdot 02'' = 80''$

4 DIAMS APART

PLATE 76 - 02" - 80 TK.

[illegible]

11 PARK TERRACE

SUNDERLAND




PLAN No R/232

No 1035

Proposed Balanced
Reaction Rudder

Cochranes Sons. Ltd.

(approves for the type)
(as fitted)

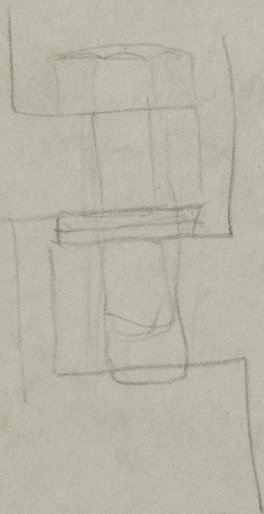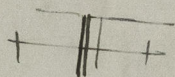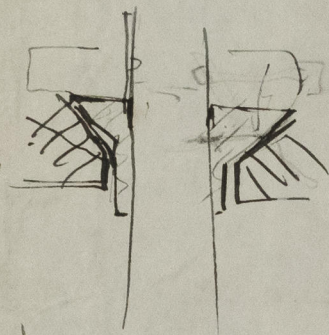

1035.

S.S.

Clyne Castle

WILL REPORT NO.

39591.



© 2020

Lloyd's Register
Foundation

010631-010639-0067

*owners/Lloyds Register of Shipping
Hull.*

010631-010639-0067

© 2020



Lloyd's Register
Foundation