

Steel forging.  
SCALE ~ 1/2" = ONE FOOT.

~~FORGING. ~ STEEL~~

TO PASS LLOYD'S SURVEY & TESTS BEFORE LEAVING  
ARMS TO BE SHUNK ON & KEYS. MAKERS WORKS

SPEED = 11 KNOTS  
AREA OF RUDDER = 194 SQ FT  
C.O.G. 40 FT F.L. OF PIVOT = 5.85 FT  
 $A \times D = 194 \times 5.85 = 1126$   
RUDDER HEAD = 12 1/2% 10% FOR TANKER (SIDE STIFFENING)  
= 15% DM + OWNER'S EXTRA  
= 15 1/2% DM

STEERING EQUIPMENT TO SUIT 1550R RUDDER HEAD

Rudder Head & Rudder Post to be Coupled Together by a 6" x 4" x 10" FITTED BALL'S  
Alternate steel PILES of TURNING STEEL TAPERED IN RUDDER AREA  
SCREWED UP TIGHT BY NUTS & SCRT PLUGS ALL SUPPLIED BY MARINE  
GRADE TO BE TAKEN THAT CHECKS IF PILES ARE IN LINE, SO THAT  
THE RUDDER WILL BE A GOOD WORKING FIT, ALSO TO BE SQUARE  
TO BASE OFS OF SHIP. COUPLING MACHINED TO BE A GOOD FIT  
RUDDER PLATE SUPPLIED & FITTED BY SHIPBUILDERS

RIVETS IN ARMS TO BE 1/4" DIA SPACED 4" DIA'S  
2 COMPLETE ROWS & COUNTERSUNK ON OUTSIDE OF ARM.  
RIVETS MUST NOT BE OPPOSITE EXCEPT AT  
OUTER ENDS OF ARMS.  
EXTRA RIVETS BETWEEN ROWS TO MAINTAIN  
INTERMATION.

DETAIL OF TOP PINTLE AND GUDGEON

### PLAN OF STOPPER GUDGEONS

### DETAIL OF PINTLES AND GUDGEONS

## PLAN OF OTHER GUDGEONS

BOTTOM PINTLE AND GUDGEON

~~EXACT SPECIFICATIONS OF RUDDER ARMS & GAUGE FOR TURNING PIVOTS WILL BE SENT LATER.~~  
POINT GAUGE TO BE SUPPLIED TO SHIPBUILDERS OF RUDDER HEAD AFTER MACHINING.  
ALL MACHINING & DRAWLING TO BE DONE BY MACHINISTS.  
FORGING MARKS TO APPEAR FOR ANY NECESSARY ADJUSTMENT BEFORE DESPATCHING.  
WRITTEN DIMENSIONS ONLY TO BE TAKEN.  
ANY ALTERATION TO BE NOTIFIED TO  
DIMENSIONS SHOULD BE CAREFULLY WORKED TO AS WE ONLY PAY ON WEIGHT  
CALCULATED TO THESE DIMENSIONS.

SCALE:  $\frac{1}{2}$ " = ONE FOOT

CAST STEEL

~~TO PASS LLOYDS SURVEY~~

PRINCIPAL DIMENSIONS OF SHIP ~

~~LENGTH B.P. 535' 0"~~  
~~BREADTH MLD. 74' 0"~~  
~~DEPTH MLD. 34' 3" TO 2ND DR.~~  
~~48' 9" TO UPPER DR.~~  
~~DRIFT~~

RABBIT 詳細

10 NOV 1936

Examined. 26.1.37.  
In order. (Wass)  
Jethro 18-1-37





Approved 14-10-1936  
Wm. C. C.  
for Chief Surveyor


SECTION 12' FOR  
OF FR. NO. 0.

Osaka Iron Works  
No. 1300 號經  
捕鯨工船

舵 *steering post*  
船 *ship*  
尾 *tail*  
骨 *bone*  
材 *material*

scale 大度	1/2
二番一號	殼 9
株式會社大阪鐵工所 造船部造船設計課 課長 三村 洋二 家園 町	
 	 
四保司	田中 洋二 119-6
1番森田	
監製 月日 感	

ELEVATION  
(LOOKING NPT)

SEE FULL SIZE SECTIONS  
OF BRSE.

010652-010661-0188 © 2021



Rudder & Sternframe

Osaka Ironworks

N<sup>o</sup>. 1200.


20.1.37.

TONAN MARU N<sup>o</sup>. 2

535'

Osaka 1200

Rudder & Sternframe


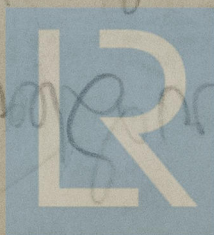


© 2021

Lloyd's Register  
Foundation

010652 - 010661 - 0188



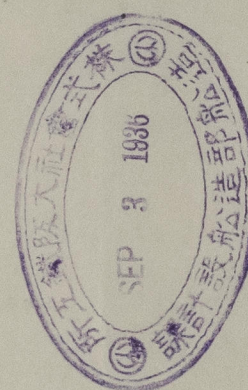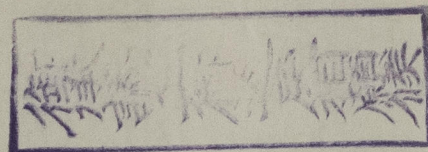

第五號參五第發船



© 2021

Lloyd's Register  
Foundation