

Lloyd's Register of Shipping.


SURVEYS FOR FREEBOARD.

(CONDITIONS OF ASSIGNMENT.)

 Index No. _____
 (For London Office only.)

Ship's Name "BULBY." Port of Survey HULL.
 Official Number 180327 Surveyor's Signature J. Barnicot.
 Nationality and Port of Registry BRITISH - FLEETWOOD. Date of Survey 14/1/54 - 23-1-54.


Disposition and dimensions of superstructures, trunks, deckhouses and machinery casings to be inserted in the diagrams and tabular statement:—

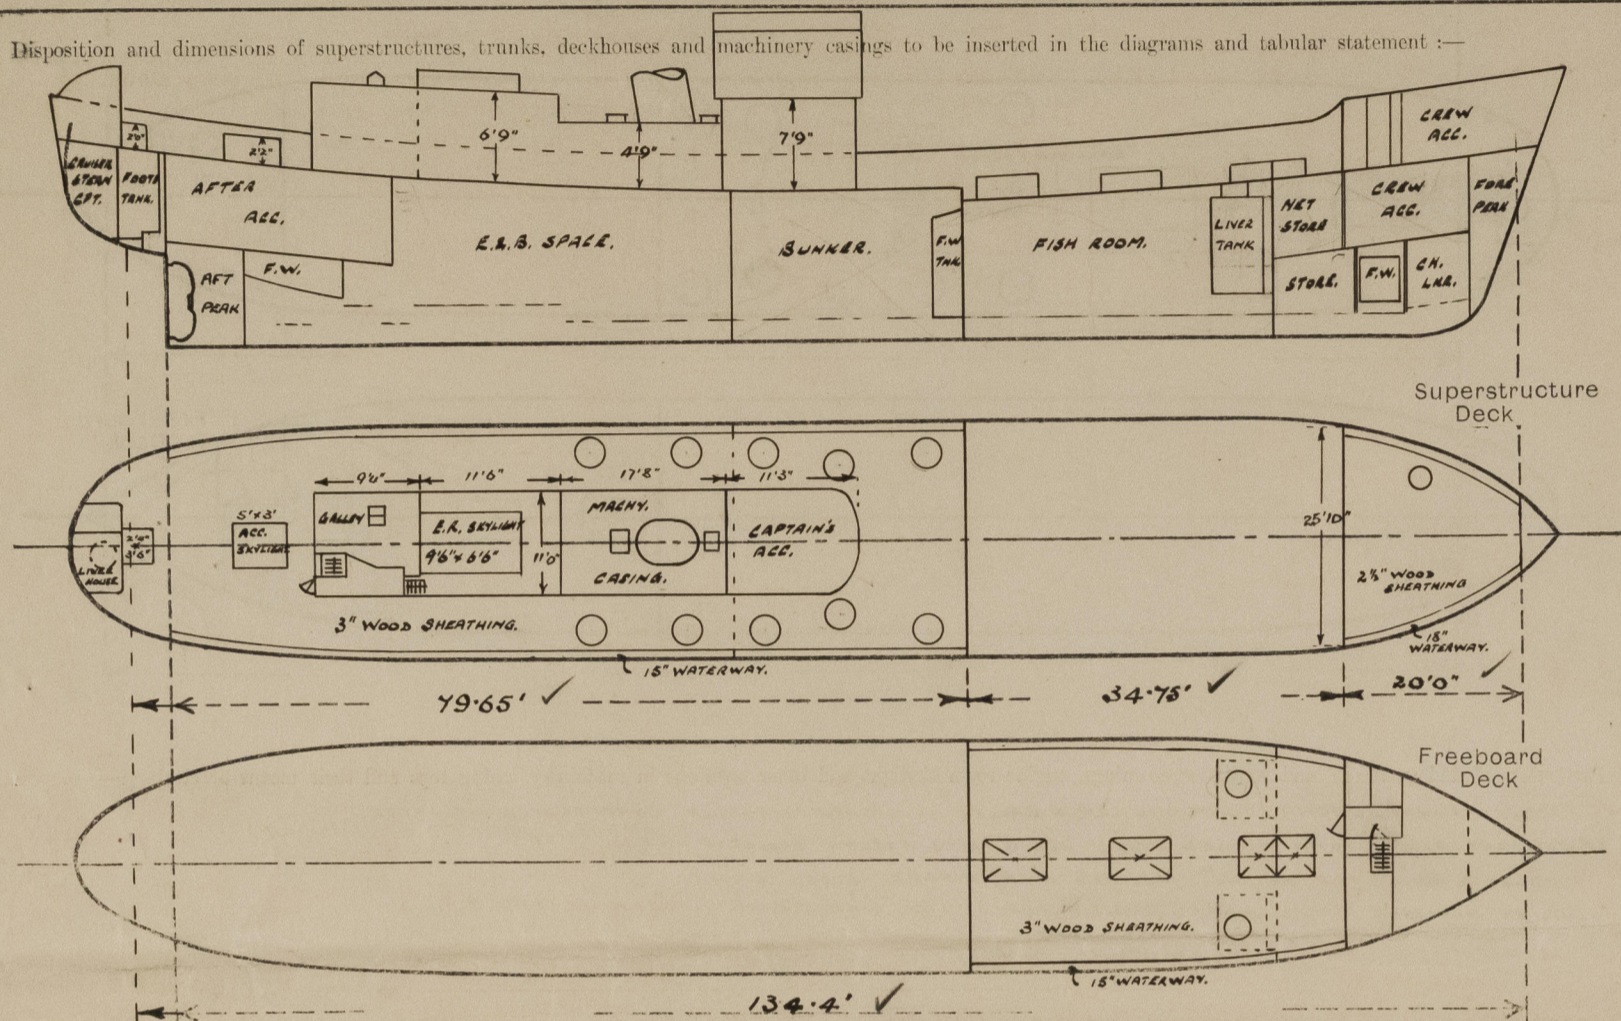

Particulars of Superstructures, Trunks, Casings, Deckhouses.								
	Coaming	Plating	Stiffeners	Spacing	End Attachments of Stiffeners	Size of Openings	Height of Sills	Height of Casings
Poop Bulkhead ...	✓							
Raised Quarter Deck Bulkhead ...	0.25" ✓	✓	6" x 3" x 32" L ✓	30" ✓	NONE	NONE	✓	9" ✓
Bridge, After Bulkhead ...	✓							
Bridge, Forward Bulkhead ...	✓							
Forecastle Bulkhead25" ✓	.25" ✓	PARTITIONS, 4" x 2 1/2" x 30" & 3 1/2" x 1 1/2" CONVEY. BARS ✓	27" to 36" ✓	NONE	4'4" x 1'9" ✓	24 7/8" ✓	4'1" ✓
Trunk, Aft ...	✓							
Trunk, Forward ...	✓							
Exposed Machinery Casings on Raised Quarter Decks31" ✓	.31" ✓	5" x 3" x 1/2" & 3" x 2 1/2" x 1/8" L ✓	27" to 52" ✓	BARKTS. TO TOP LUGS AT BOTTOM ✓	4'8" x 1'10" ✓	17" ✓	4'9" 46'9" ✓
Exposed Machinery Casings on Superstructure Decks ...	✓							
Machinery Casings within Superstructures not fitted with Class I Closing Appliances ...	✓							
Deckhouses on <u>R.Q.</u> Deck Ships25 ✓	.35 CORNERS ✓	3" x 2 1/2" x 38" L ✓	28" to 36" ✓	BRACKETS TOP AND BOTTOM ✓	SEE COMPANIONWAYS ✓		4'9" ✓
Particulars of Closing Appliances (state if capable of being manipulated from both sides).								
Poop Bulkhead ...	✓							
Raised Quarter Deck Bulkhead ...	NONE	✓						
Bridge, After Bulkhead ...	✓							
Bridge, Forward Bulkhead ...	✓							
Forecastle Bulkhead ...	1. HINGED WOOD DOOR 2" THICK - SPRING LOCK OPERATED BOTH SIDES (CLASS 2.) ✓							
Exposed Machinery Casings on Raised Quarter Decks ...	1 HINGED STEEL DOOR (IN HALVES) 25" THICK, SPRING LOCK OPERATED BOTH SIDES (CLASS 2.) ✓							
Exposed Machinery Casings on Superstructure Decks ...	✓							
Machinery Casings within Superstructures not fitted with Class I Closing Appliances ...	✓							
Deckhouses on <u>R.Q.</u> Deck Ships ...	None. See Companionways 2. ✓							

PARTICULARS OF PROTECTION TO OPENINGS, ETC.

The following diagrams should be used to indicate the positions of cargo and coaling hatchways, gangway, cargo and coaling ports, ventilators, companionways, etc., which would affect the seaworthiness of the ship:—

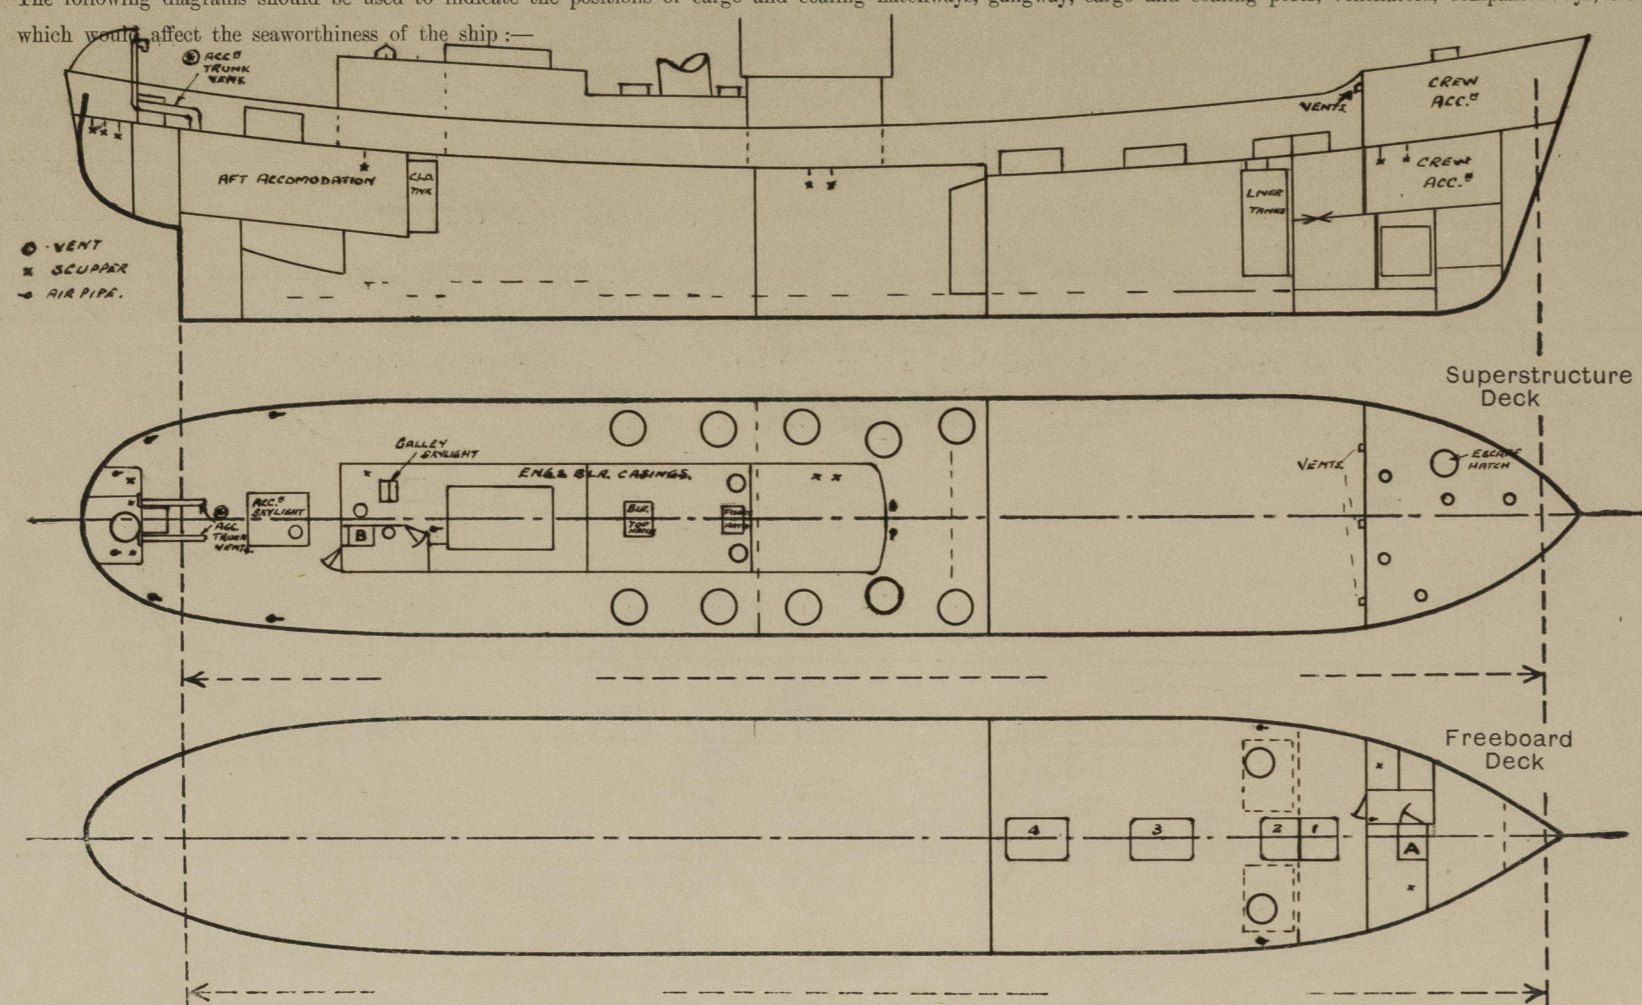

Particulars of filley, funnel and ventilator coamings, engine room skylight and other openings in machinery casing tops and their means of closing:—

FIDDLEY, FUNNEL & VENT. COAMINGS, E.R. & GALLEY SKYLIGHTS STRONGLY CONSTRUCTED OF STEEL.

E.R. SKYLIGHT FITTED WITH HINGED STEEL FLAPS WITH STRONG BULL'EYE LIGHTS.

FIDDLEY & BOILER TOP HATCHES PROVIDED WITH HINGED STEEL COVERS.

GALLEY SKYLIGHT FITTED HINGED BRASS FLAPS 18"x10" WITH STRONG GLASS LIGHTS (SILL 8").

ACCOMMODATION SKYLIGHT AFT FITTED WITH STEEL COVERS OVER THE GLASSES

Particulars of Flush Bunker Scuttles:—

FREEBOARD BATH: 2-18 1/2" DIA. SCREW TYPE SCUTTLES (TO LIVER TANKS) 1 EACH PAS.

RAISED QUARTER DECK: 5-21" FLUSH SCREW TYPE SCUTTLES EACH PAS. (BUNKER SPACE)

1-21" DIA. FLUSH SCREW TYPE SCUTTLES IN LINER HOUSE AFT (TO CRUISER STERN COMPART.)
(ALL FITTED WITH KEEP CHAINS.)

Particulars of Companionways:—

(A) COMPANIONWAY ENCLOSED IN FORECASTLE - TO CREW ACCOMMODATION IN FOREHOLD 'TWEEN DECK, OPENING 2'2" x 3'6" - SILL 6".

(B) COMPANIONWAY ENCLOSED IN AFT END MACHINERY CASING, TO AFT CABIN SPACE, OPENING 2'8" x 2'0" - SILL 9".

Particulars of Ventilators in exposed positions on freeboard and superstructure decks:—

FORECASTLE DECK:—

2-6" DIA. FRENCH HEAD VENTS - 26" HIGH.

2-7" DIA. " " " - 26" HIGH.

1-9" DIA. FRENCH HEAD VENT - 26" HIGH

3-5"x3" VENT. CUT IN FORECASTLE BULKHEAD - 6'5" ABOVE FREEBD. DECK.

MACHINERY CASING TOP

2-20" DIA. - TO STOCKHOLD - EACH FITTED WITH SLIDING DOOR 26"x20" - SILL 10" - DOORS CAPABLE OF BEING SECURED IN CLOSED POSITION

GALLEY TOP

1-5" DIA. COWL VENT - 18" COAMING (GALLEY).

1-3" DIA. G.M. VENT - 8" HIGH (ALLEYWAY).

2-9"x3" VENTS - TRUNKED FROM AFT CABIN - THROUGH R.Q.D. TO INSIDE LIVER HOUSE - OUTLETS ON LIVER HOUSE BULKHEAD

SILLS 6'7" ABOVE R.Q.D. (SEE SKETCH)

1-6" DIA. MUSHROOM VENT. FITTED ON AFT CABIN SKYLIGHT - 2'8" ABOVE R.Q.D. (FITTED WITH SCREW TOP)

ALL VENTS. FITTED WITH WOOD PLUGS AND/OR CANVAS COVERS, (EXCEPT STOCKHOLD & M.R. VENTS.).

Particulars of Air Pipes in exposed positions on freeboard, raised quarter, or superstructure decks:—

FREEBOARD DECK.

1- EACH PAS. 3" DIA. x 3'4" HIGH (LIVER TANKS).

1- WITHIN FORECASTLE 1 1/2" DIA. x 3'6" HIGH (C.W. TANK).

R.Q.D. DECK.

3-2" DIA. (CHARTROOM FRONT) x 5'9" HIGH - STAYED - (C.W.)

1- EACH PAS. 2" DIA. x 3'6" HIGH (C.W.)

1- EACH PAS. 4" DIA. x 3'6" HIGH (FOOT TANK).

1- 2" DIA. (AT GALLEY TOP) 2" HIGH (C.L.O. TANK).

2- 3" DIA. (ON AFT DECK HOUSE - LIVER HOUSE TOP) x 10" HIGH (CRUISER STERN COMPART.).

WOOD PLUGS & CANVAS COVERS SUPPLIED.

Particulars of Gangway Cargo and Coaling Ports:—

NONE.

Particulars of Scuppers and Sanitary Discharge Pipes:—

7- 5"x2 1/4" SCUPPERS ON R.Q.D. DECK, CUT THROUGH STRINGER ANGE EACH PORT & STB.

1- 2" WAINPLATE DISCH. FROM FEYLE, LED OVERBOARD BELOW FREEBD. DECK, WITH BRASS STORM VALVE AT SHIPSIDE (STB.)

1- 4" SANITARY DISCH. " " " " " " " " " " " (PORT)

1- 2" & 1-4" WAIN. & SANIT. DISCH. FROM MIDSHIP ACC. LED O'BOARD - R.Q. DECK " " " " " VALVES AT SHIPSIDE (PORT.)

1- 2" GALLEY SCUPPER & W.A. DISCHARGE LED OVERBOARD " R.Q. DECK " " " " " VALVE " " (PORT.)

1- 4" SANITARY DISCH. FROM AFT DECK HOUSE LED O'BOARD BELOW R.Q. DECK " " " " " (PORT.)

2- 2" SCUPPERS - WITHIN AFT DECK HOUSE (LIVERHOUSE), LED OVERBOARD BELOW R.Q.D. WITH SCREEN DOWN FLAT (BEAST) VALVES AT DECK LEVEL - (CAPABLE OF BEING OPERATED WITHIN HOUSE)

Particulars of Side Scuttles:—

NONE SCUTTLES THROUGH SHIP SIDE.

2 in. Inch. ?

Vertical distance of Sill of lowest Side Scuttle above top of keel.

Particulars of Guard Rails:—

FORECASTLE DECK: 3 GUARD RAILS WITH STANCHIONS 3/4" HIGH, & 4 1/2" APART.

FREEBOARD DECK: BULWARKS 4'0" to 4'3" HIGH x 30", WITH 6"x3" 7/16" B.A. RAIL & 7"x3/8" BULB PLATE STAYS 4'10" to 5'5" APART.

R.Q. DECK: BULWARKS 3'3" HIGH x 30" " 6"x3" 7/16" B.A. RAIL & 7"x3/8" " " 4'10" to 5'5" APART.

CASING TOP: 2 GUARD RAILS WITH STANCHIONS 3'0" HIGH & 3'6" APART.

GALLEY TOP: 2 " " " " 2'6" " & 4'3" APART.

Particulars of Gangways, Lifelines, etc.:-

STORM RAILS FITTED ON CASING SIDES 3'6" HIGH, ALL FORE & AFT.

PROVISION FOR LIFE LINES IN FOR'D WELL.

Particulars of Freeing Arrangements.

	Length of Bulwark	Height of Bulwark	Size of Freeing Ports	Number each side	Area each side	Rule area each side
After Well ...	79'6 1/2"	3'3"	No. 2, 3, 5, 6 & 7: 18"x9" No. 1 & 4: 15"x9" No. 4: 6'9"x9" No. 8, 6'9"x9"	9	15 1/2	15.57
Forward Well ...	34'9"	4'3" to 4'0"	2 1/2" x 11 1/2"	1	2 1/2	
State position of each freeing port ...						
(F. and A. position and height above deck edge)						
State whether the freeing ports are fitted with shutters, bars, or rails, and give particulars of such:—						
Additional area where sheer is less than standard.						

PARTICULARS OF PROTECTION TO OPENINGS, ETC.

HATCHWAYS ON FREEBOARD AND SUPERSTRUCTURE DECKS.									
← FREEBOARD DECK →				FUSELAGE DECK	← CASING TOP →				
Description of Hatchway	1	2	3	4	ESCAPE HATCH	FIDDLEY HATCH	BOILER TOP HATCH		
Dimensions of Hatchway	2'8" x 3'3"	3'3" x 3'3"	5'0" x 3'3"	5'0" x 3'3"	18" DIA.	1'5 1/2" x 2'5"	2'3" x 3'0"		
COAMINGS	Height above Deck	15"	15"	15"	18"	6"	9 1/2"	10"	
	Thickness	30"	30"	30"	30"	30"	50"	50"	
	Stiffeners	30"	30"	30"	30"	30"	30"	30"	
	Brackets, Stays	✓	✓	✓	✓	WITH NOTICE PLATE STATING "WATCH ONLY NONE TO BE USED IN CASE OF AN EMERGENCY"	HORIZONTAL STIFFENERS AT TOP 1" x 1/2"	1/2" BRACKETS 10"-12" APART	
HATCH BEAMS	Number								
	Spacing								
FORE AND AFTERS	Number								
	Spacing								
HATCH COVERS	Material	WHITE WOOD	W. WOOD	W. WOOD	W. WOOD	STEEL	STEEL	STEEL	
	Thickness	2 1/4"	2 1/4"	2 1/4"	2 1/4"	0.25"	0.30"	0.30"	
HATCH COVERS	How fitted		ATHWARTSHIP			MECHANICAL DESTROYER TYPE	HINGED	HINGED	
	Bearing Surface	2 1/2"	2 1/2"	2 1/2"	2 1/2"				
Spacing of Cleats	SIDES 2 at 1'10"	2 - 1'10"	3 - 2'0"	3 - 2'0"	OPERATED BOTH SIDES	FITTED WITH 4 TOGGLE BUTTERFLY NUTS & RUBBER SPIGOT JOINT.			
Number of Taraulins	2 at 2'4"	2 - 2'3"	2 - 2'3"	2 - 2'3"					
<p>*Are wood fore and afters steel shod at all bearing surfaces? YES. ✓</p> <p>Are battens and wedges efficient and in good condition? YES. ✓</p> <p>Are tarpaulins in good condition and in accordance with rule requirements? YES. ✓</p> <p>Are lashings provided in accordance with rule requirements? YES. ✓</p> <p>Tarpaulins.</p> <p>NOTE: HINGED GRATINGAS FITTED. ✓</p>									

Particulars of any special features:—



© 2021

Lloyd's Register Foundation