
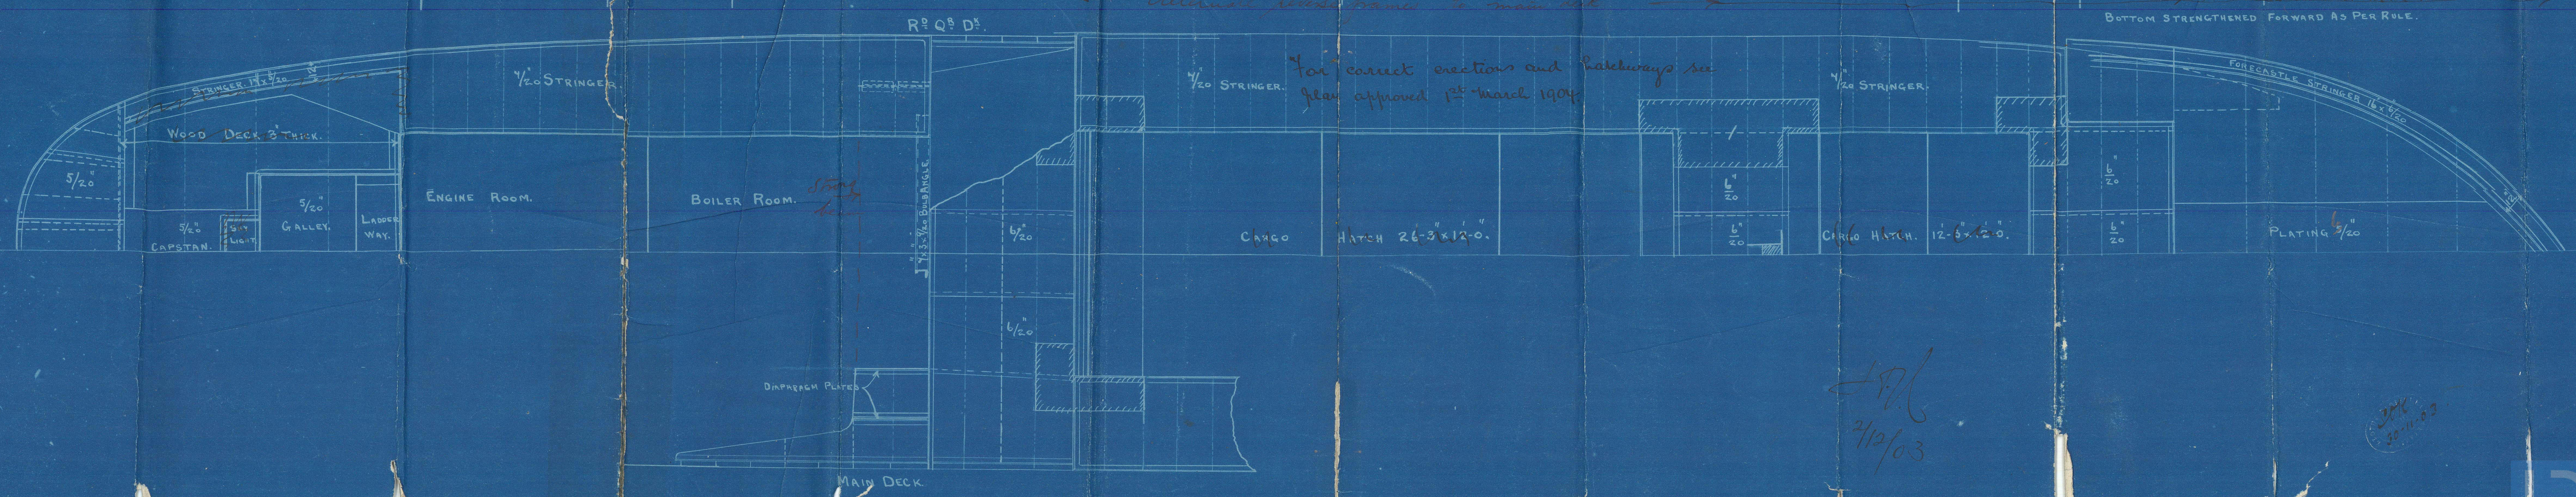


2. 12. 03
18. 2. 04
1. 3. 04
7. 3. 04

For correct erections see plan
approved 1st March 1904

— S. S. N^o 90 —
— PROFILE AND DECK PLAN. —
— SCALE 1/4" = 1 FOOT. —

— DIMENSIONS. —
LENGTH BETWEEN PERP. 121'-0"
BREADTH MOULDED 22'-0"
DEPTH MOULDED 10'-6"




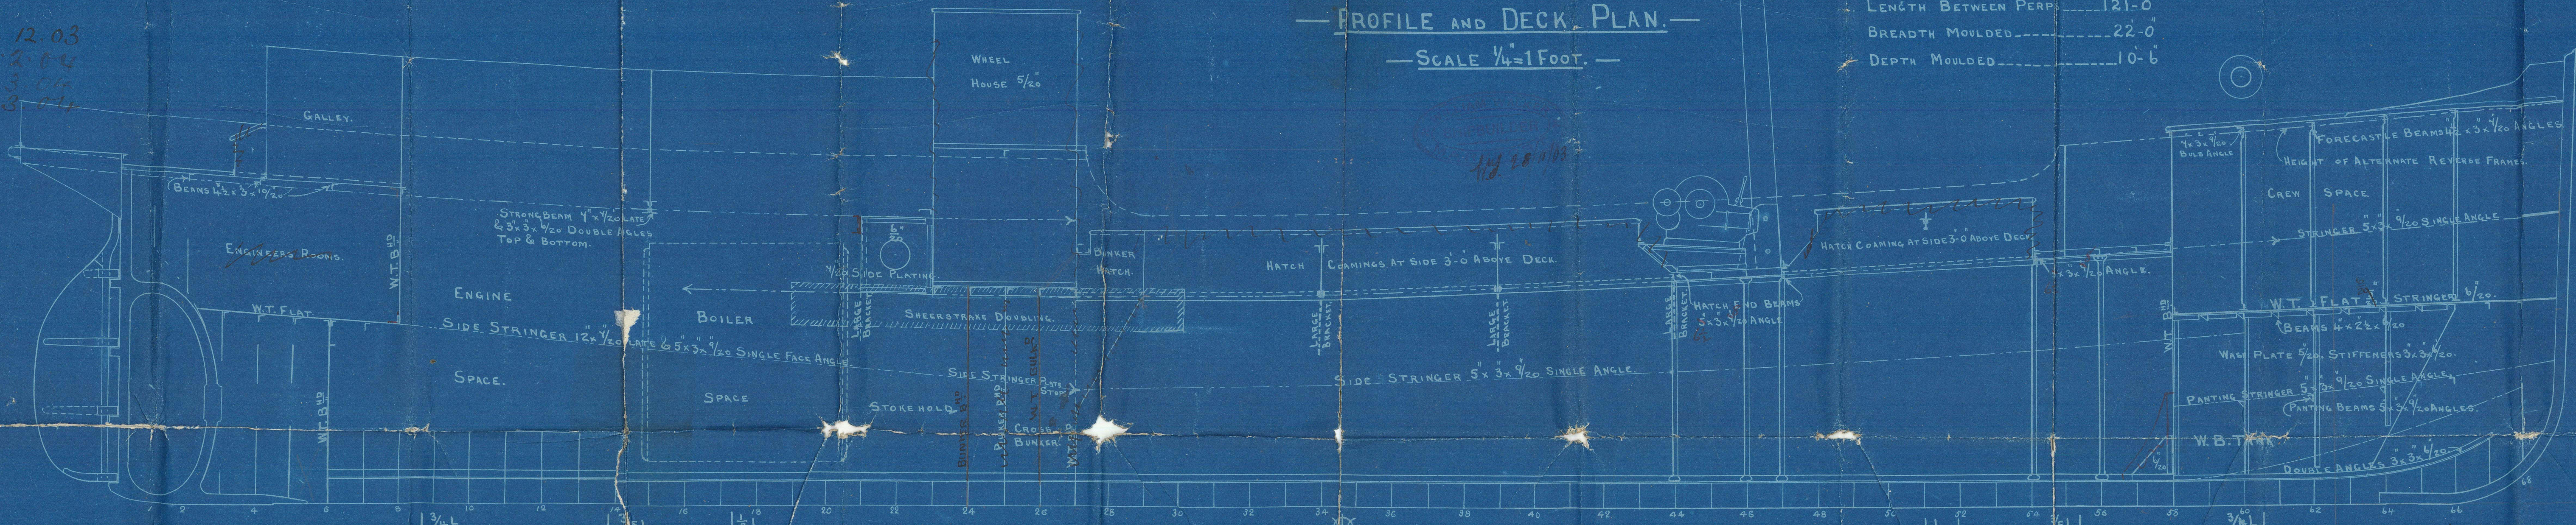


11K51

W. Walker No 90

"ADMIRAL"
Profile & Deck Plan

Bow Rept 1231

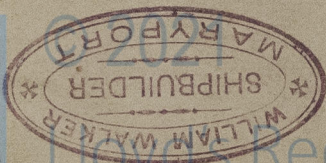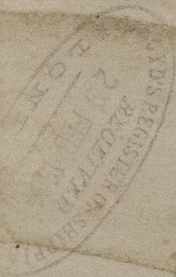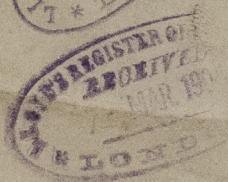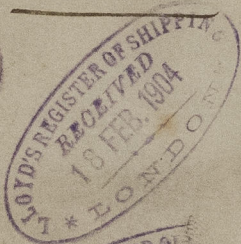

010687-010696-0310