


# P. F. "C" TYPE VESSEL. FABRICATED STERNFRAME.

YARD NOS 7.8 9.10 11

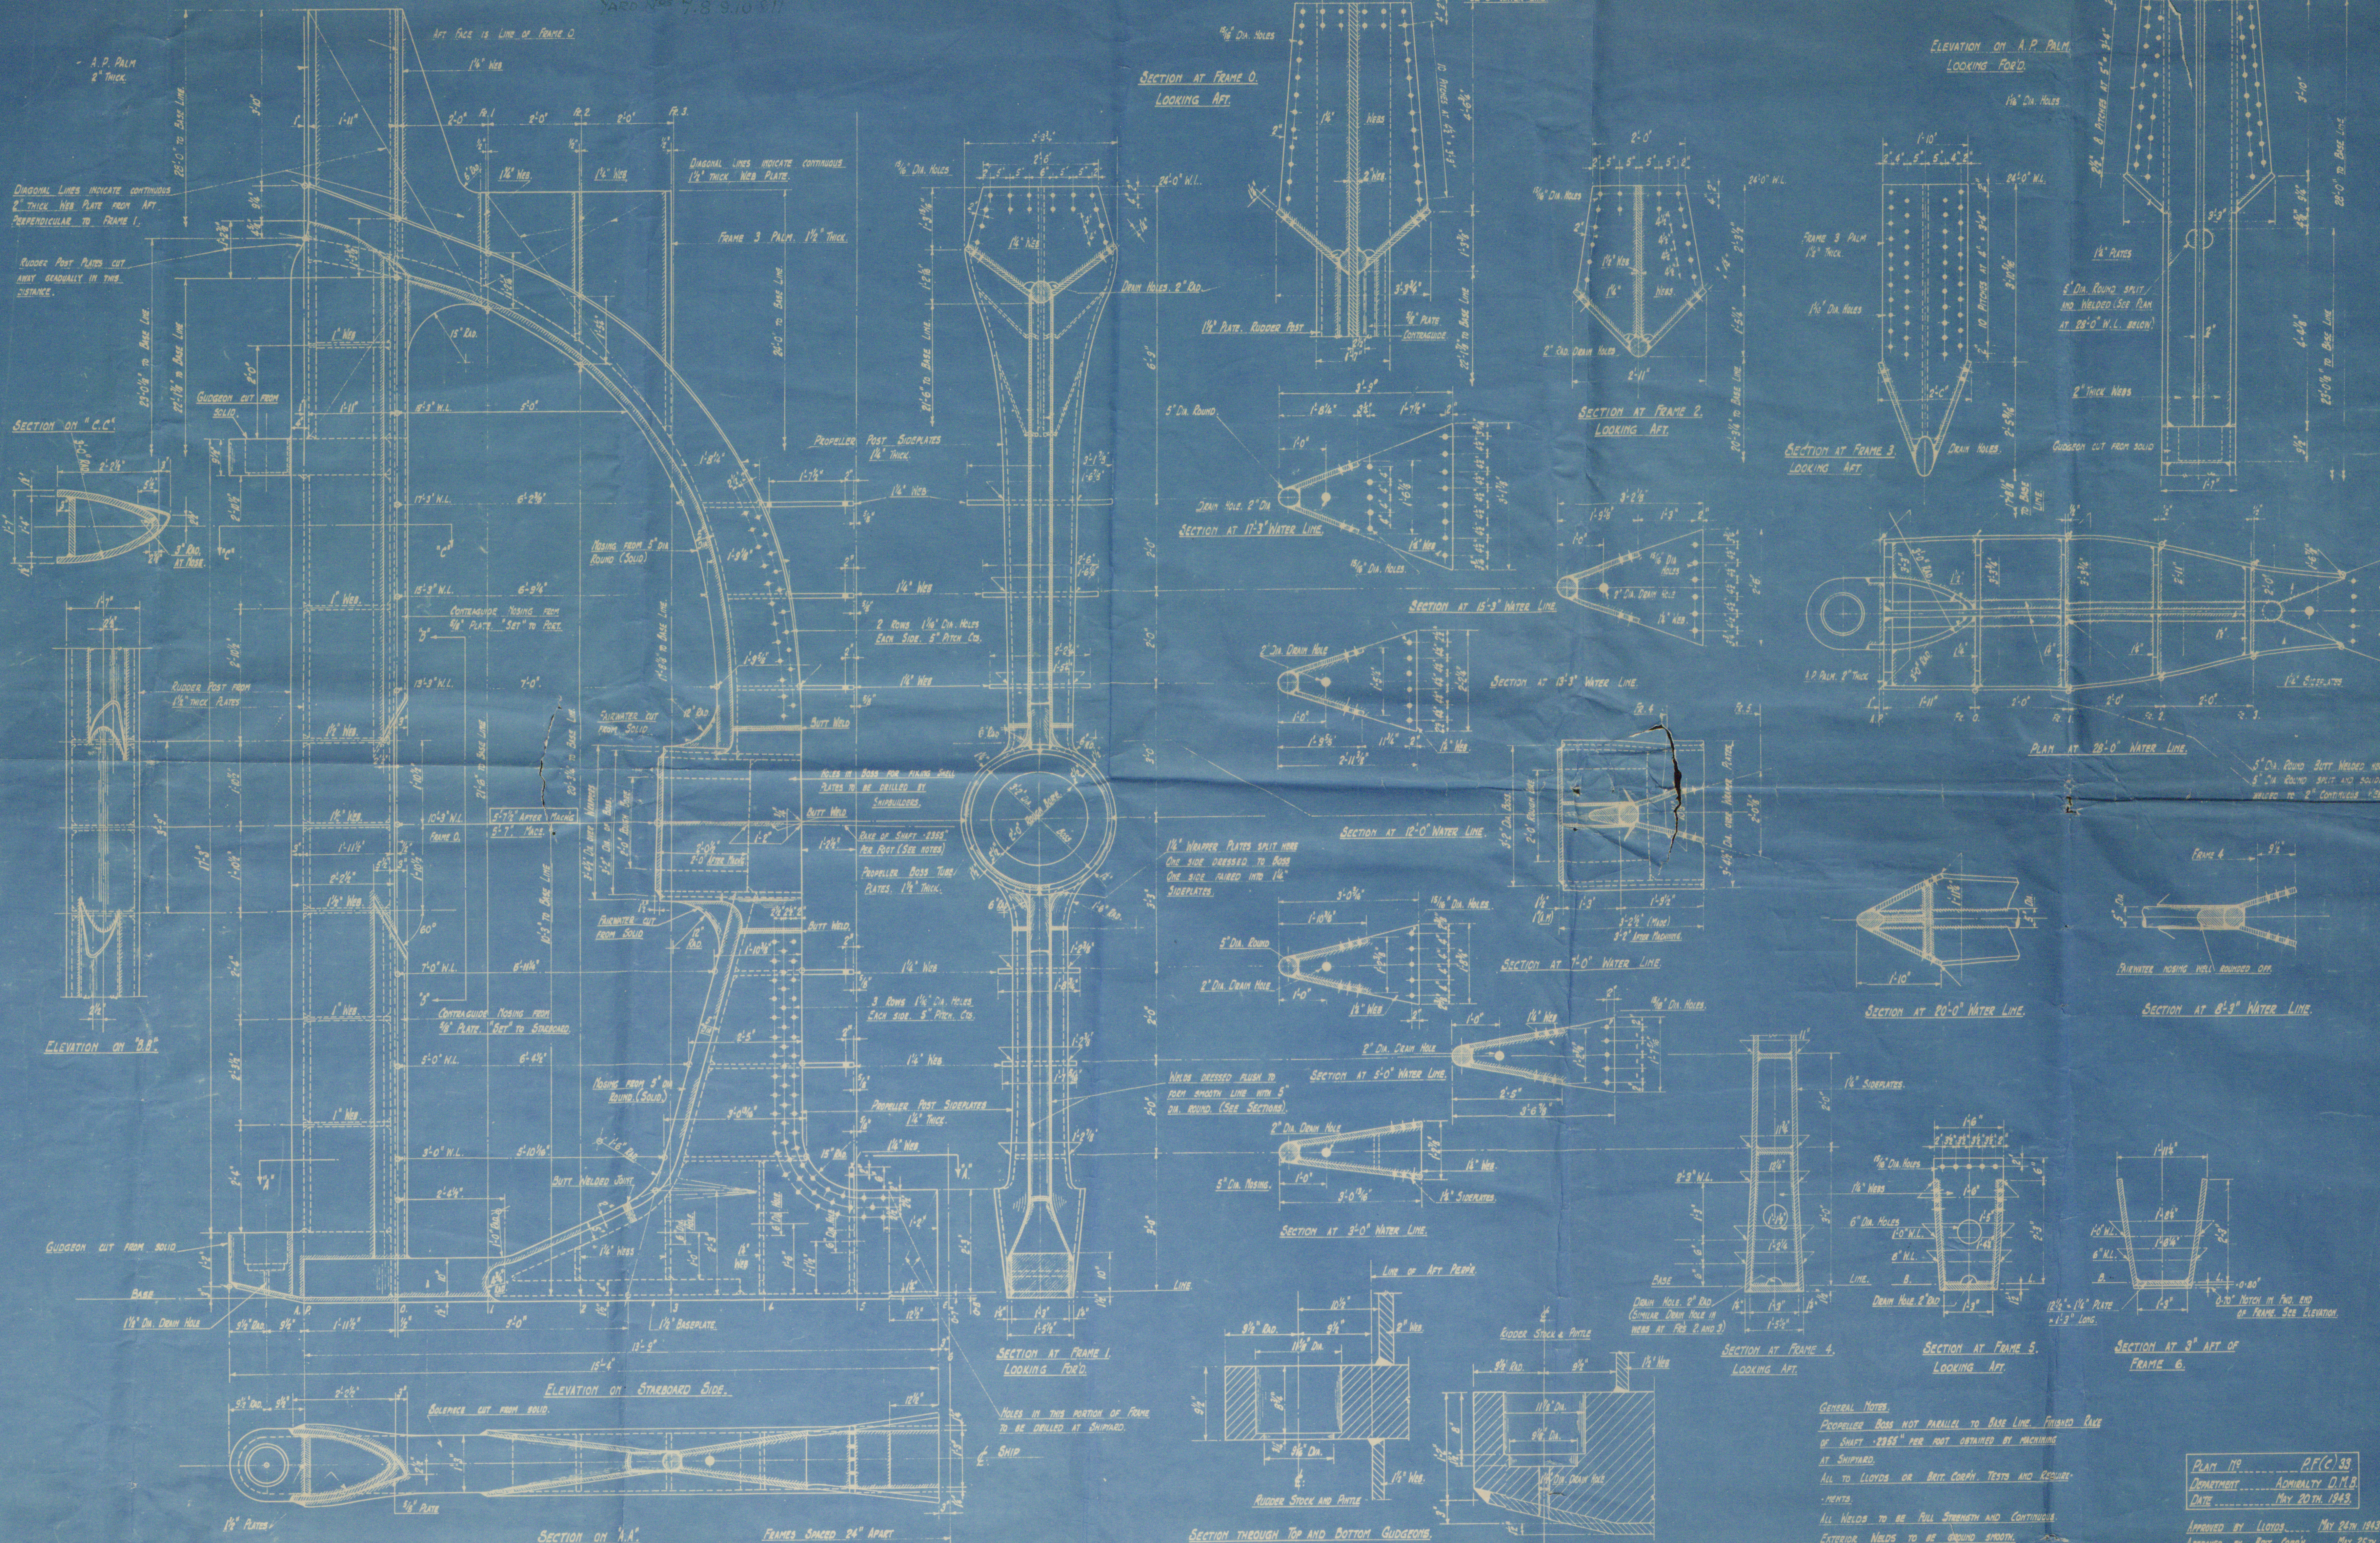

GENERAL NOTES.  
PROPELLER BOSS NOT PARALLEL TO BASE LINE. FINISHED FACE OF SHAFT "2865" PER ROUT OBTAINED BY MACHINING AT SHIPYARD.  
ALL TO LLOYDS OR BRIT. CORP. TESTS AND REQUIREMENTS.  
ALL WELDS TO BE FULL STRENGTH AND CONTINUOUS. EXTERIOR WELDS TO BE GRINDING SMOOTH.

PLANT NO. P.F.C.33  
DEPARTMENT. ROYALTY D.M.B.  
DATE. MAY 20TH 1943.  
APPROVED BY LLOYDS. MAY 24TH 1943.  
APPROVED BY BRIT. CORP. MAY 25TH 1943.

010705-010711-0068




STERN FRAME

SHIP NOS 7.8.9.10&11

SOUTHWICK YARD

Copy of approved plan  
(Approved plan in London)

**SUNDERLAND RPT. NO.** 34730

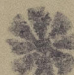Lagosian. 

n/h "LAGOS PALM"

2

010705 - 010711 - 0068



© 2021

Lloyd's Register  
Foundation