

19-20

MIDSHIP SECTION

DIMENSIONS 331'-0" BP x 46'-6" MLD x 25'-6" MLD

SCALE 1/2" = 1 FOOT


CLASS BS * BRITISH CORPORATION

RULE EQUIPMENT

NUMERAL	23832
POOR BRIDGE - FENCE	59-5 x 75-14
CASING - HOUSES	24931-39
2 BONE ANCHORS	45 CWT EACH STOCKLESS
1 " "	38 " "
1 STREAM	12 " "
1 KEDGE	38 " "
26 FATHOMS	1 1/2 SHIP CHAIN CABLE
40 " "	4 1/2 STEEL WIRE
100 " "	4 " "
2 @ 90 " "	6 " "

NUMERALS

BRIDGE MLD	46-6 FT
DEPTH	25-6
TRANS NO	72-0
1ST NUMBER	331-0
LENGTH	331-0
LONG NO	23832-0
2ND NUMBER	
1/2 UNDER DE	12-98
1/2 BRIDGE DE	0-03

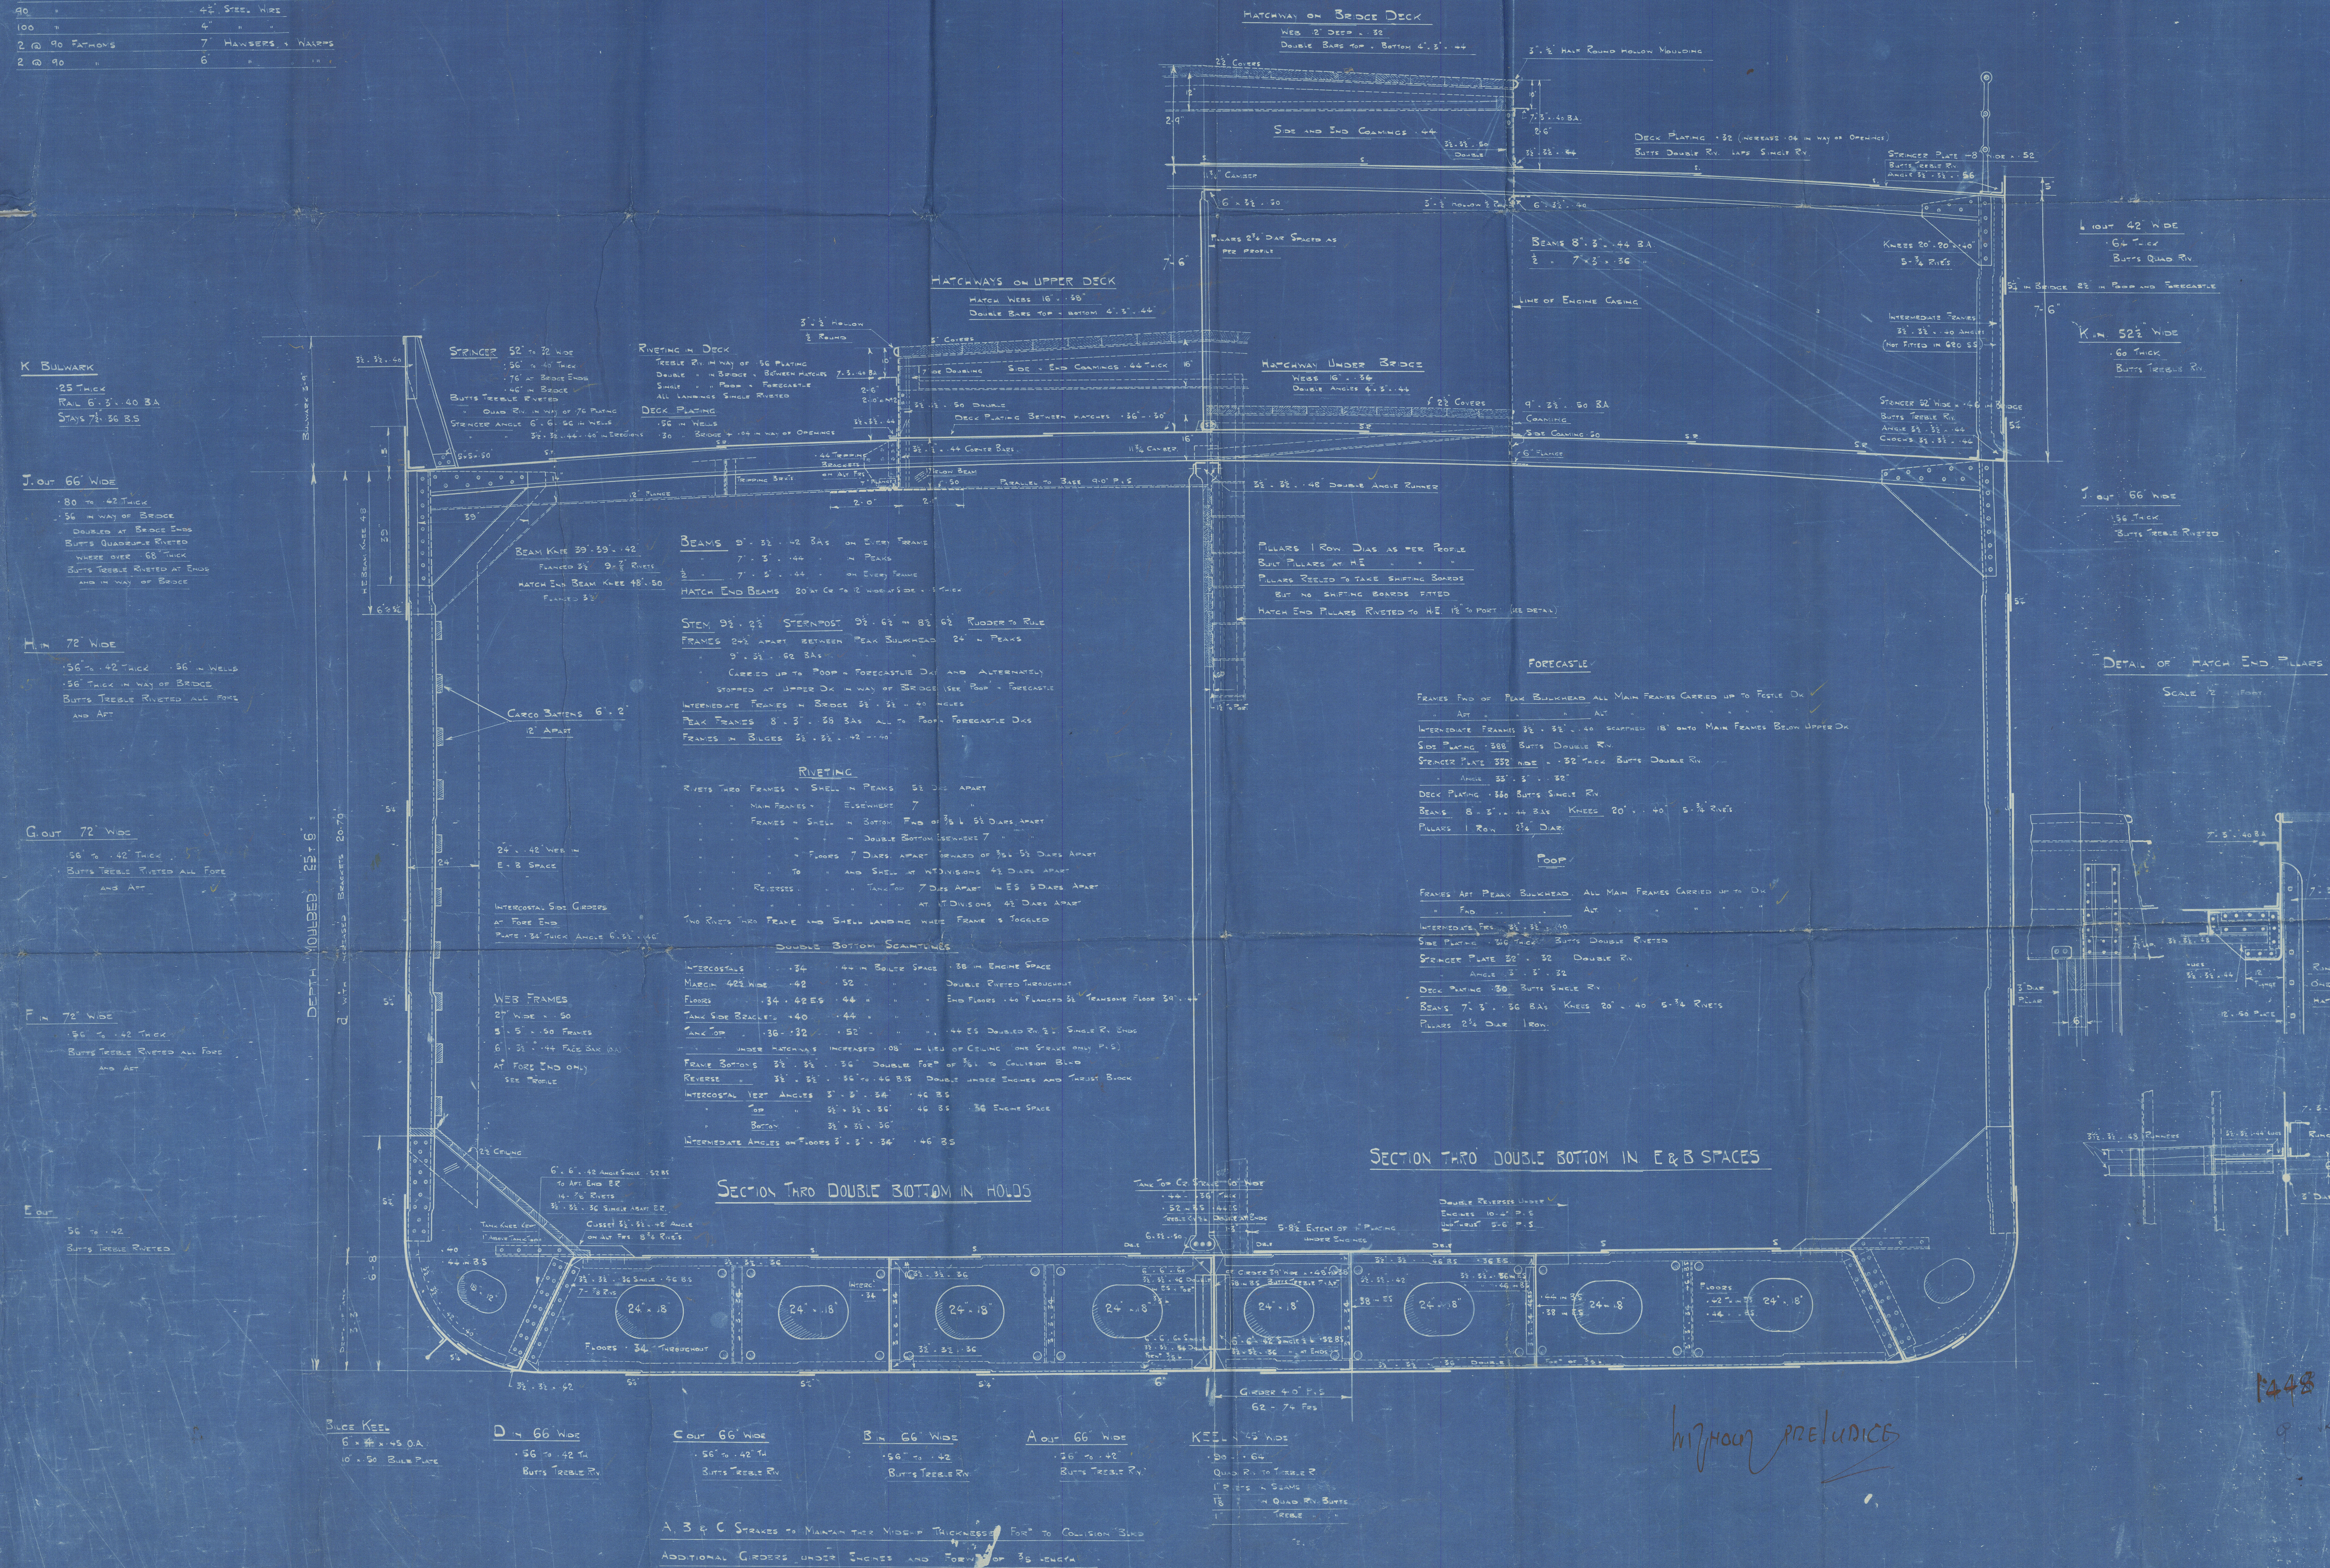


1448
8 Jan 19

St. Catherine

Midship Section



© 2021

Lloyd's Register
Foundation

010720-010726-0279






© 2021

Lloyd's Register
Foundation