


10/8/28

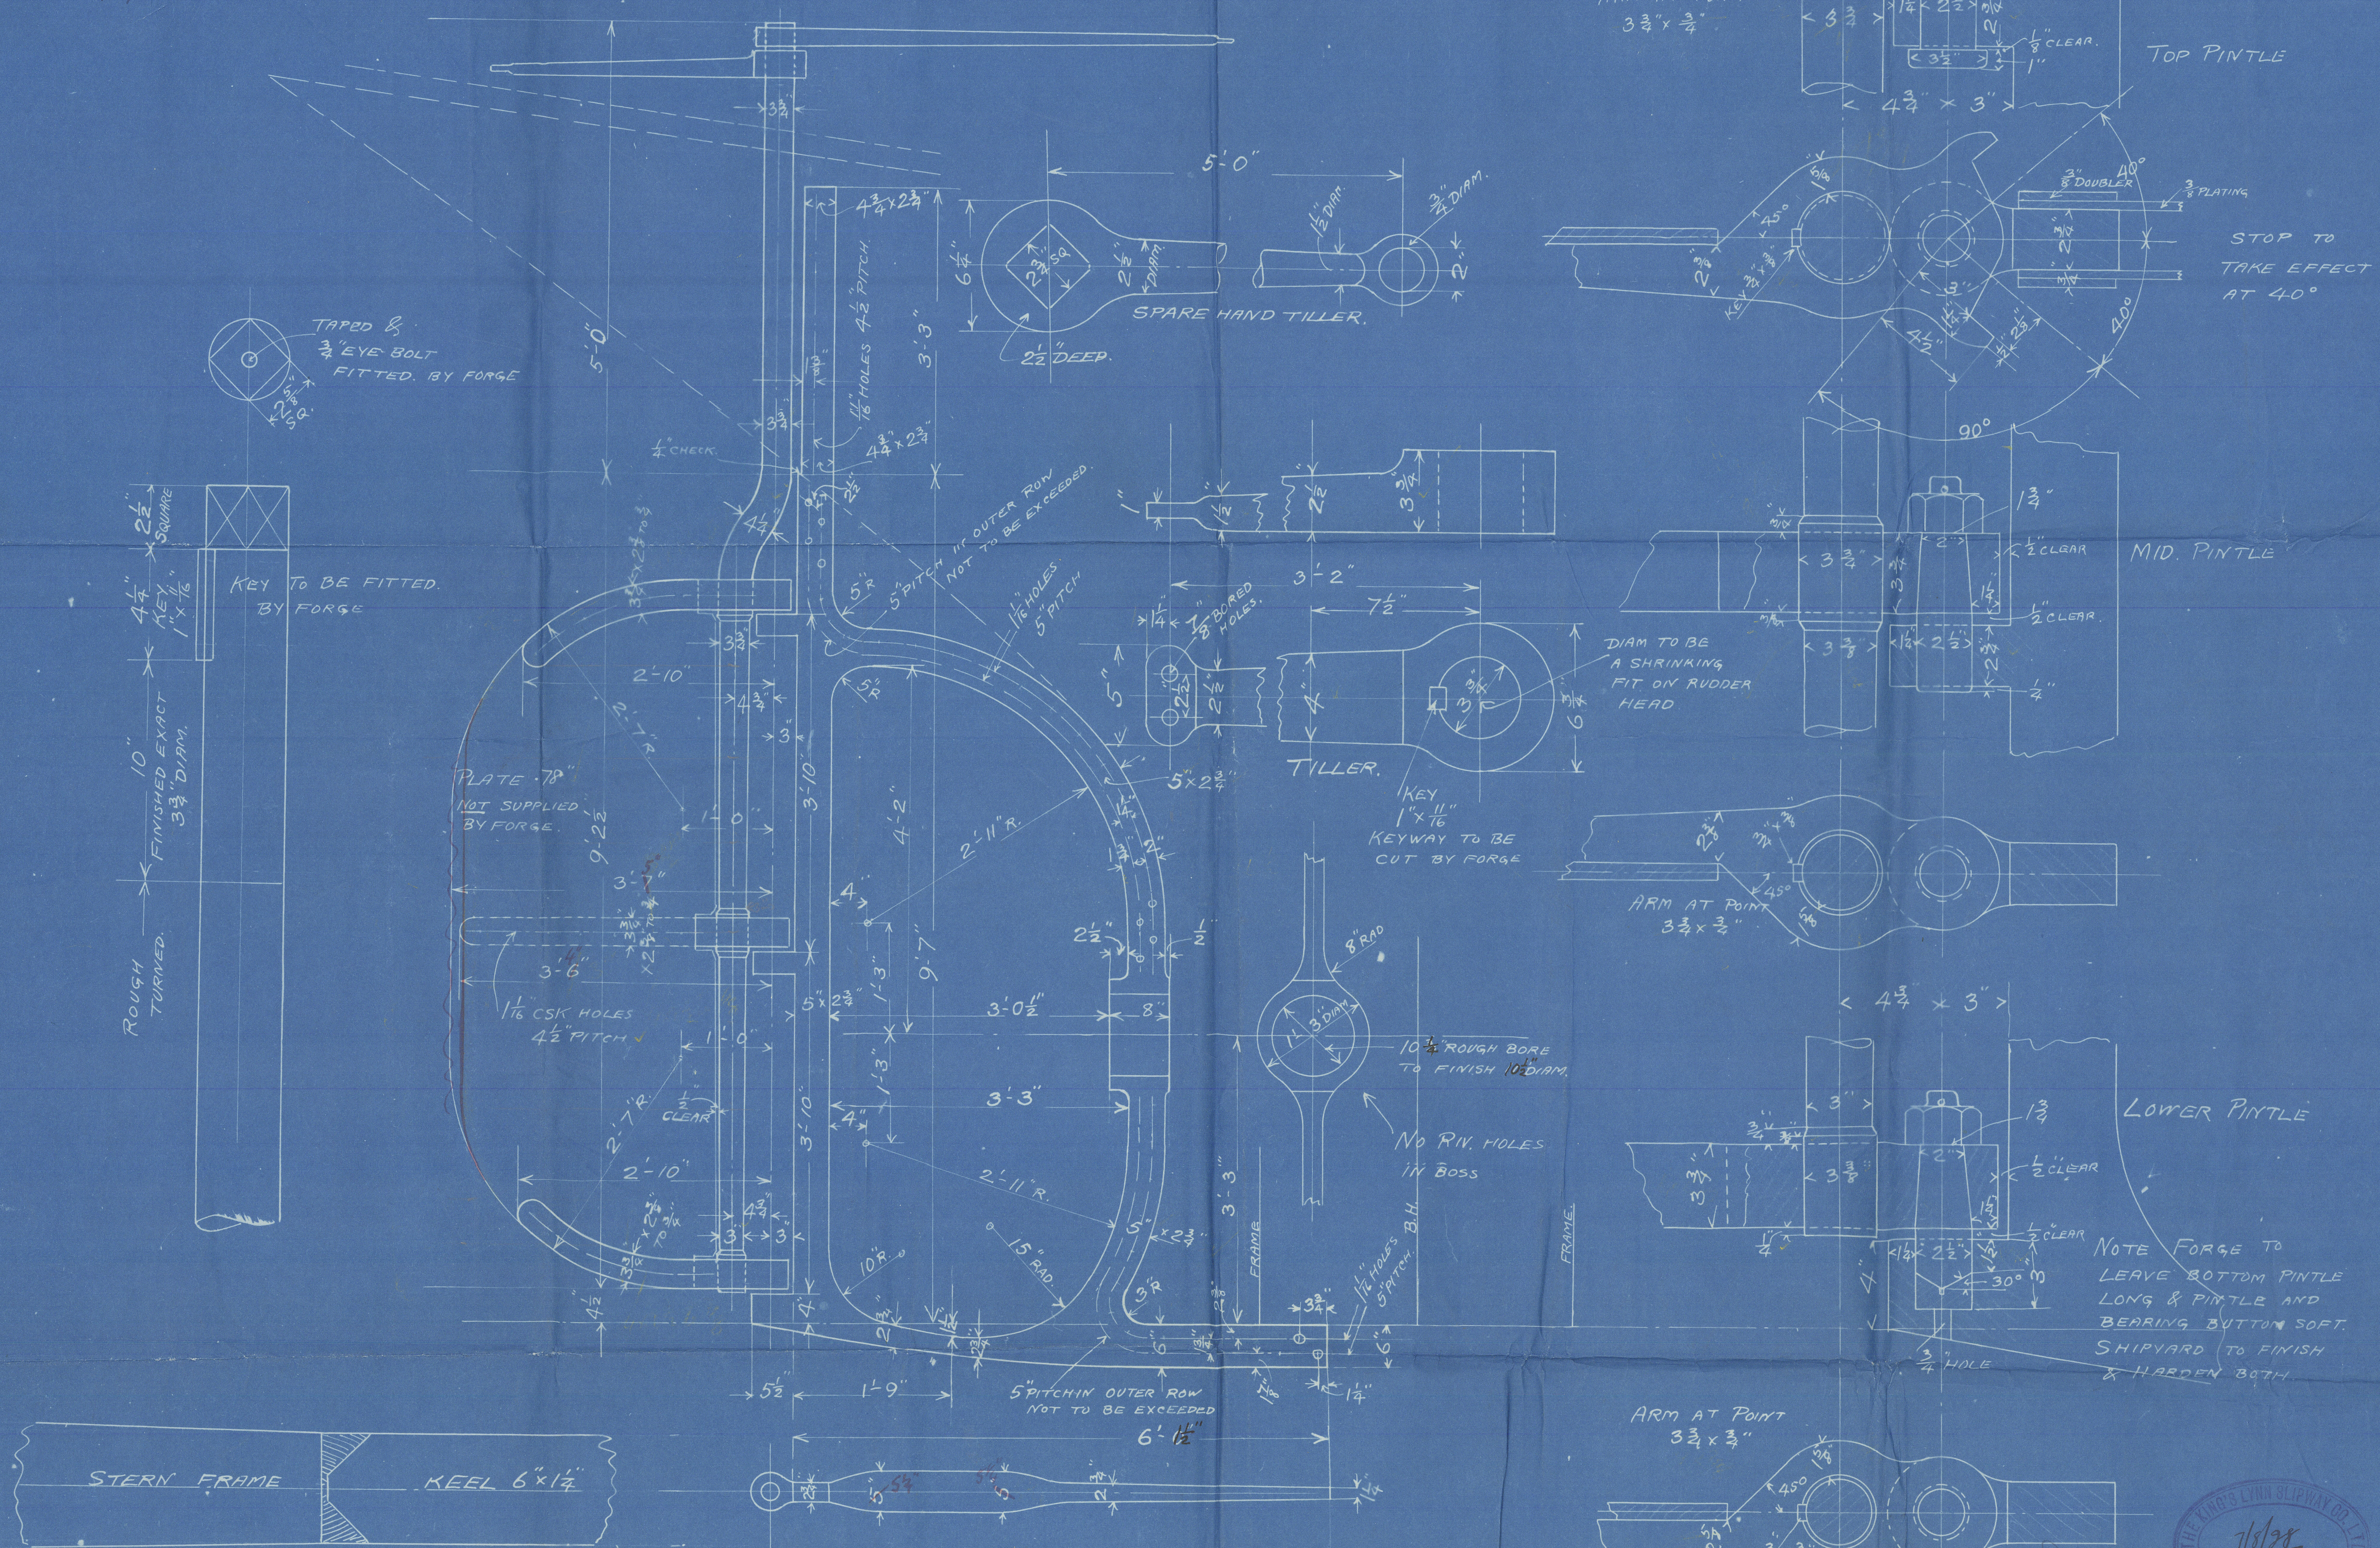

# FORCINGS

WROT. IRON OR STEEL TO LLOYDS CLASS 100A "TRAWLER"  
 SCALES 1" & 3" TO 1 FT.

$$A \cdot D = 22.8 \times 1.75 = 39.9$$

YN<sup>o</sup> 249/50

PN<sup>o</sup> 794-A



Kings Lynn Shipway Co.  
YARD. Nos. 249-50

---

Stem + Rudded Frames  
+ Tiller.

$\frac{8}{5}$  "Angel"

London Report No. 94107

010766-010776-0047



© 2021

Lloyd's Register  
Foundation