

Lloyd's Register of Shipping.


SURVEYS FOR FREEBOARD.

DEC -4 1937

(CONDITIONS OF ASSIGNMENT.)

Ship's Name **"MYTONGATE"** Port of Survey **NEWCASTLE-ON-TYNE**
Official Number **165696** Surveyor's Signature **W.E. Marlborough**
Nationality and Port of Registry ☒ Date of Survey **During construction**

Disposition and dimensions of superstructures, trunks, deckhouses and machinery casings to be inserted in the diagrams and tabular statement:—

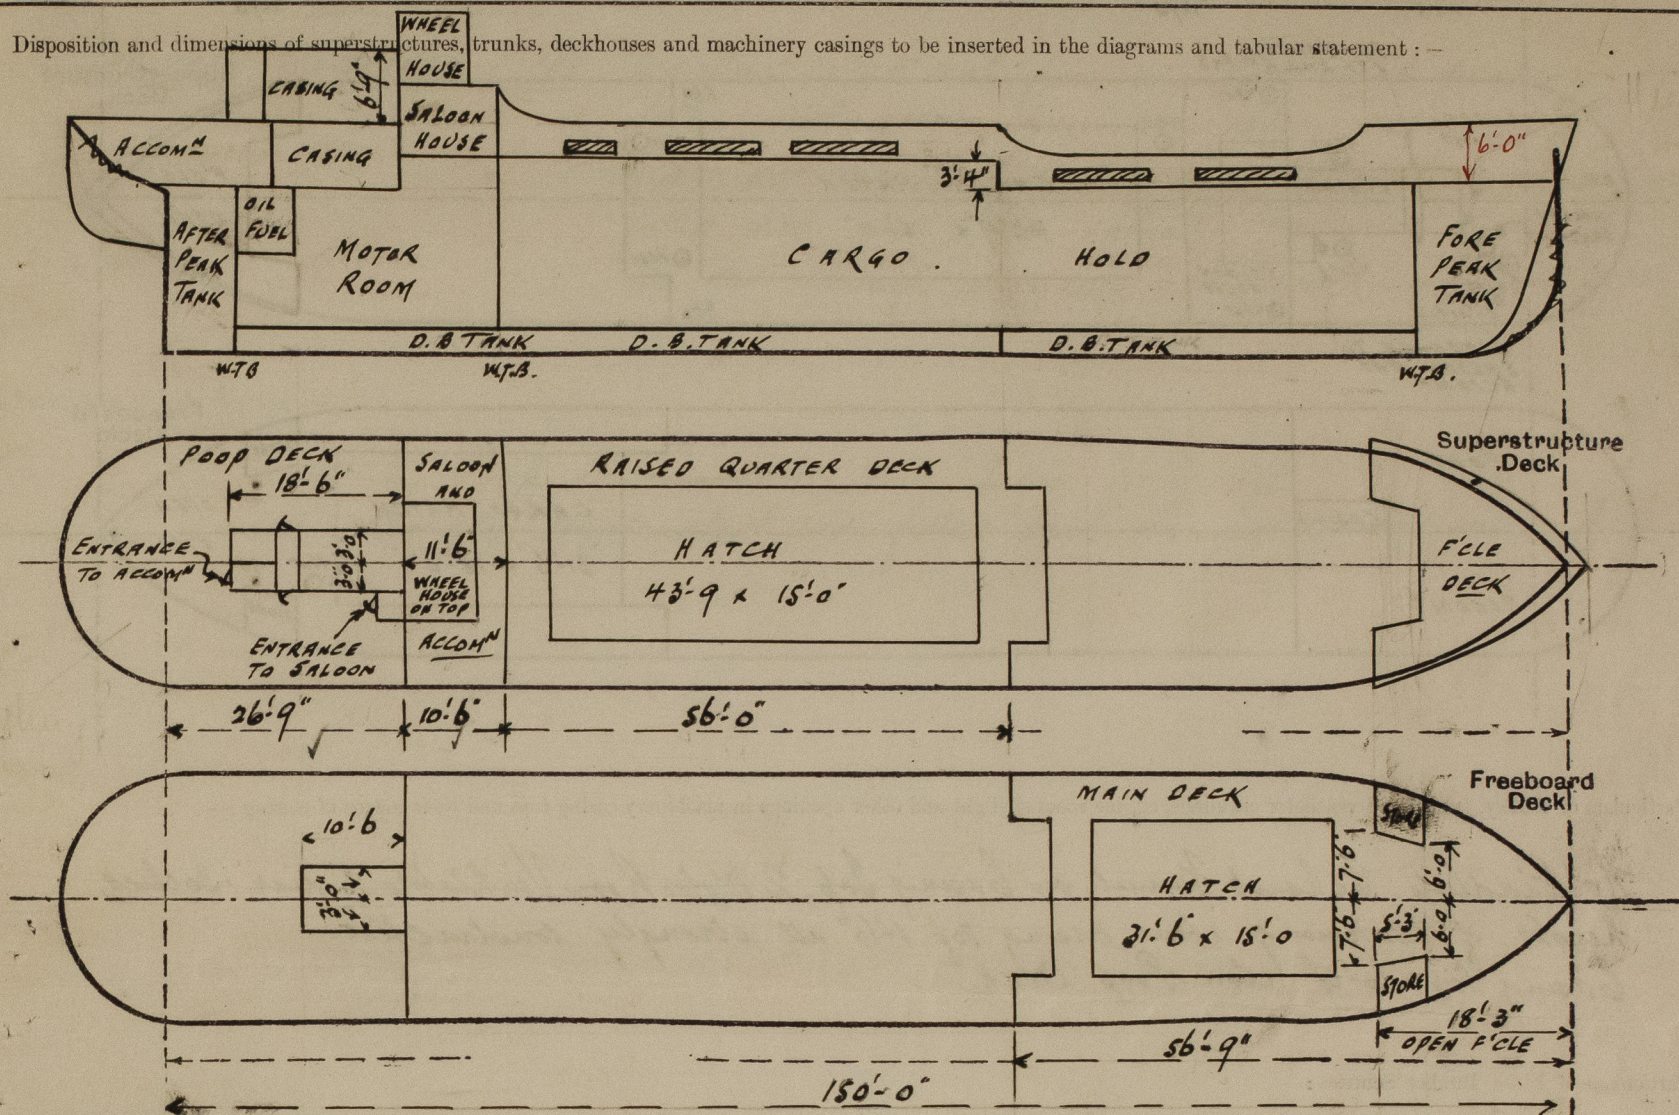

Particulars of Superstructures, Trunks, Casings, Deckhouses.


	Coaming	Plating	Stiffeners	Spacing	End Attachments of Stiffeners	Size of Openings	Height of Sills	Height of Casings
Poop Bulkhead	NONE	25	3" x 2 1/2" x 30	30"	BRACKETED AT TOP	NONE	✓	6'-9" ✓
Raised Quarter Deck Bulkhead ...	NONE	30	3" x 3" x 30	45"	NONE	NONE	✓	3'-4" ✓
Bridge, After Bulkhead			with diaphragms at cr. line and at hatch sides.					
Bridge, Forward Bulkhead								
Forecastle Bulkhead	OPEN	FORECASTLE	✓					
Trunk, Aft								
Trunk, Forward								
Exposed Machinery Casings on Freeboard or Raised Quarter Decks ...	NONE	26	3" x 2 1/2" x 26	24	BRACKETED AT TOP	4'-8" x 1'-11"	19"	6'-9" ✓
Exposed Machinery Casings on Superstructure Decks								
Machinery Casings within Superstructures not fitted with Class I Closing Appliances								
Deckhouses on Flush Deck Ships ...								

Particulars of Closing Appliances (state if capable of being manipulated from both sides).

Poop Bulkhead	NONE No openings
Raised Quarter Deck Bulkhead ...	NONE No openings
Bridge, After Bulkhead	✓
Bridge, Forward Bulkhead	✓
Forecastle Bulkhead	OPEN FORECASTLE ✓
Exposed Machinery Casings on Freeboard or Raised Quarter Decks ..	✓
Exposed Machinery Casings on Superstructure Decks	2 Hinged Deck doors operating from both sides.
Machinery Casings within Superstructures not fitted with Class I Closing Appliances	✓
Deckhouses on Flush Deck Ships ...	✓

Mytongate.

Particulars of Gangway Cargo and Coaling Ports:—

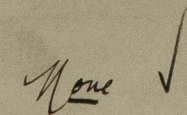

SCUPPERS:- IN FORE WELL 2 each side above deck
ON ROQS DECK 3 " " " "
ON POOP " 1 " " led through shell below Loop Deck.

Particulars of Side Scuttles:—

Fitted to Poop accommodation and Saloon House aft
all strongly constructed and fitted with hinged deadlights. ✓

No Fiddleys, Exhaust Funnel on Casing Top, 2 Motor Room Ventilators 8" dia. 30 chick height of coaming above casing top 1'-6" all strongly constructed. Casing top 6'-9" above Poop Deck. ✓

1 on Loop Deck to Galley Bunker, secured with Bayonet joints, dia^d of opening 18"

Steel Deckhouses on Poop giving access to Saloon accommodation and
cruis quarters. 26 plating, height of sills above wood deck 1'-4" ✓
Hinged Teak doors operating from both sides. ✓

MAIN DECK FOR ²	1 off 11" dead	30 thick, height of Coaming 3'0" To Hold	✓
R. Q ² DECK	2 " 11" "	" " " " 2'6" "	✓
" " "	1 " 11" "	" " " " 6'6" "	Supported by bracket to Post front ✓
POOP "	2 " 8" "	30 " " " 2'9" To ALLEYWAYS	✓
" "	4 " 5" "	Mushroom Vents to accommodation	✓
BRIDGE "	3 " 5" "	" " " "	
" "	2 " 6" "	30 thick, height of Coaming 2'9" to Engine Room	✓

All Coamings of Cowl Ventilators, wood plugs and Canvas covers fitted. ✓

Particulars of Air Pipes in exposed positions on freeboard, raised quarter, or superstructure decks :-				
ON MAIN DECK UNDER F'CLE	1-3"	dead to Fore Peak, height 2'-0" to mouth	✓	fitted under breast plate
" " " "	2-3"	" S.B. Tank " 3'-0"	✓	fitted alongside F'cl House
" R ^d Q ^d DECK	2-3"	" S.B. Tank " 2'-6"	✓	" " Bulwark
" POOP "	1-3"	" After Peak Tank " 1'-6"	✓	" " at Stem.
" CASING TOP	1-3"	" Oil fuel Bunker		

all fitted with wood plugs except air pipe from oil fuel Bunker which has gauge on mouth. ✓

Vertical distance of Sill of lowest Side Scuttle above top of keel..... 16'-0"

on Forecastle Deck, 2 Iron Rails, 3' 0" high, stanchions spaced 5' 0" apart
on Loop " 3 " " 3' 2 1/2 " " " 4' 9" "

Painted eyes on Bridge front and Foucault Beam.
Steel wire lifelines fitted with stretching screws. ✓

© 2021
Lloyd's Register
Foundation

PARTICULARS OF PROTECTION TO OPENINGS, ETC.

HATCHWAYS ON FREEBOARD AND SUPERSTRUCTURE DECKS.									
MAIN DECK RAISED QUARTER DECK									
Description of Hatchway	NO 1	NO 2	✓			
Dimensions of Hatchway	31'-6" x 15'-0"	43'-9" x 15'-0"				
COAMINGS	{	Height above Deck	SIDES ...	3'-3" AT FORE END 4'-9" AT AFTER END	2'-6"				
		Thickness	Sides40	.40				
			Ends40	.40				
		Stiffeners	...	4" x 3" x .365	4" x 3" x .365				
		Brackets, Stays	...	6" x 3" x .365 SPACED 4'-10 1/2"	6" x 3" x .365 SPACED 8'-9"				
HATCH BEAMS	{	Number	...	8	11				
		Spacing	...	3'-6"	3'-4 3/4"				
		Scantling and Sketch	...	3" x 3" x .38	3" x 3" x .38				
		Bearing Surface	...	3" ✓	3" ✓				
FORE AND AFTERS	{	Number	...						
		Spacing	...						
		Unsupported Lengths	...						
		Scantling* and Sketch	...	NONE	NONE ✓				
		Bearing Surface	...						
HATCH COVERS	{	Material	...	W.P.	W.P.				
		Thickness	...	2 1/2"	2 1/2"				
		How fitted	...	F.T.A. ✓	F.T.A. ✓				
		Bearing Surface	...	3" ✓	3" ✓				
Spacing of Cleats	24"	24"				
Number of Tarpaulins	2 ✓	2 ✓				
*Are wood fore and afters steel shod at all bearing surfaces? ✓ Are battens and wedges efficient and in good condition? Yes Are tarpaulins in good condition and in accordance with rule requirements? Yes Are lashings provided in accordance with rule requirements? Yes ✓									

Particulars of any special features:—

This vessel is a pirate ship to M.V. "HULLGATE" built by Cleland (Successors) Ltd
Yard No 35

Endorsement at first survey and at surveys for renewal of Certificate:—

The fittings and appliances are in accordance with the particulars shown on this form (or as now modified) and are in good condition.



© 2021

Lloyd's Register
Foundation