
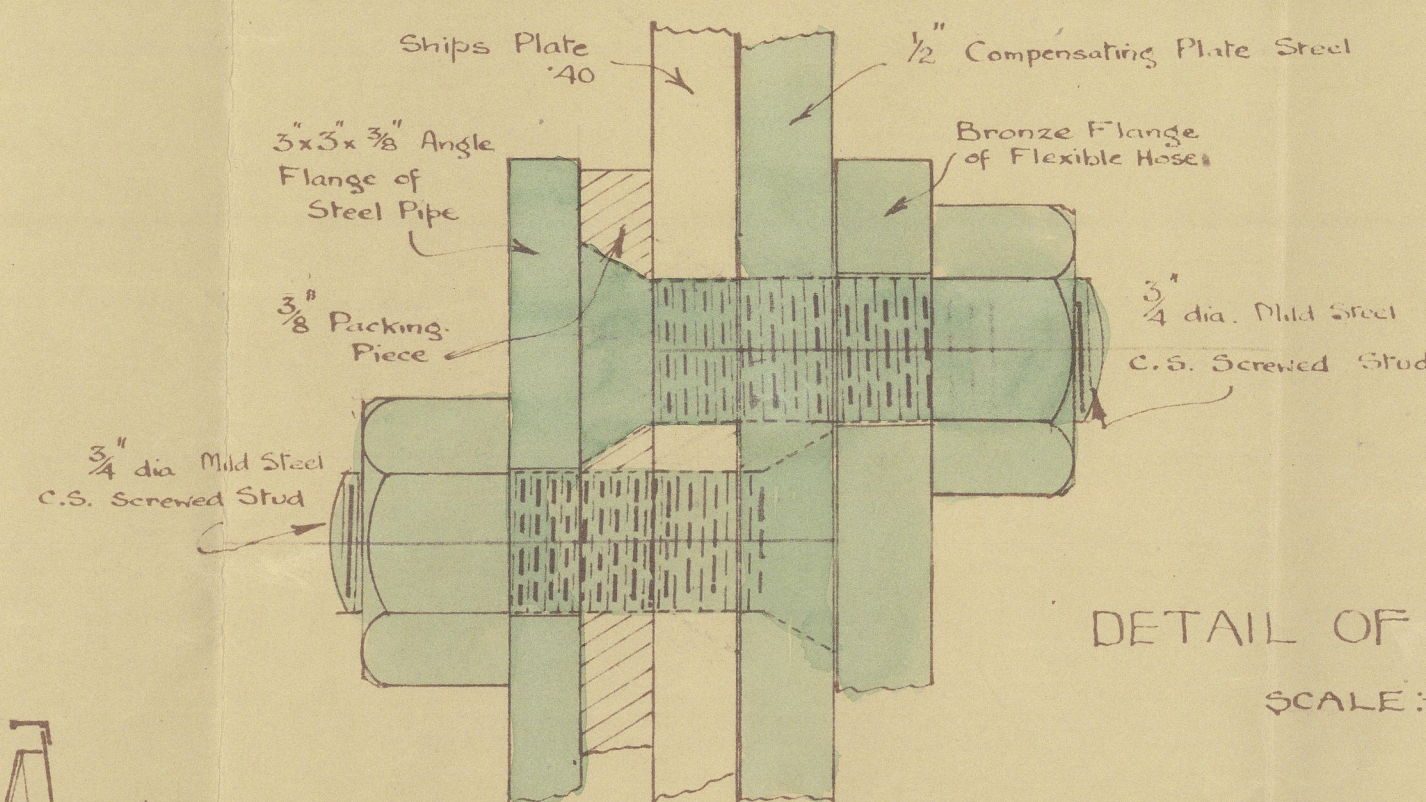


SAND SUCTION DREDGING : INSTALLATION ON DREDGE "OTAKOU"



SECTIONS OF PUMP ROOM

SCALE : 1/2 INCH = 1 FOOT

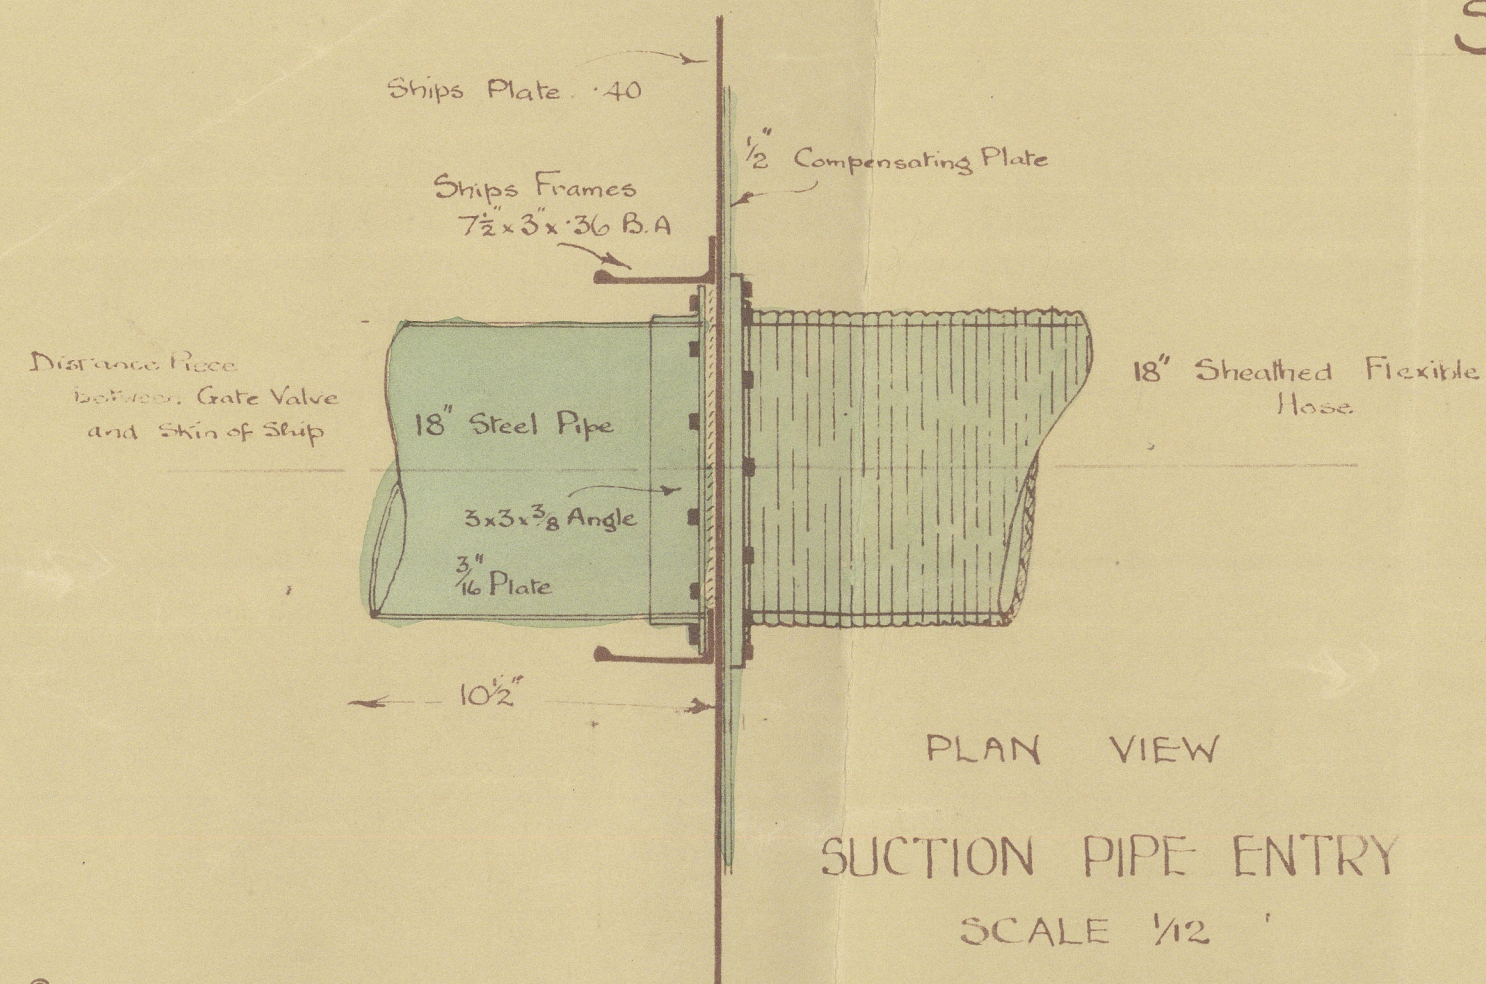


DETAIL OF FASTENING
SCALE : FULL SIZE

SUCTION PIPE ENTRY
SCALE 1/2
ELEVATION

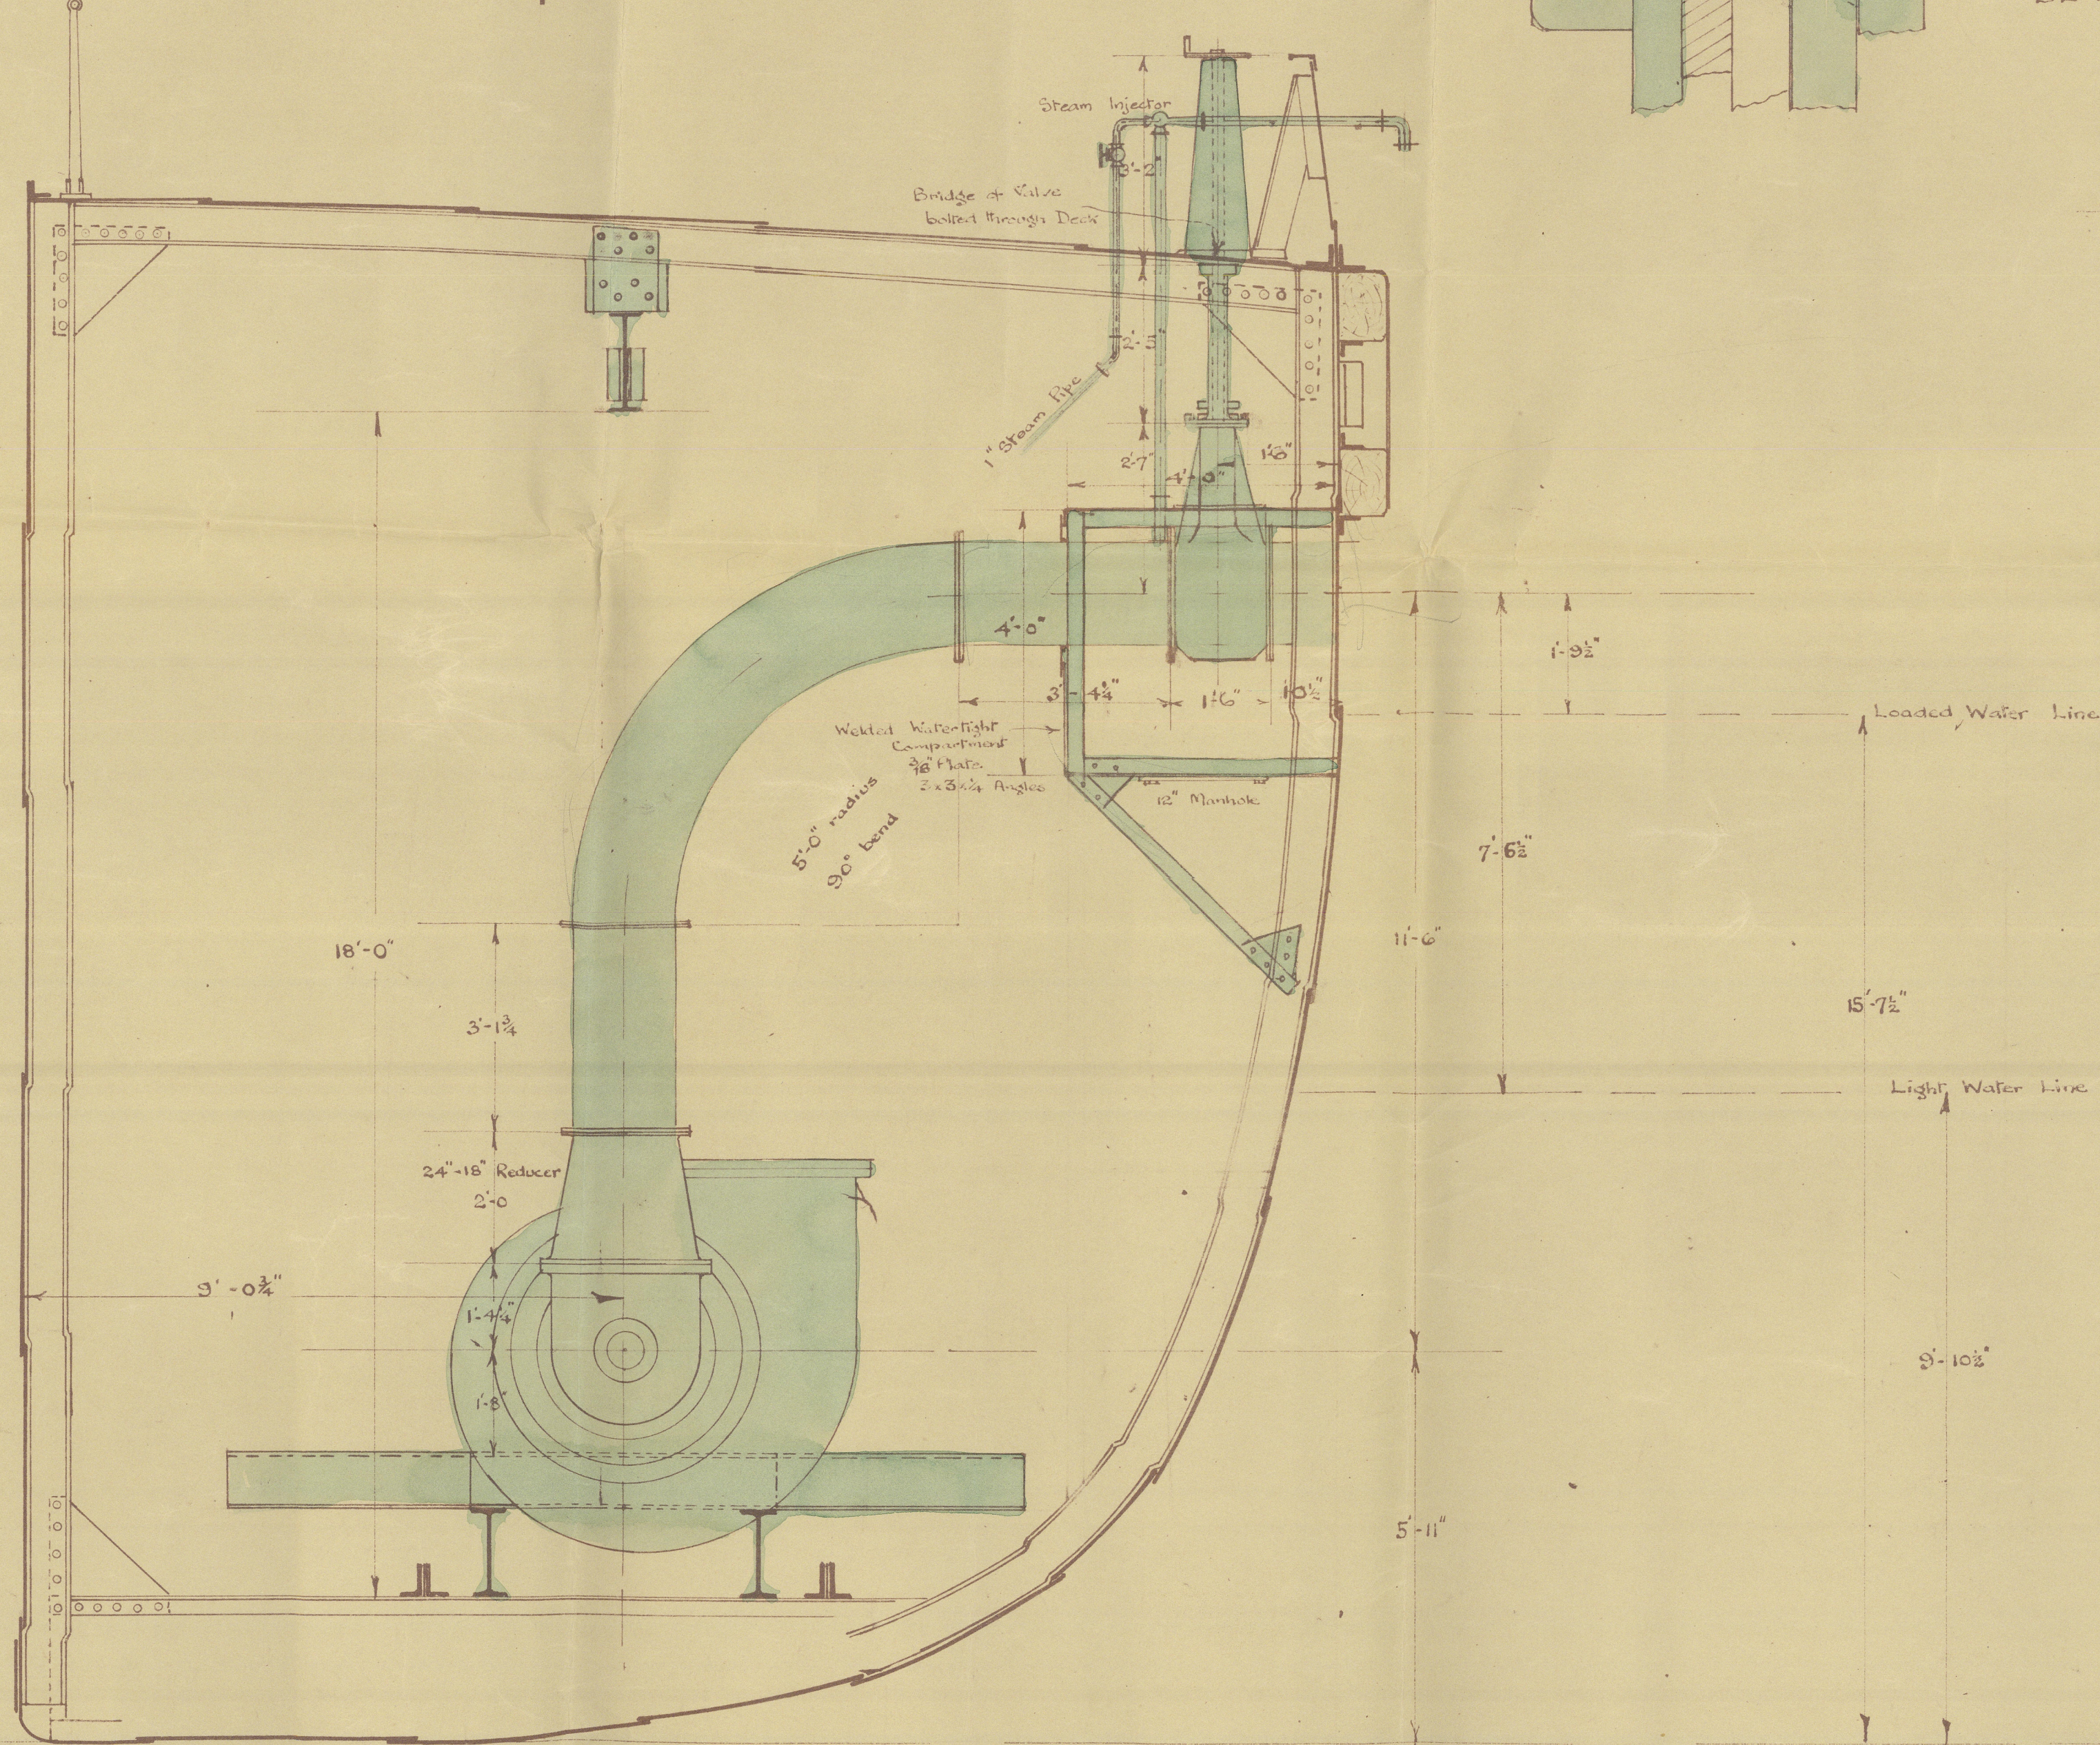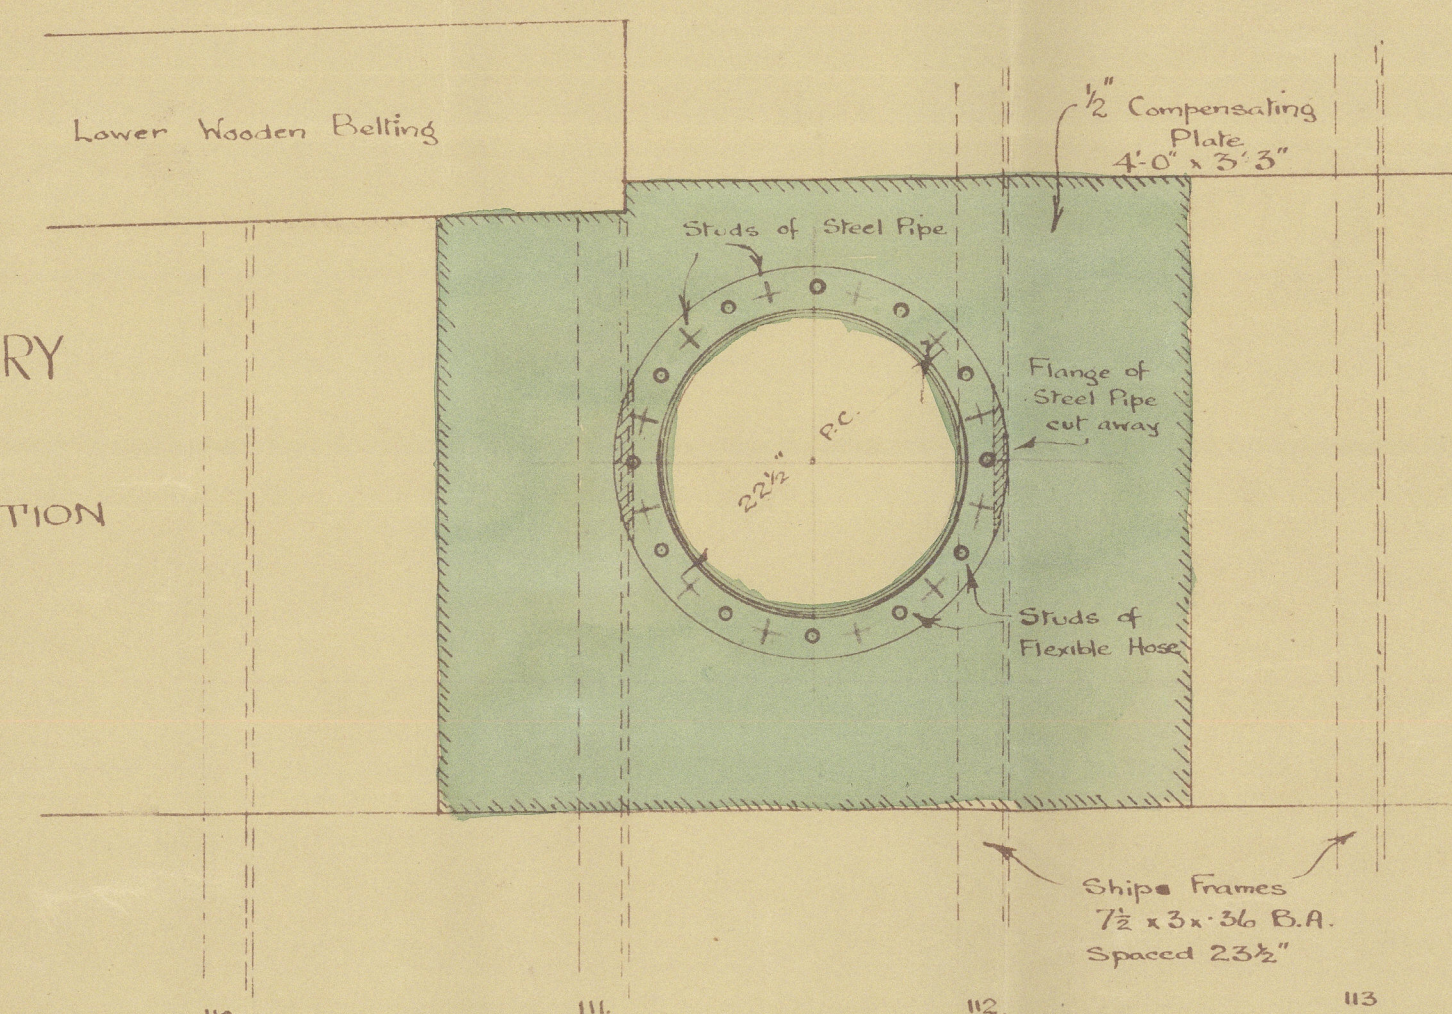

FRAME 112

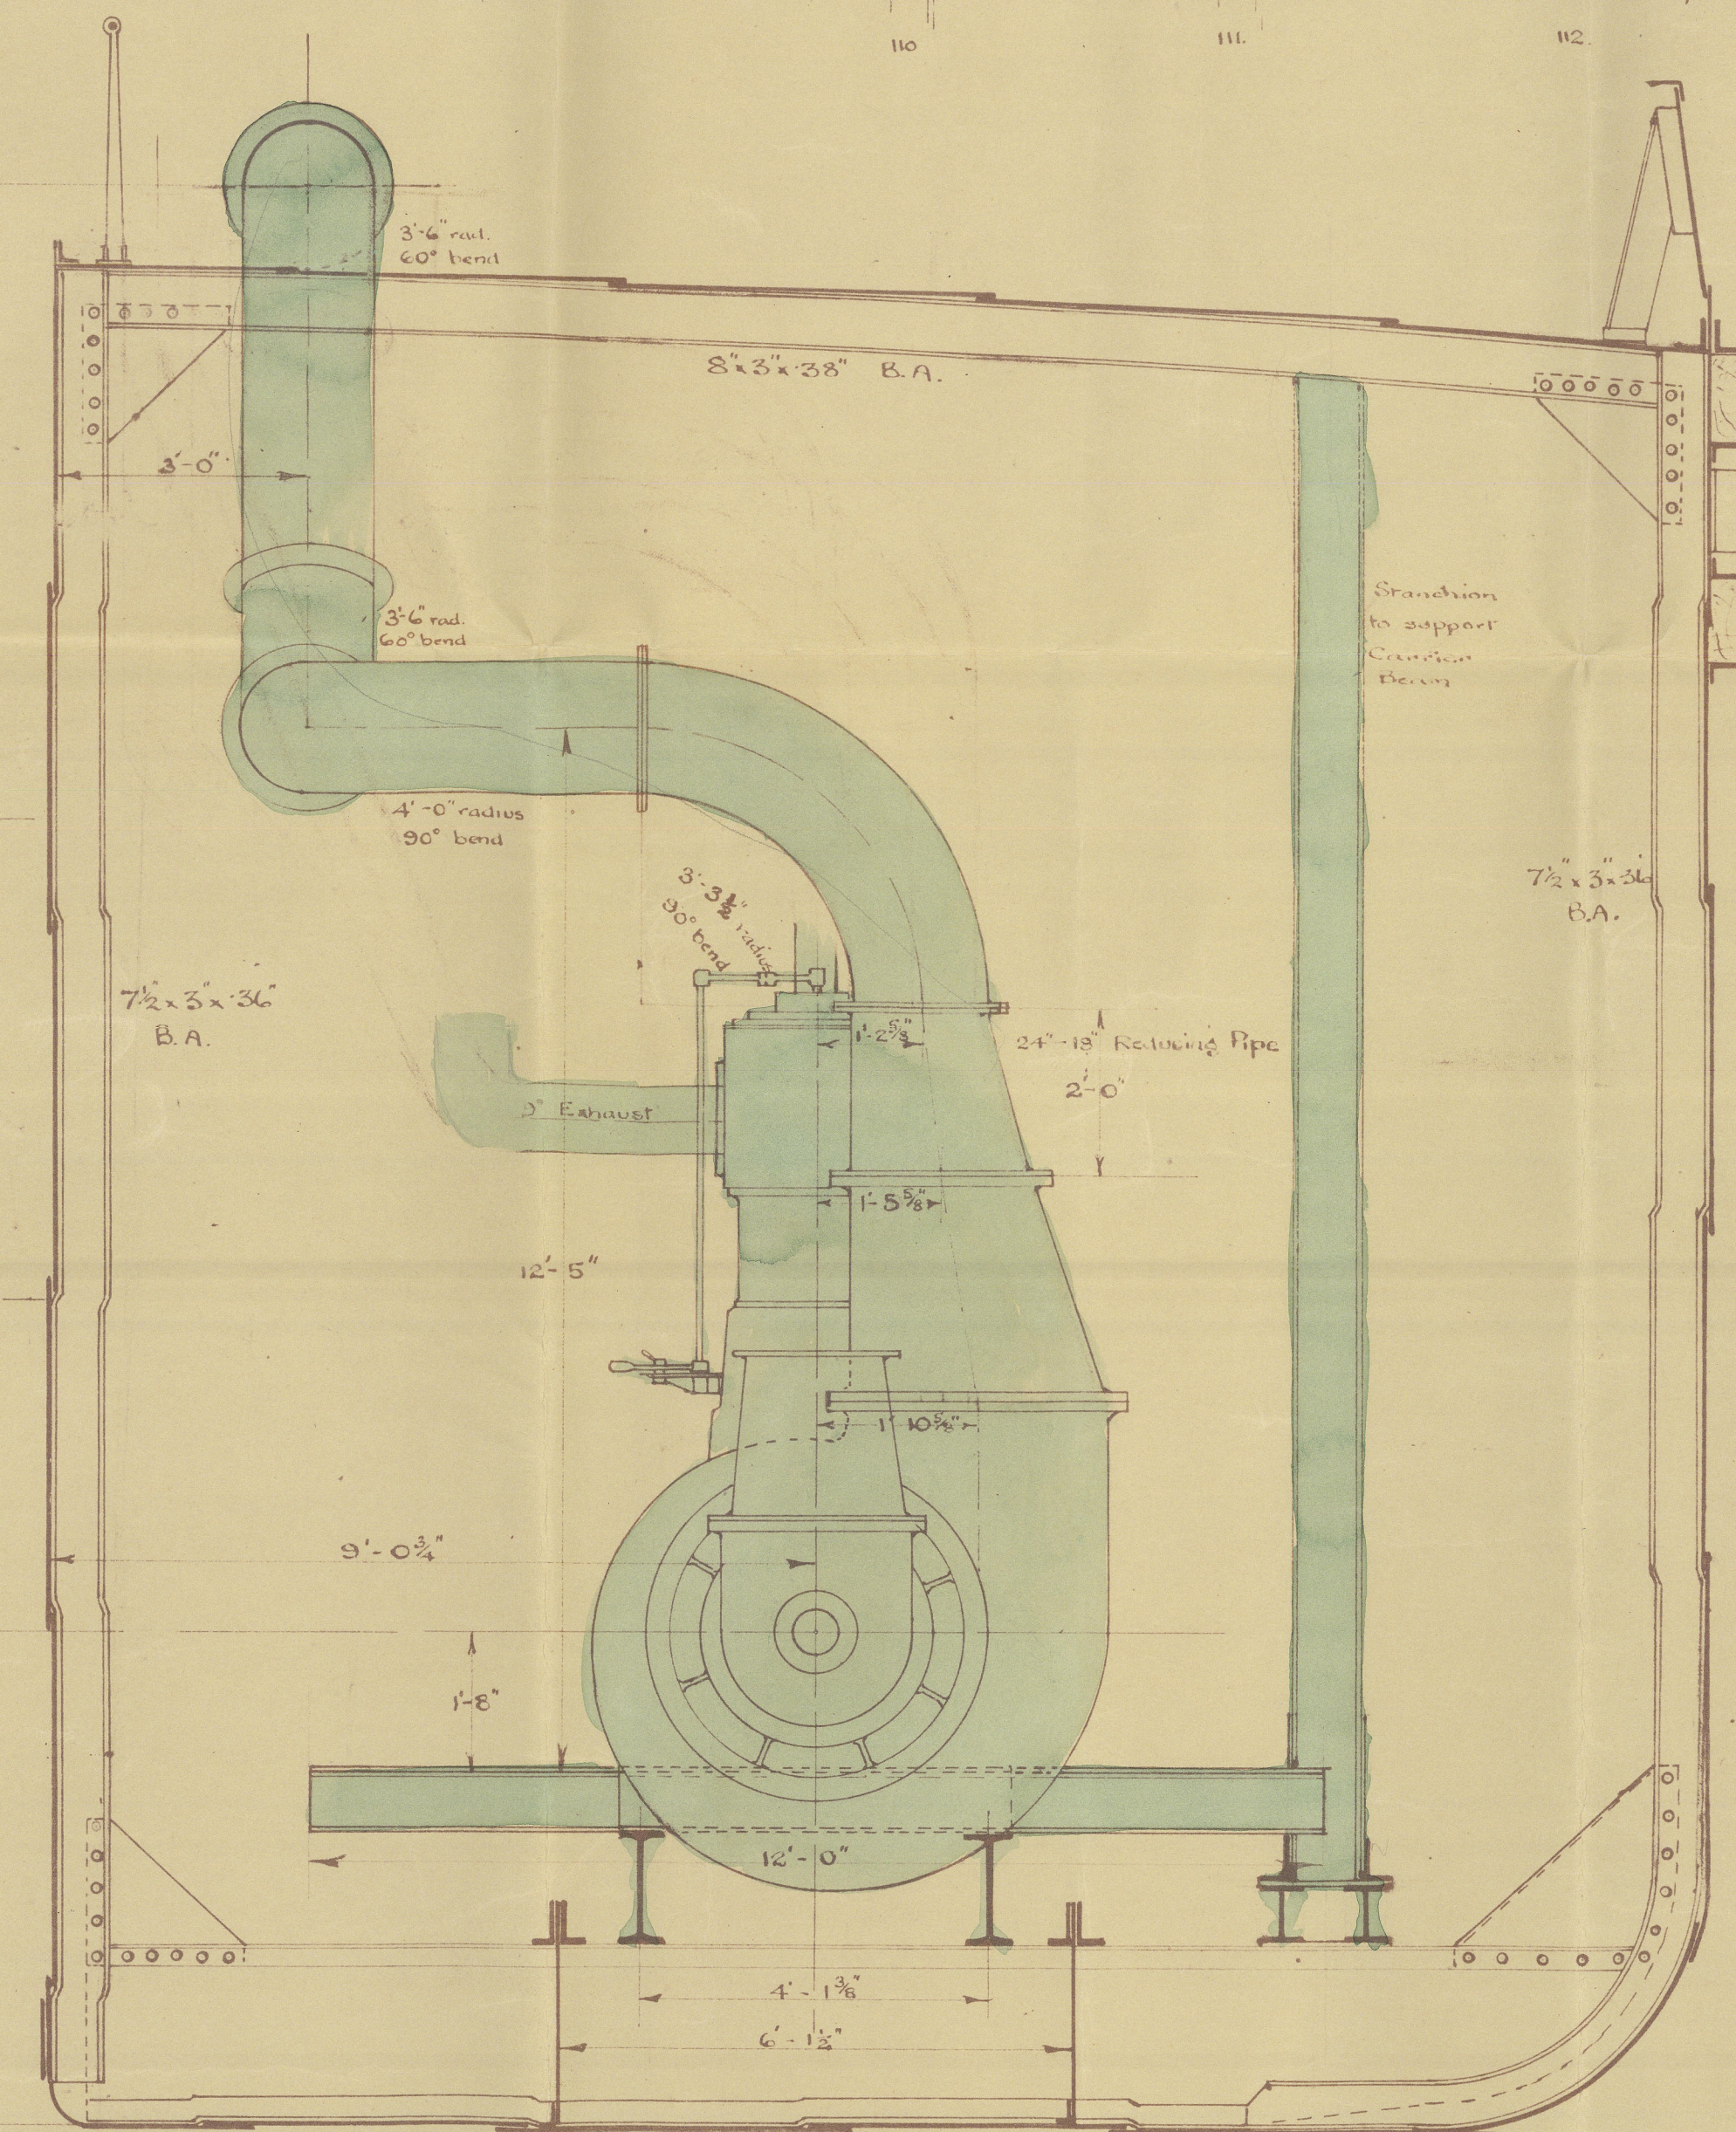

FRAME 100

Noted. J. Mac 27/1/07

E.R.D.

3676