


SECTIONAL ELEVATION



SAND SUCTION DREDGING : INSTALLATION ON DREDGE "OTAKOU"
GENERAL ARRANGEMENT

SCALE : 1/4 INCH = 1 FOOT

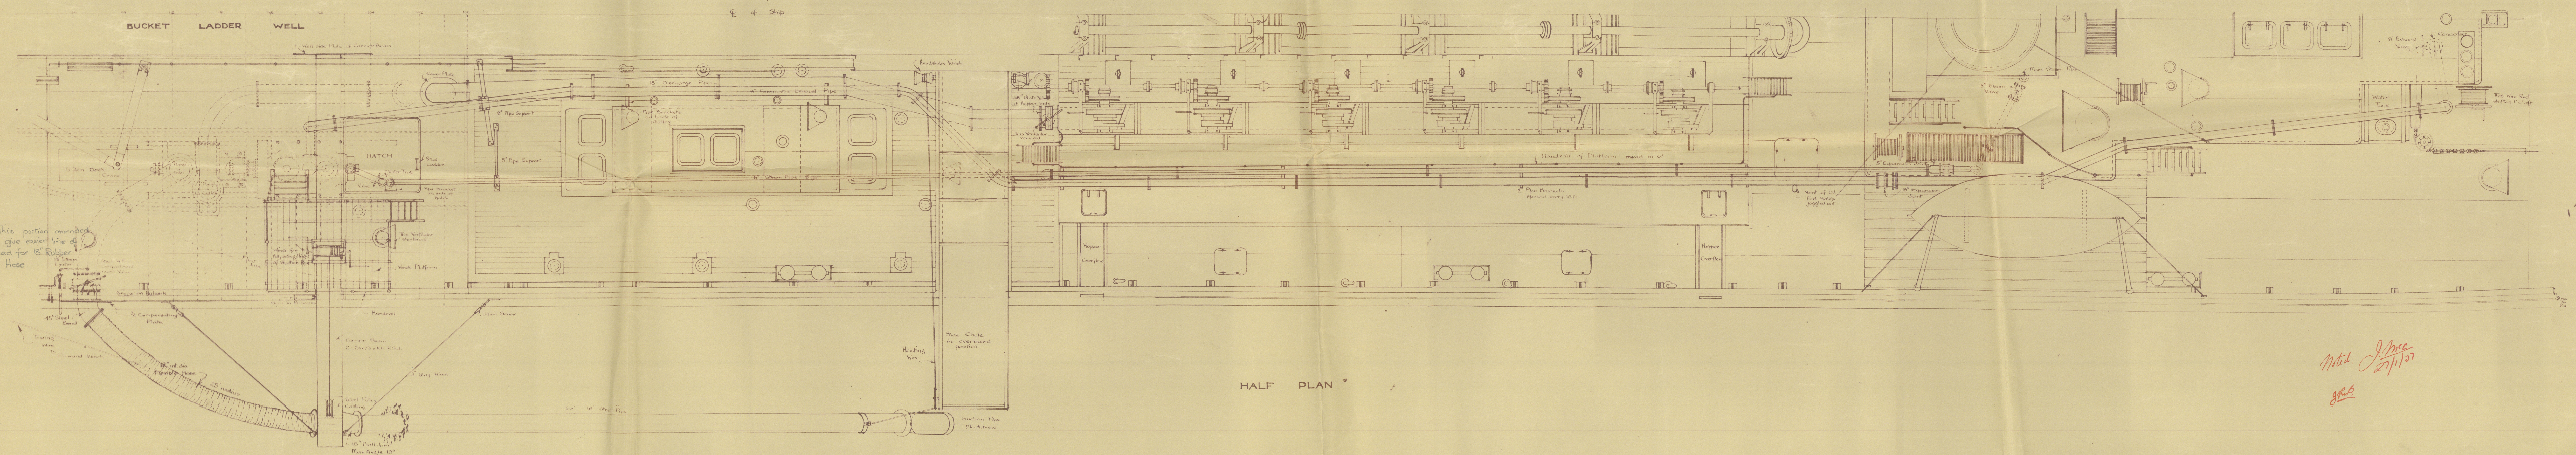

HALF PLAN

Handwritten note:
Note: See
27/1/12
8000

SHEET No 3