

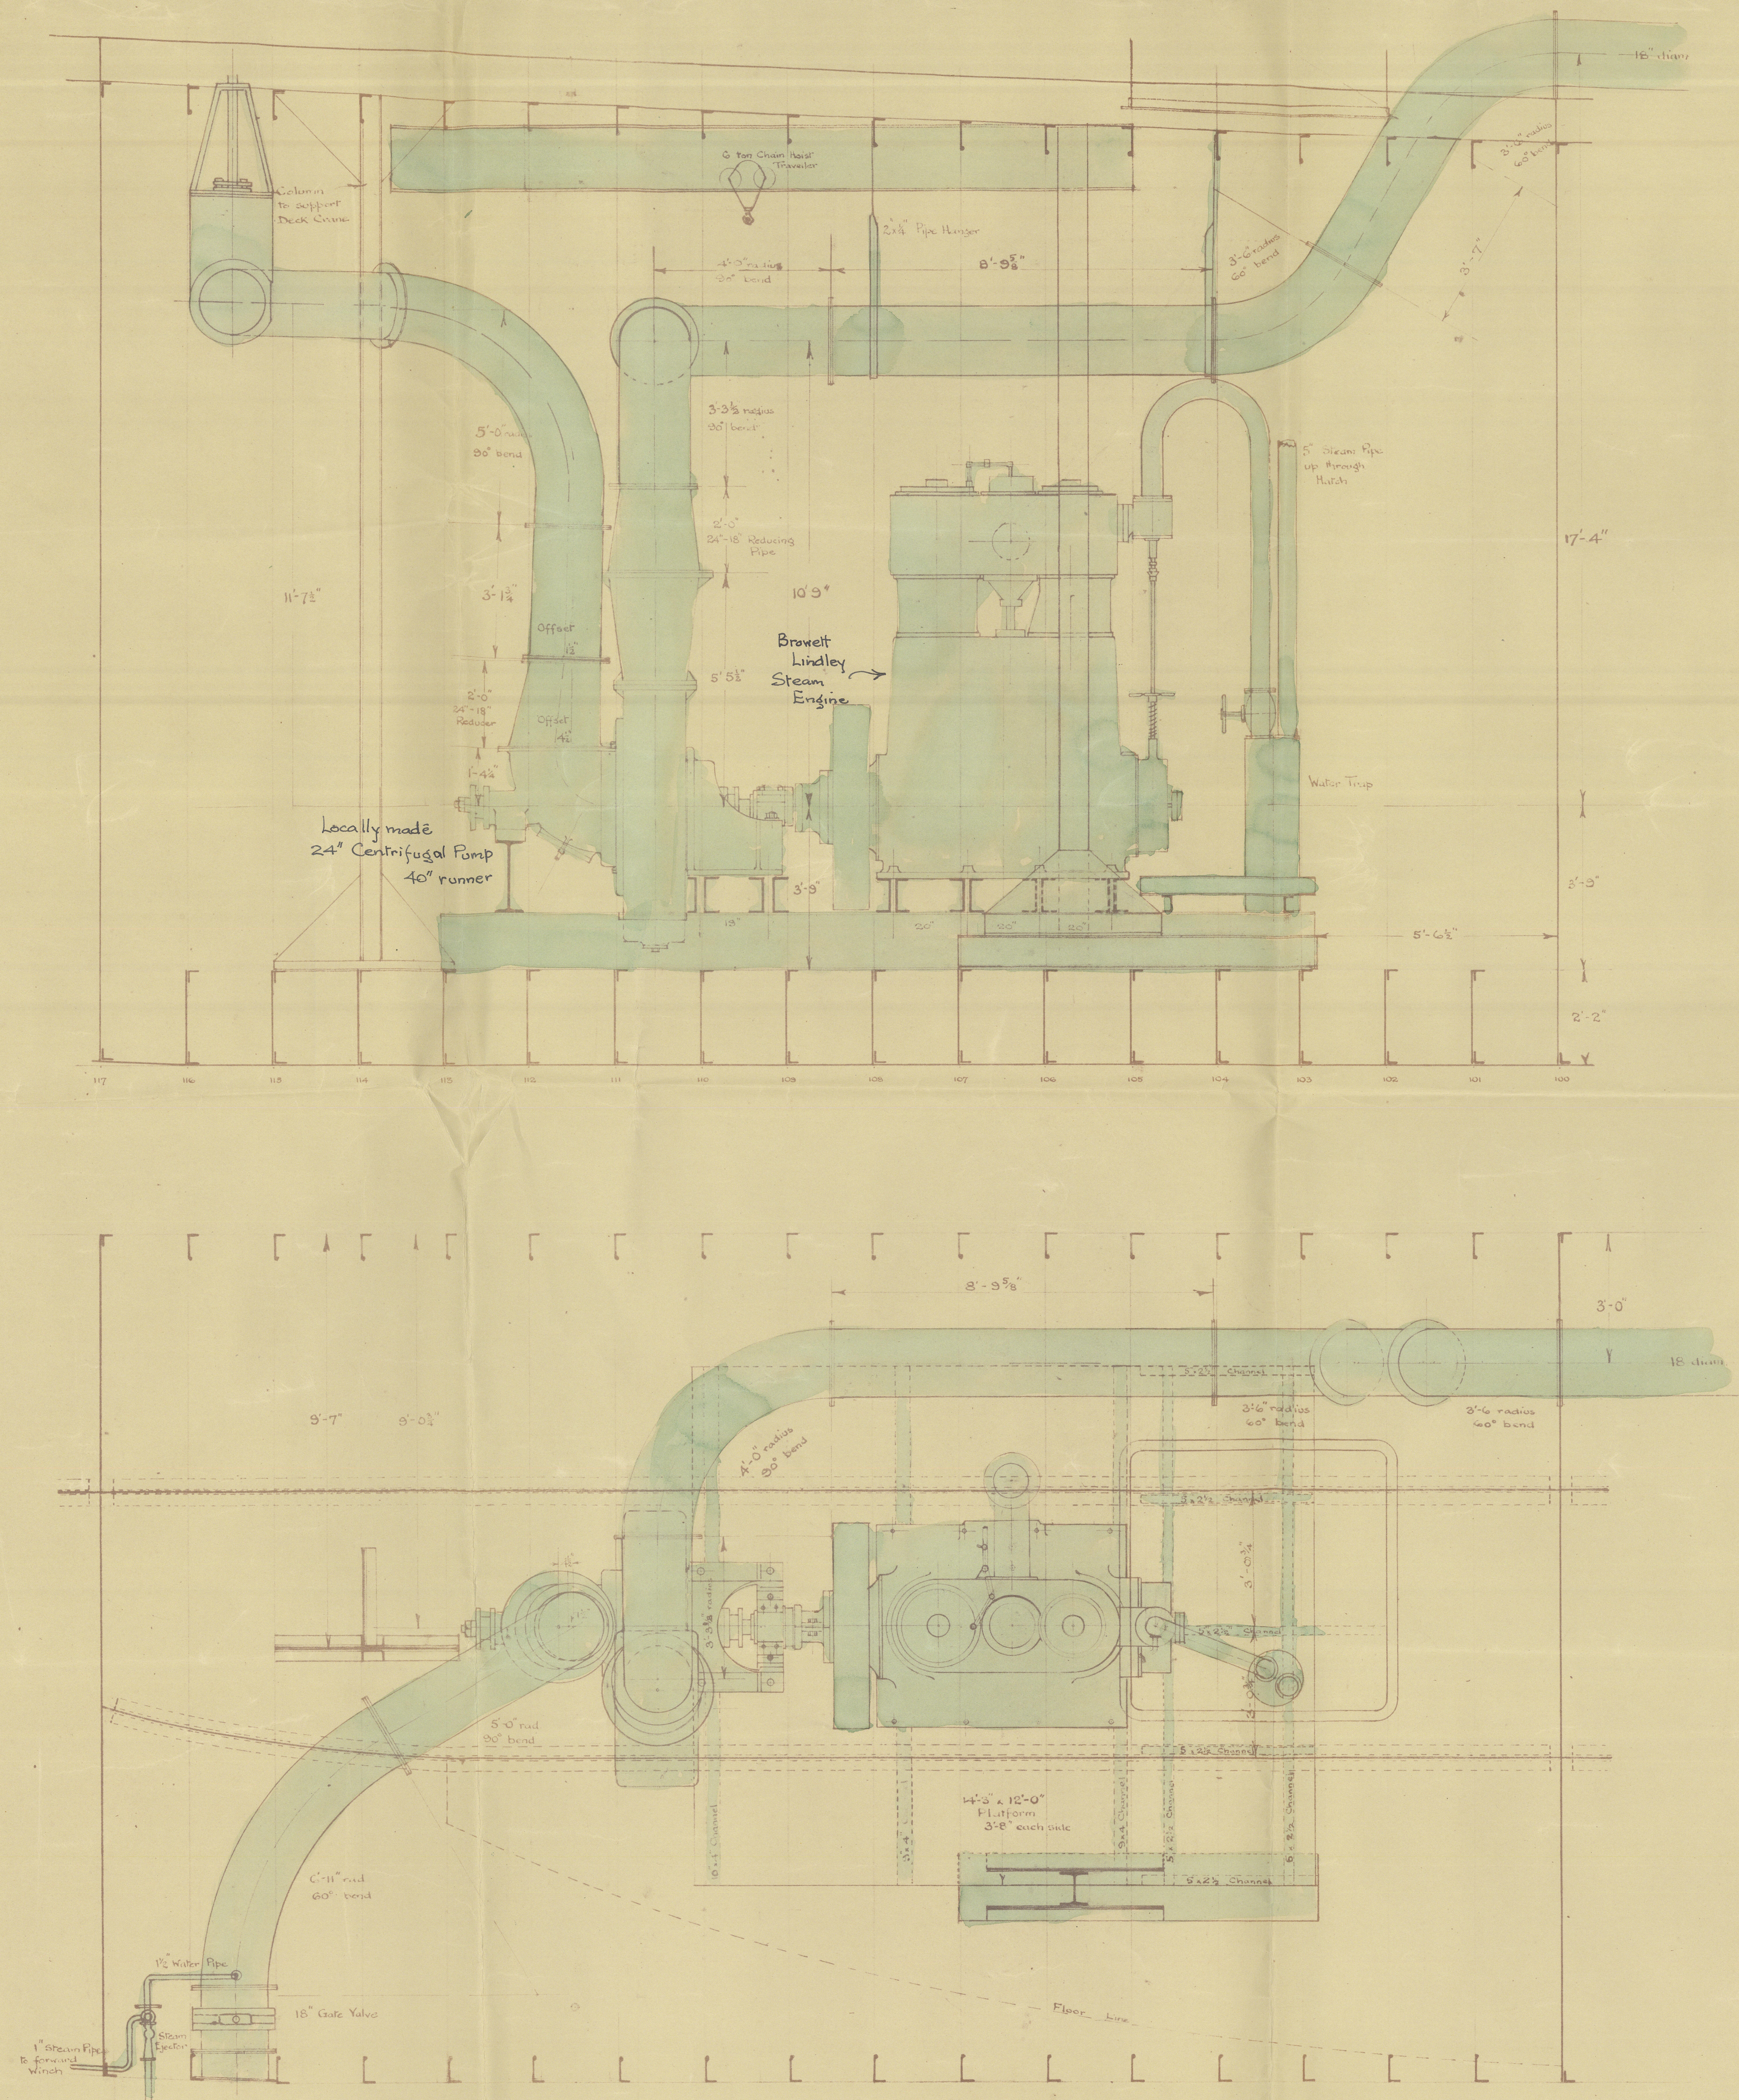


9'98

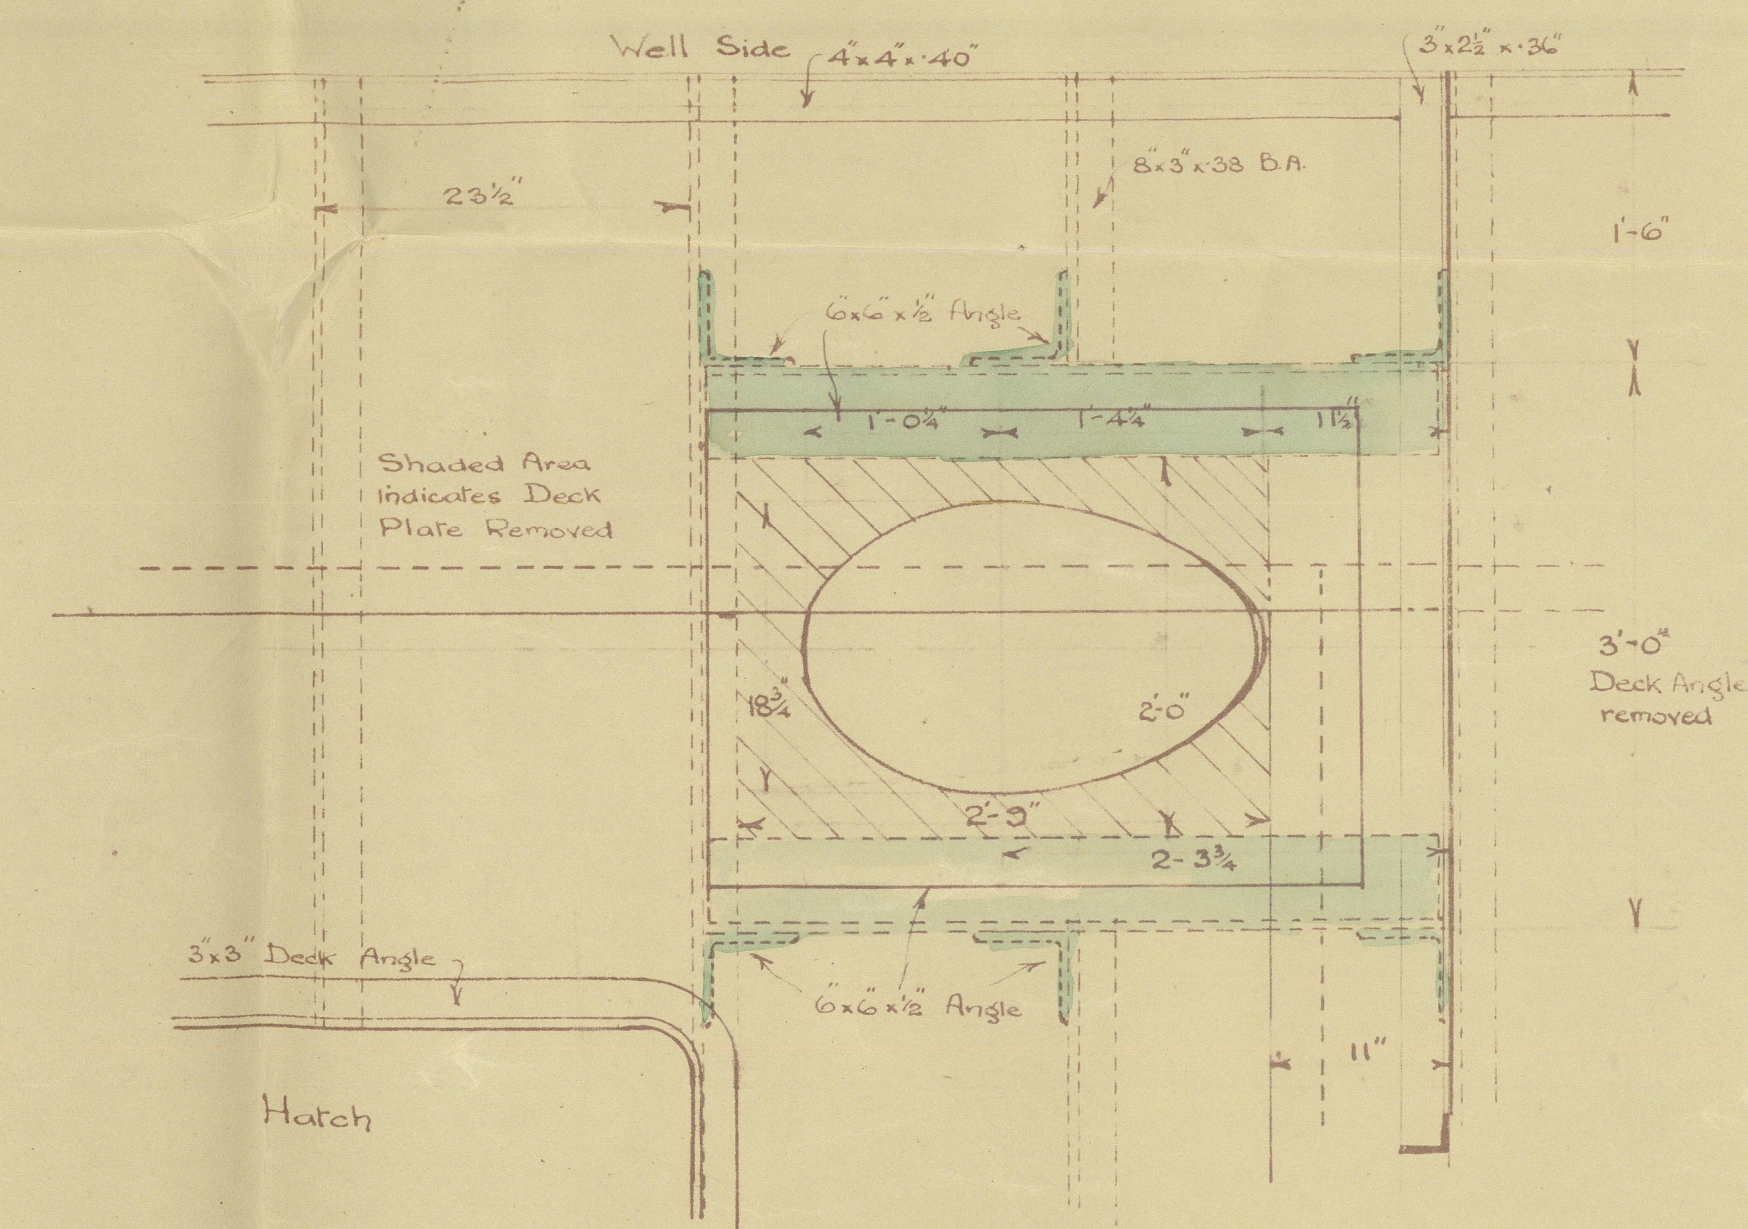


DISCHARGE PIPE
AT DECK
SCALE 1" = 1 FT.

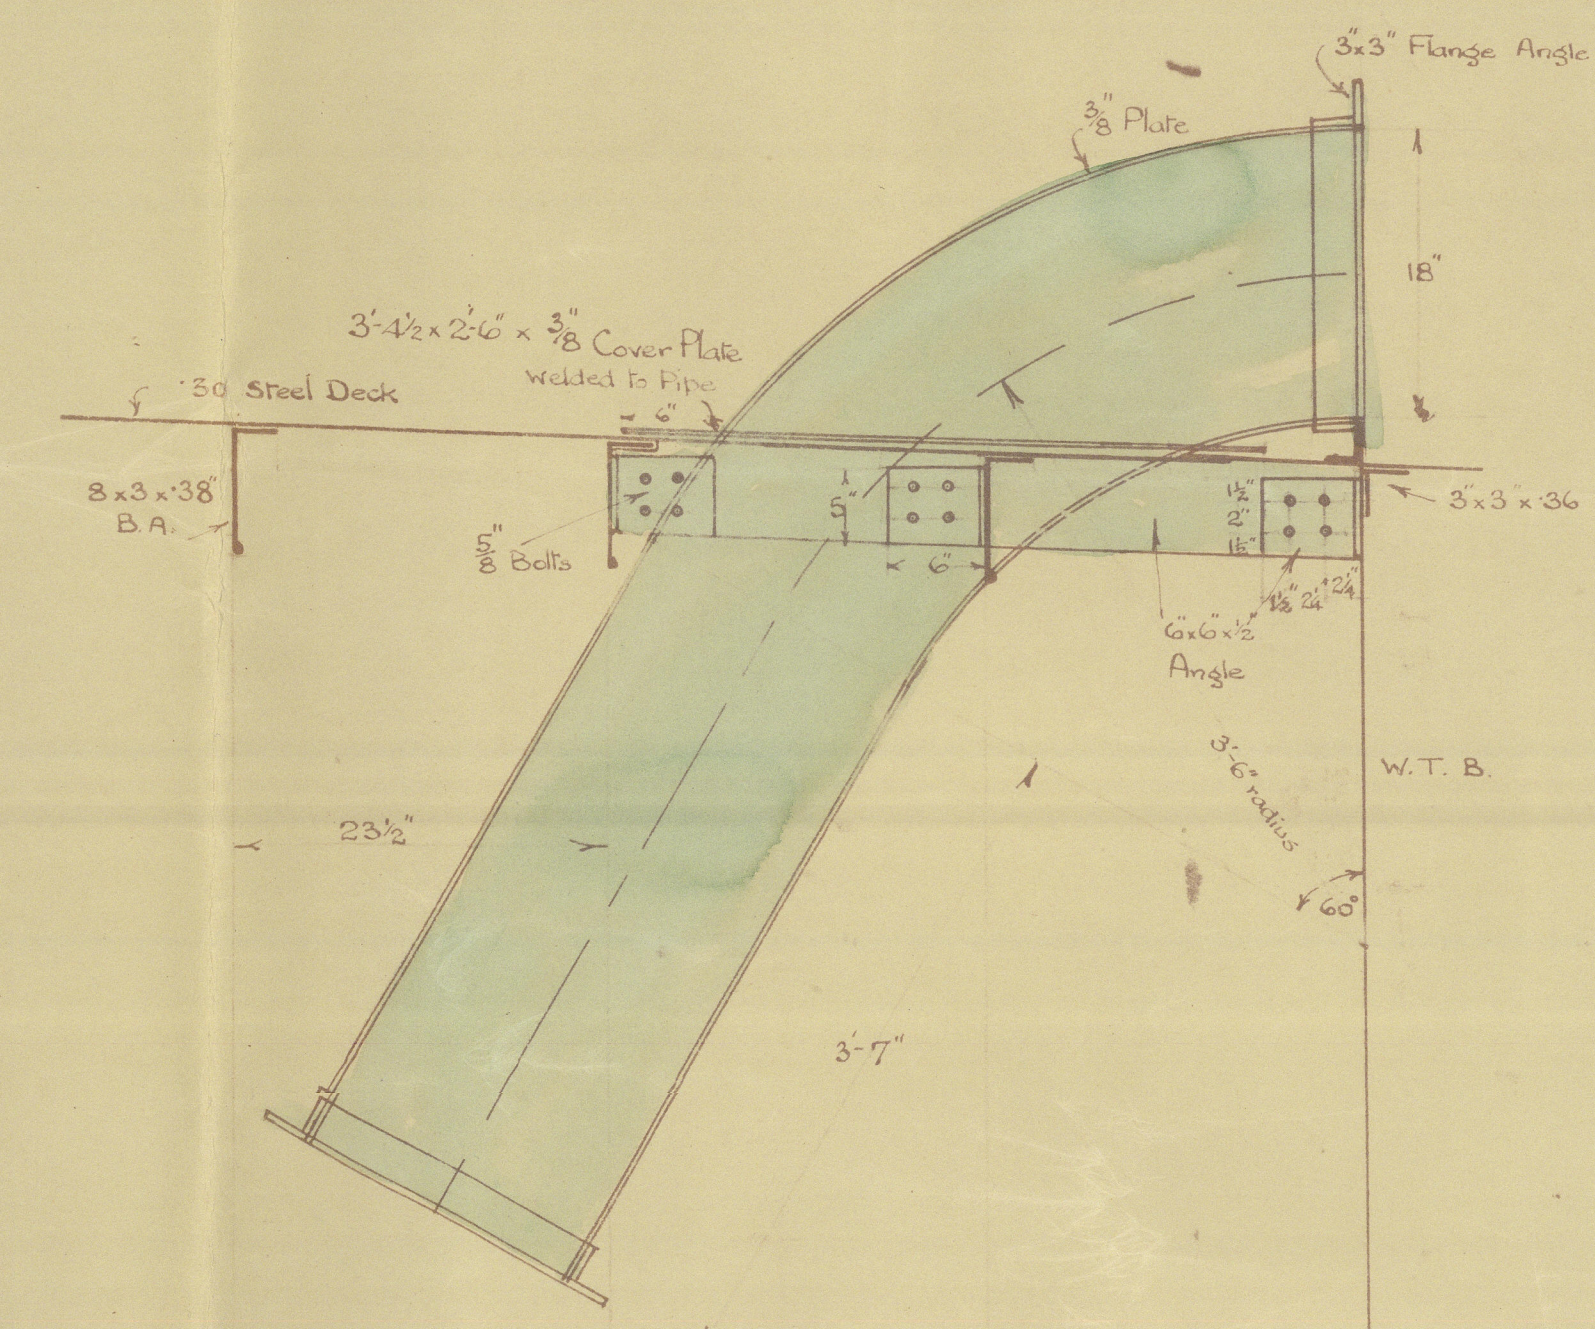

DREDGE OTAKOU
PUMP ROOM ARRANGEMENT

SCALE :- 1/2" = 1 FOOT

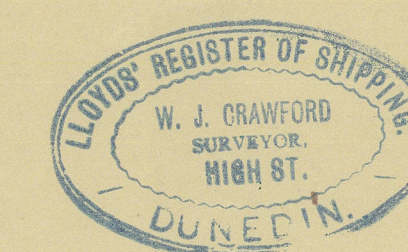

Handwritten notes:
Mtd 2/11/17
8.11.17

3676

SHEET N°4