


SCALE :- 1 INCH = 1 FOOT

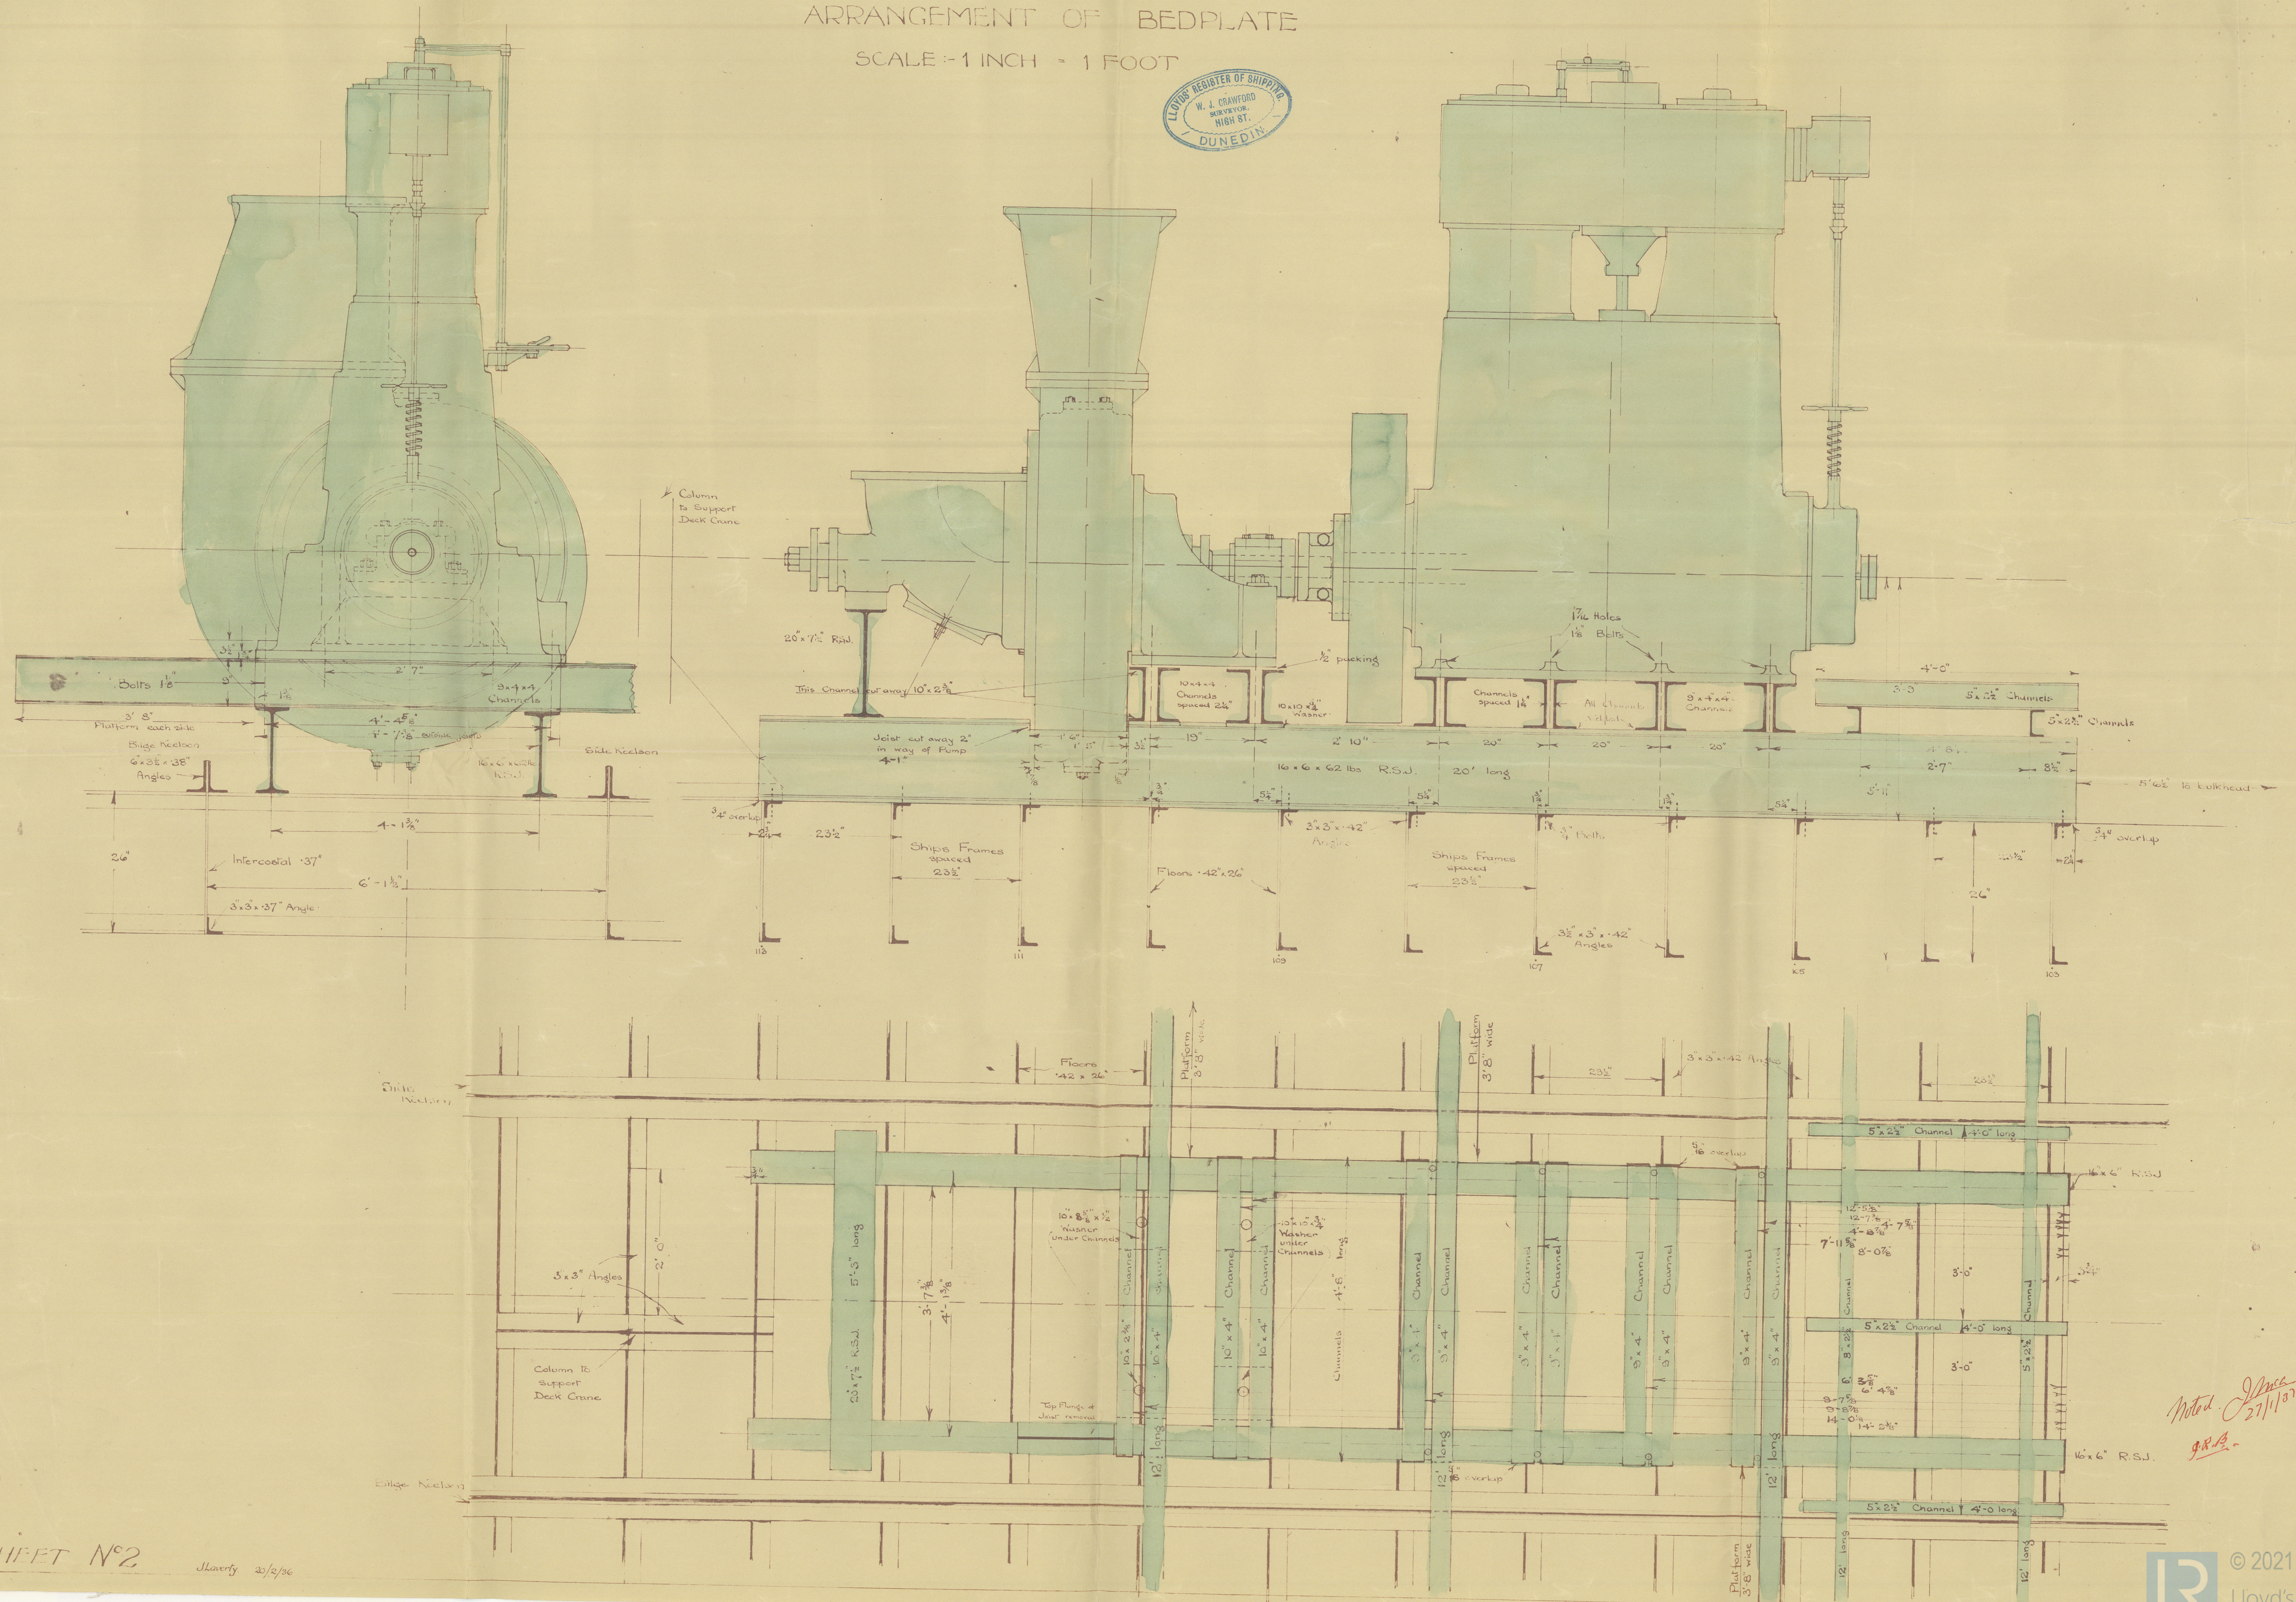

J. Lavery. 20/2/36