


KOCHU-MARU. GENERAL ARRANGEMENT. 200

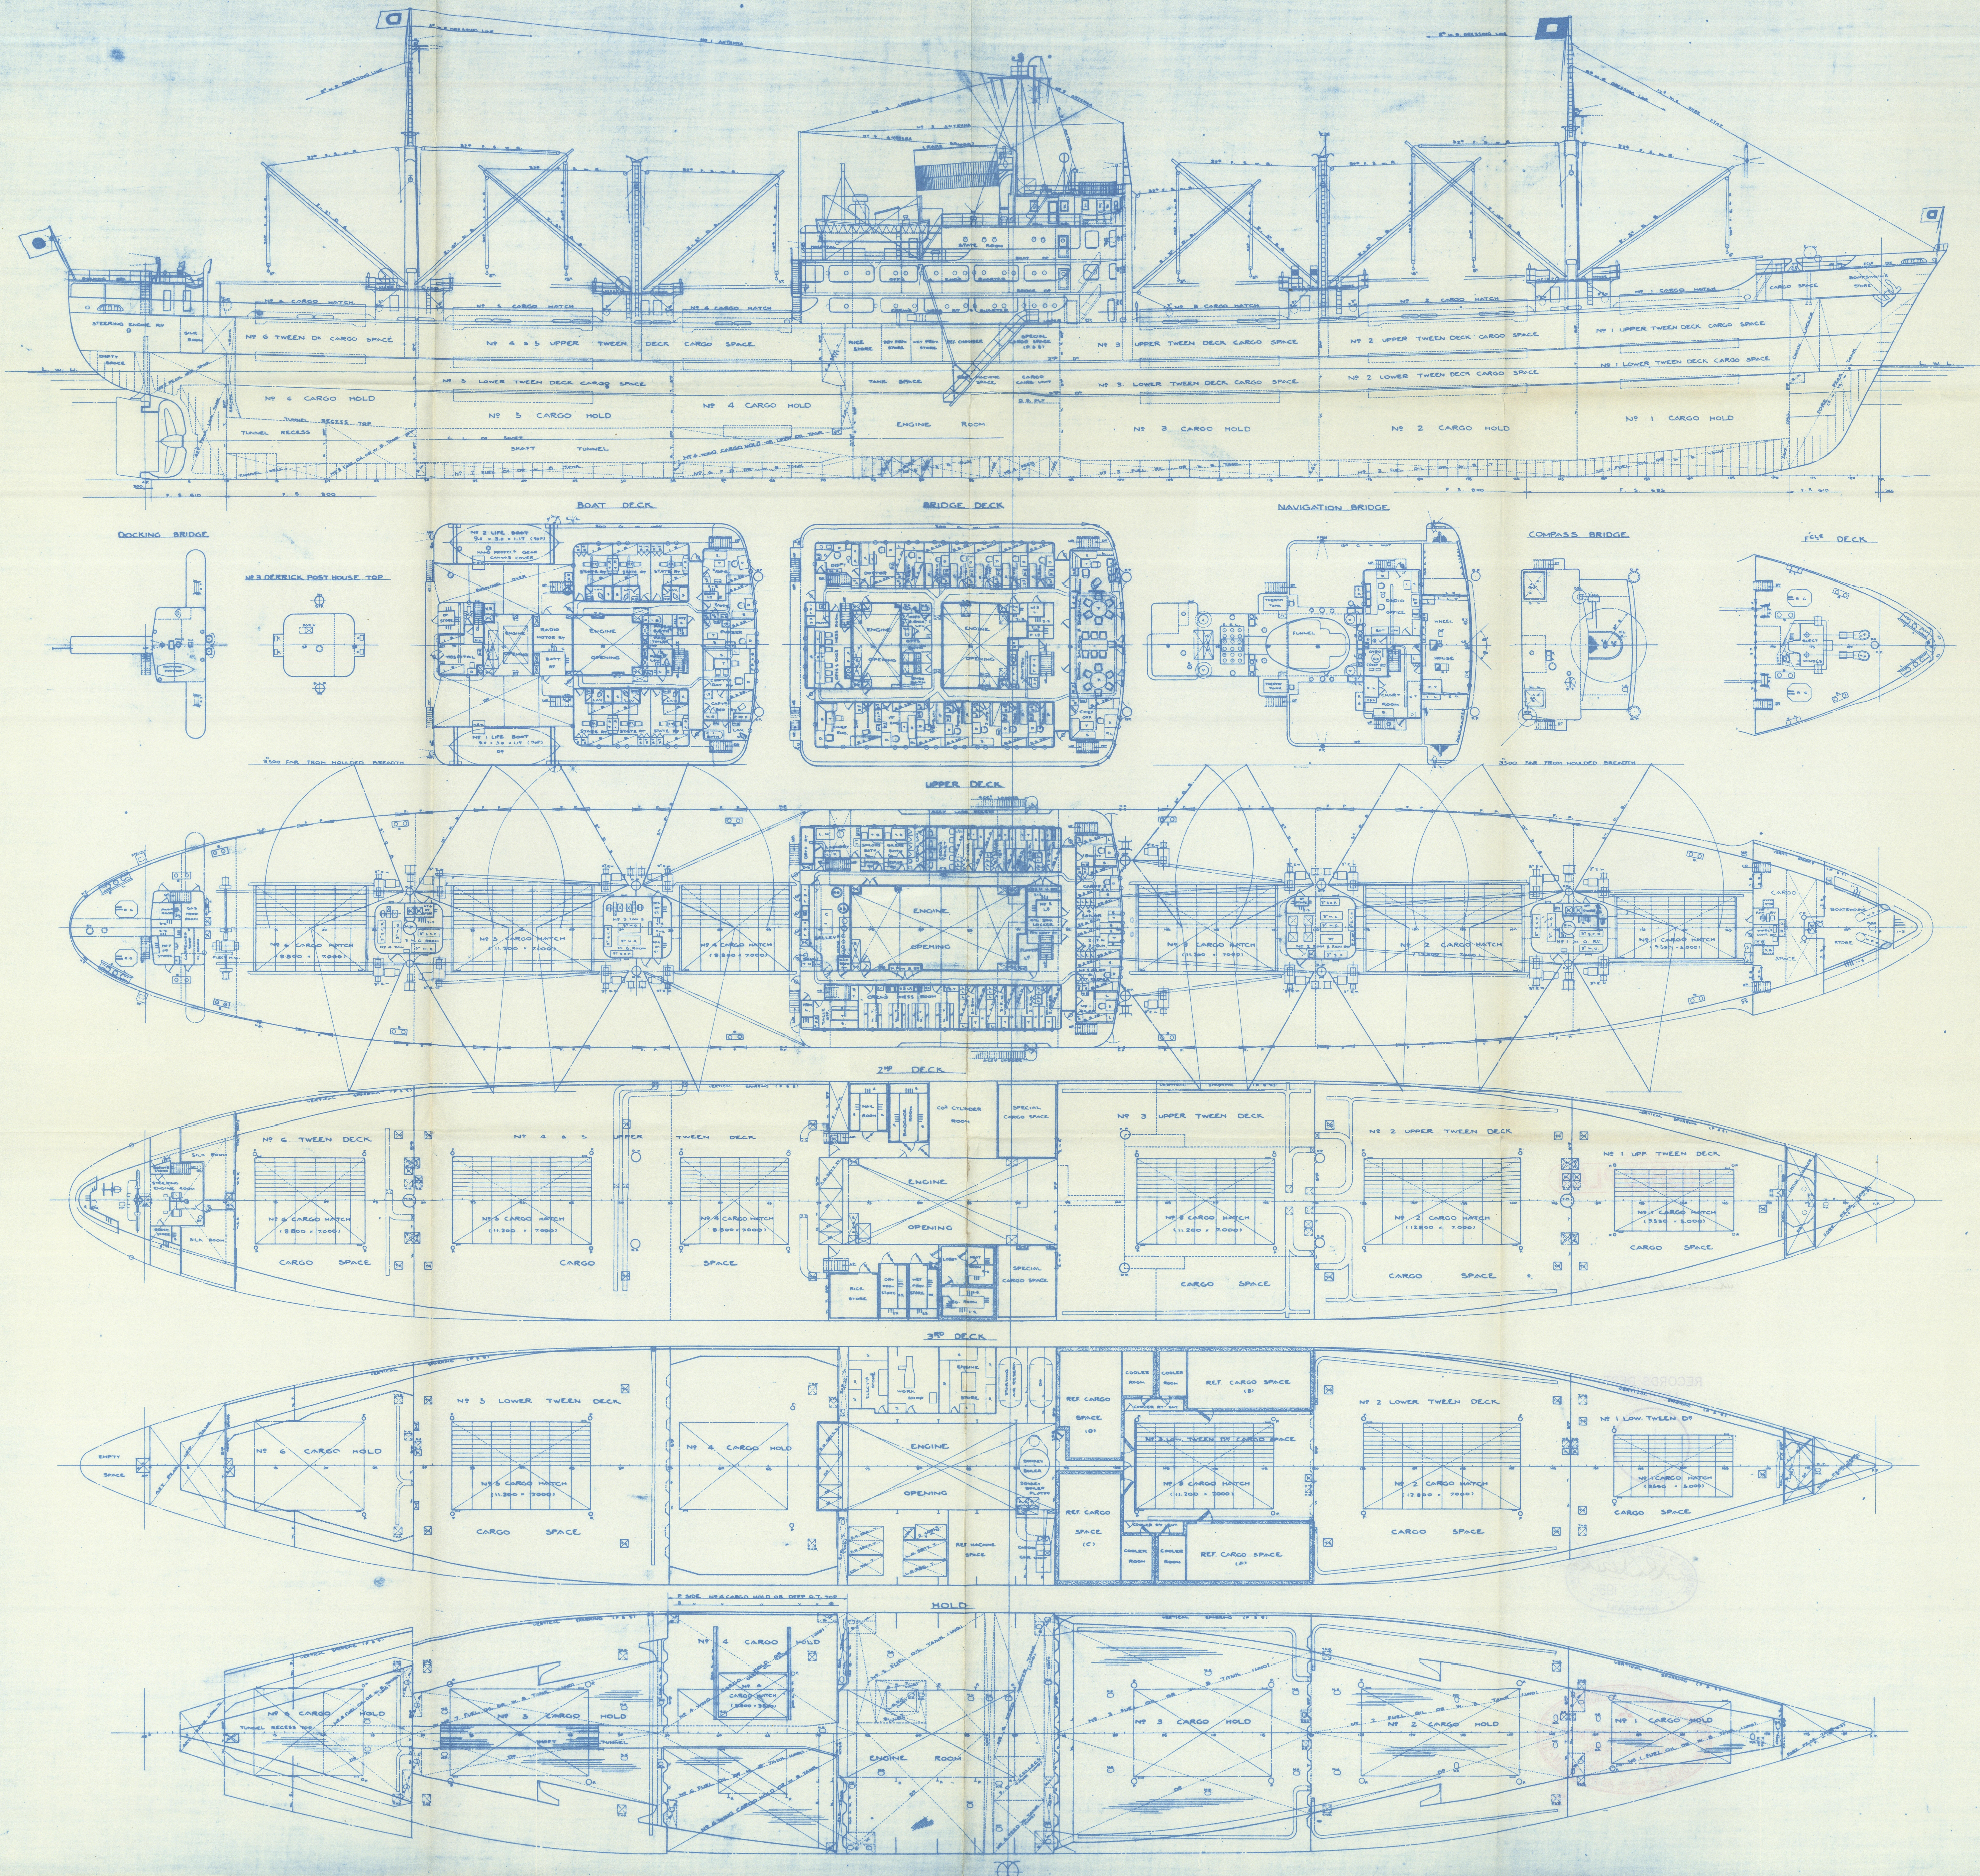

PARTICULARS	
LENGTH (S.P.)	140.000
BREADTH	12.400
DEPTH	12.200
DRAUGHT	12.200
GROSS TONNAGE	3,197.35
NET	5,372.24
DEAD WEIGHT	11,422.94
MAIN ENGINE	GUICA 1501
SPEED	MAX. 19.33 SERVICE 16.1
TWEEN DECK HEIGHT	
UPPER DECK - ST. DECK	2.850
UPPER DECK - BRIDGE - AT CENTRE	2.850
UPPER DECK - BRIDGE - AT SIDE	2.800
UPPER DECK - DOCKING BRIDGE	2.800
BRIDGE - DOCKING BRIDGE	2.600
BRIDGE - NAVIGATION BRIDGE	2.150
NAV. BRIDGE - COMPASS BRIDGE	2.350
UPPER DECK - DERRICK POST HOUSE TOP	2.300
NO. OF CREW	
CAPTAIN	1
CHIEF ENG.	1
CHIEF OFF.	1
2 ND OFF.	1
3 RD OFF.	1
4 TH OFF.	1
5 TH OFF.	1

DAIDO KAIUN
KOCHU-MARU

GENERAL
ARRANGEMENT

(FINISHED PLAN)

DIMENSION	140'0" x 19'4" x 12'2"
SCALE	1 : 200
CLASS	L.R.
EQUIPMENT DESIGNING SECTION	SHIP DESIGNING DEPARTMENT
NAGASAKI	WORKS
DATE	JUNE 8 1955
REG. NO.	REG. NO.
MITSUBISHI ZOSEN KAWABUSHI KAISHA	TOKYO
SHIP NO.	1445
DWG NO.	W-1 (克)

DAIDO KAIUN
KOCHU-MARU

GENERAL
ARRANGEMENT

(FINISHED PLAN)

DIMENSION 140^m0 × 19^m4 × 12^m2

SCALE 1 : 200 CLASS L. R.
N. K.

EQUIPMENT DESIGNING SECTION
SHIP DESIGNING DEPARTMENT
NAGASAKI WORKS

CHIEF OF DEPT. Komatsu

CHIEF R. Mitake

HEAD S. Nagao

CHECKED S. Nagao

DRAWN S. Nagao

DATE JUNE 8 1955 REG NO
MITSUBISHI ZOSEN KABUSHIKI KAISHA
TOKYO JAPAN

SHIP NO 1 4 4 5




DWG NO W - 1 (完)

LONDON

FINISHED PLAN

Shimonoseki Report No. 450

RECORDS DEPT.,
LONDON.

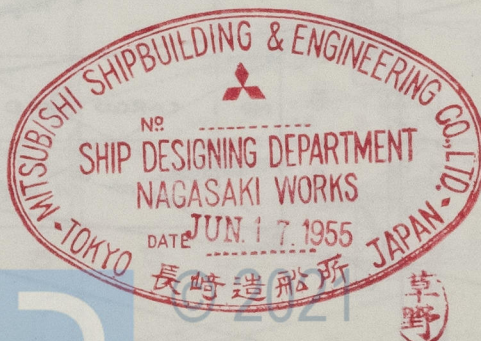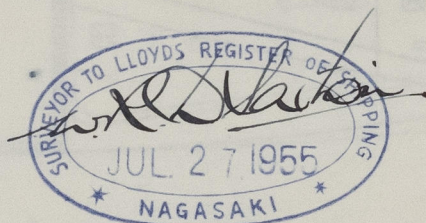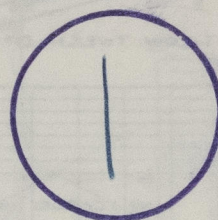

Lloyd's Register
Foundation

010791-010796-0037

010791-010796-0037