

DAIDO KAIUN
M.S. KOCHU-MARU

STERN FRAME

(FINISHED PLAN)

DIMENSION 1400 x 194 x 122

SCALE $\frac{1}{20}, \frac{1}{10}, \frac{1}{2}, \frac{1}{1}$ CLASS L.R.

HULL DESIGNING SECTION
SHIP DESIGNING DEPARTMENT
NAGASAKI WORKS

CHIEF OF DEPT.

CHIEF

HEAD

CHECKED

DRAWN

DATE

REG. NO.

DAIDO KAIUN
MITSUBISHI ZOSEN KABUSHIKI KAISHA
TOKYO JAPAN

SHIP NO.

1445

DSN NO.

H-202



LONDON

Shimonoseki Report no 450

Certified copy of approved plan.

RECORDS DEPT.,
LONDON.

9

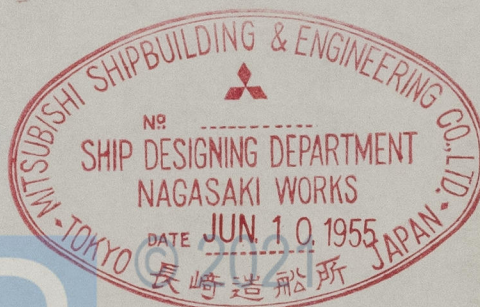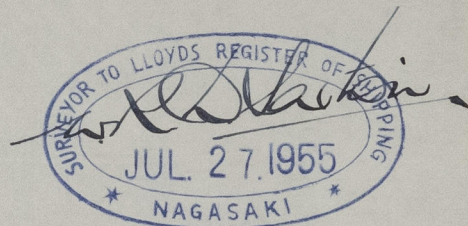

Lloyd's Register
Foundation

010791-010796-0041

010791-010796-0041