

T. E. V. "BEAVERCOVE"

MIDSHIP SECTION.

SCALE - $\frac{1}{2}$ " = 1 FOOT.

AS FITTED.



DIMENSIONS:- 465'-0" B.P. ON L.W.L. x 64'-0" M.D. x 42'-8" M.D. TO UPPER DECK x 32'-1 1/2" M.D. TO 2ND DECK.

TO CLASS 100-A1 WITH FREEBOARD AT LLOYDS SPECIAL SURVEY.

THE SCANTLINGS ARE SUITABLE FOR A MOULDED DRAFT OF 29'-7 1/4" WITH TONNAGE OPENING CLOSED.

LLOYDS NUMERALS


FIRST LONGITUDINAL NUMBER L x D	465 x 40.12	= 18655
SECOND LONGITUDINAL NUMBER L x D	465 x (8+D) 465 x (64+40.12)	= 48415
L/D TO UPPER DECK	465 ÷ 42.66	= 10.9
D MOULDED DEPTH	32.12 + 8	= 40.12
d FRAMING DEPTH	21.21 + 3.91	= 17.3
d FRAMING DEPTH WITH LEVEL WING BRACKETS		= 18.5

EQUIPMENT NUMBER

SECOND LONGITUDINAL NUMBER	465 x (64+42.66)	= 49597
POOP	33 x 7.5 x .75	= 18.5
FORECASTLE	33 x 7.0 x .75	= 17.3
MIDSHIP HOUSE	84 x 8.0 x .50	= 33.6
DECKHOUSE	80 x 8.0 x .50	= 32.0
BOAT DECK HOUSE	60 x 8.0 x .50 + 25 x 11 x .50	= 240 + 137 = 377
EQUIPMENT NUMBER		= 50988


EQUIPMENT

2 BOWERS ANCHORS	85 1/2 CWTs. EACH STOCKLESS.
1 BOWER ANCHOR	73 1/2 CWTs. STOCKLESS.
1 STREAM ANCHOR	25 CWTs. EX. STOCK.
300 FATHOMS	2 3/4" STUD. CHAIN CABLE.
120 FATHOMS	4 1/4" STEEL WIRE STREAM LINE.
130 FATHOMS	5 1/2" STEEL WIRE TOW LINE.
2 HANISERS	100 FATHOMS EACH 3" STEEL WIRE.
2 WARPS	100 FATHOMS EACH 3" STEEL WIRE.

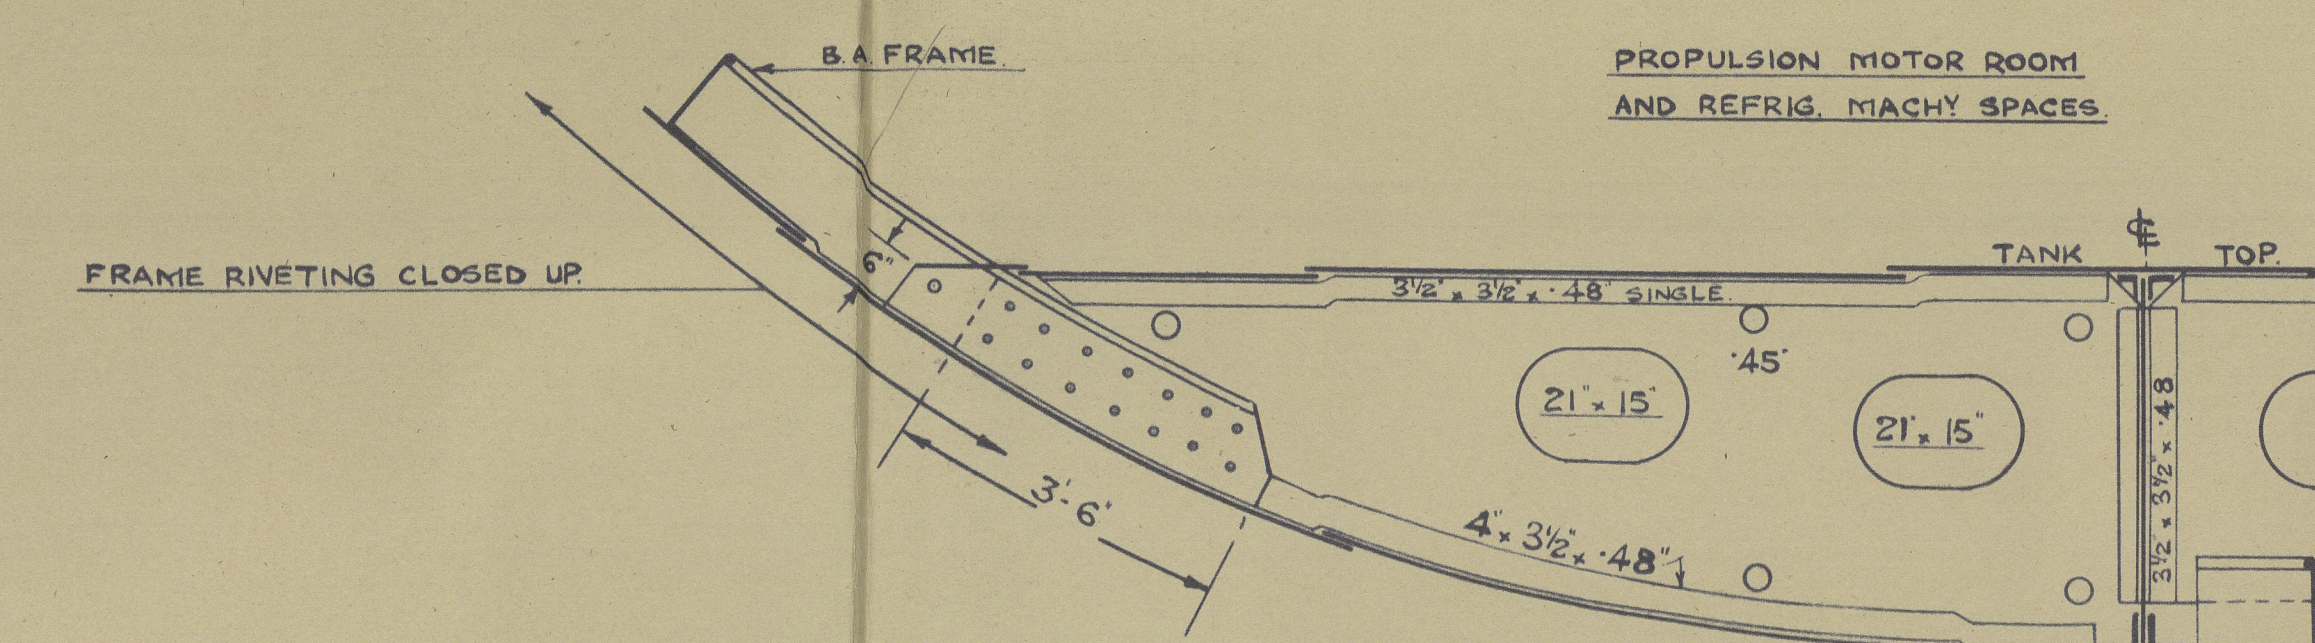

TYPICAL SECTION OF DOUBLE BOTTOM. FRAMES 40-53.

FRAME RIVETING CLOSED UP

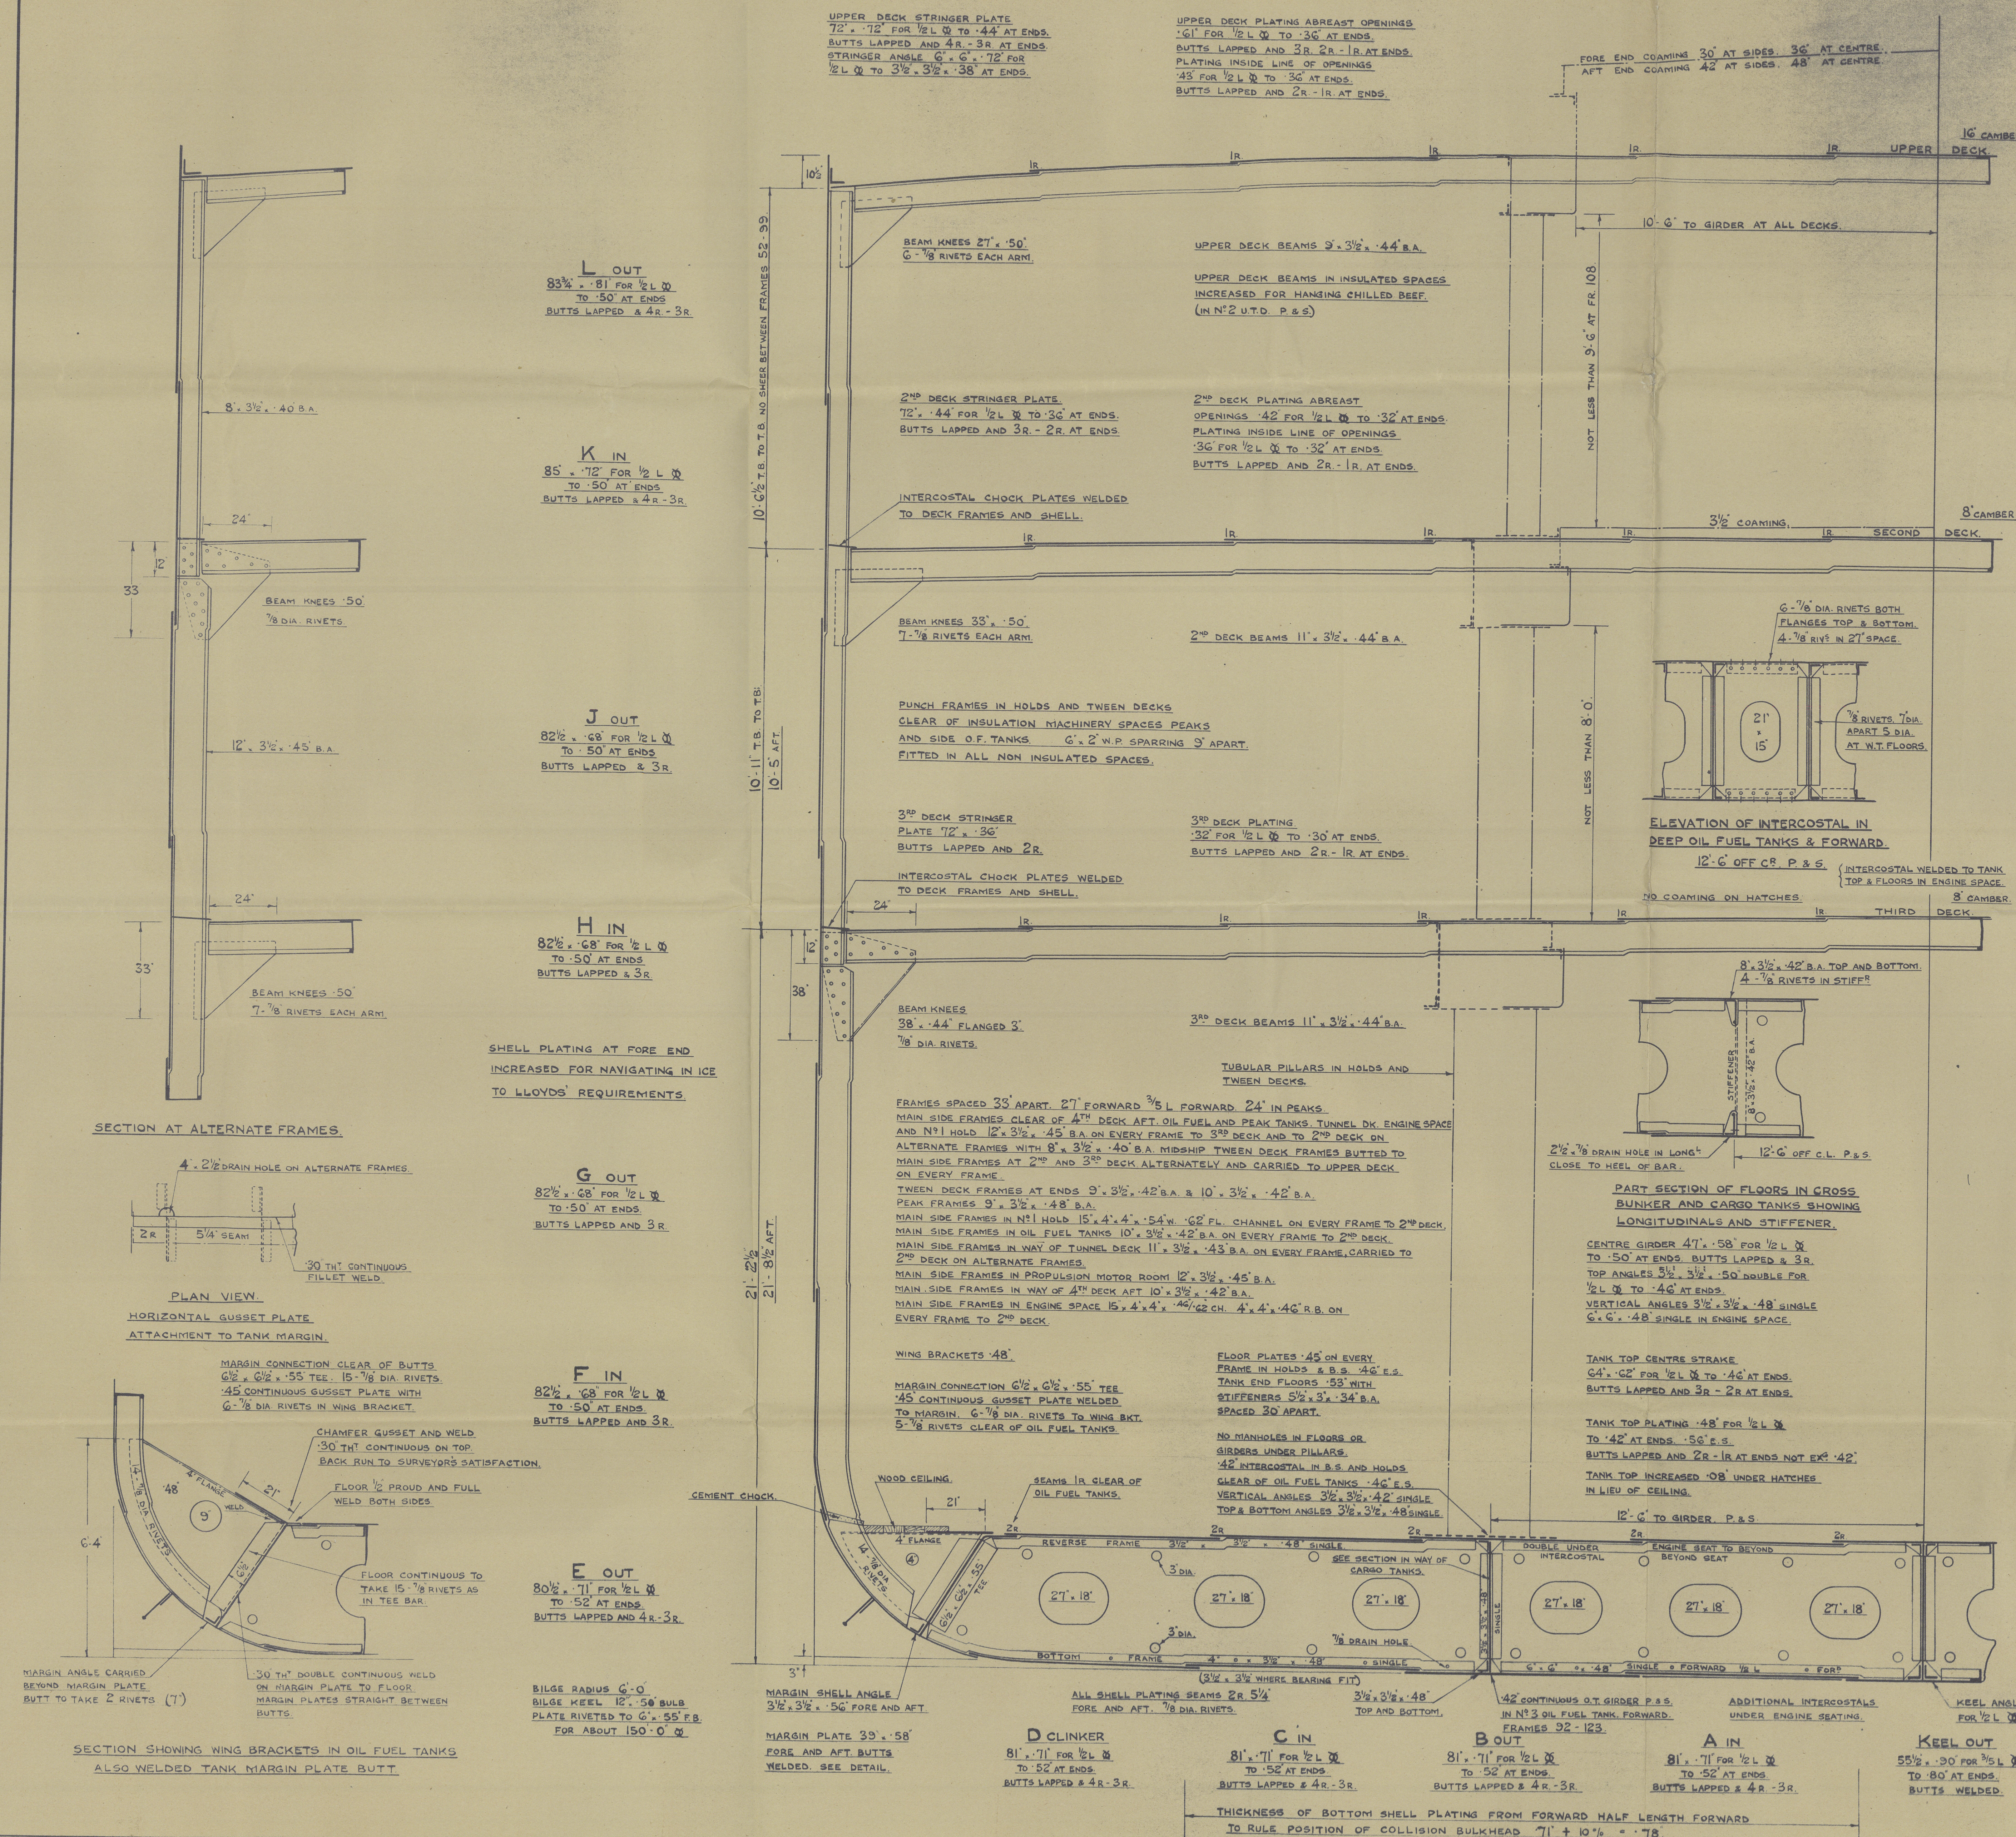

Janfild LBr & Co Ld

Yard no 728

Beavercone



Midship Section (as fitted)

Glasgow Rpt no 72022

2