

18 AUG 1949

Rpt. C. 11 (Contd.)

GLASGOW REPORT NO. 74161a

Index No.


Lloyd's Register of Shipping.

Ship's Name "Vic 7"

Official No.

Memorandum of alterations reported since ship was surveyed for assignment of Load Lines in

Hatch webs have been fitted with 5'-0" x 4" x 4" x .5 angle bars with toe welded to webs in way of notch. These have been examined and found satisfactory. 10/8/49.

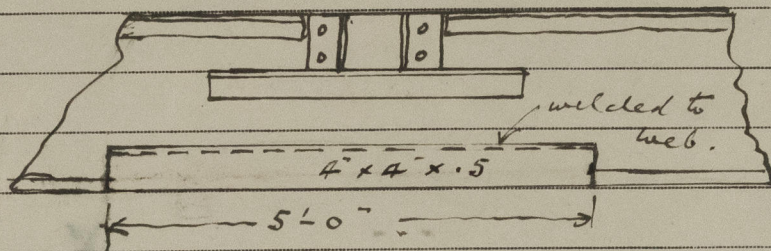

A. H. Dwyer

17/8/49

It is assumed the modifications have been maintained in way of the 4x4x.5 bar and this should be verified

Noted
A. H.

742



© 2021

Lloyd's Register Foundation