

28 JUN 1949

Rpt. C. 11 (Contd.)

Index No.

Lloyd's Register of Shipping.



Ship's Name VIC..7.Official No. ✓

Memorandum of alterations reported since ship was surveyed for assignment of Load Lines in ✓

Lifelines are provided on the upper deck. ✓

The freeing ports are fitted with one horizontal bar.

The hatch webs as per sketches & considered satisfactory.

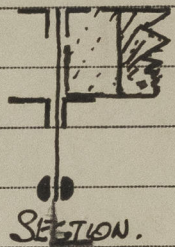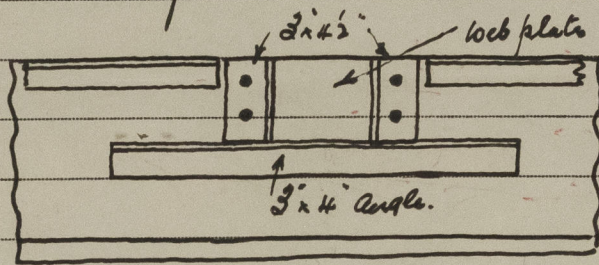

The wood fore & after fitted with steel shores.

The letters L. R. cut in on ships sides.

K. Berry

25. June 1949.

Expenses 10/-

G.H.W.

6-7-49.



© 2021

Lloyd's Register
Foundation