

# Lloyd's Register of Shipping.

Ship's Name

"Zanquero" ex Fort Wood

Official No.


Memorandum of alterations reported since ship was surveyed for assignment of Load Lines in the Port of Baltimore.

The general condition of the freeboard deck was improved in St. Marguerite, during the month of February 1949, by the addition of a rail, welded on the transverse, 0' 2 1/2" from the deck and 0' 2 1/2" from the rail above, as per sketch. Material and workmanship found satisfactory.

Made 16 May 1949

The Surveyor

*[Signature]*

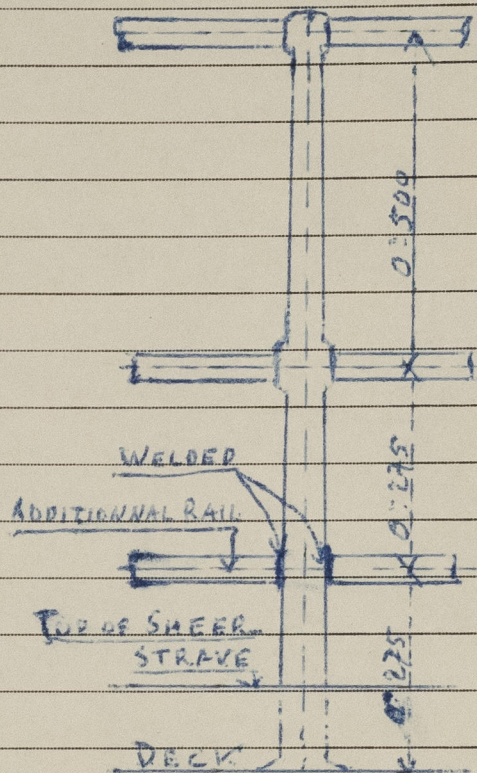

J.H.W.  
20 MAY 1949