

Nº 327. S.S.

PROFILE AND DECK PLANS.

SCALE $\frac{1}{8}$ " = ONE FOOT.



PROFILE AS ALREADY APPROVED

Painting and
to be submitted

UPPER DECK AS ALREADY APPROVED

MAIN DECK

BULKHEAD STIFFENERS.

BARRAND No.	STIFFENERS BELOW MAIN DECK	SPACING	STIFFENERS FROM MAIN TO LOWER DECK	SPACING	STIFFENERS FROM TANK TOP TO LOWER DECK	SPACING	Plotting		

C. C. G.
S. 5. 19.

Profile

N^o. 327.

A. J. Inglis & Co. Ltd.



H. Type Standard
Steamer with 2nd
deck fitted

HERVAL

EX

GLASGOW REPORT No. 40537.

S/S Alvarado.

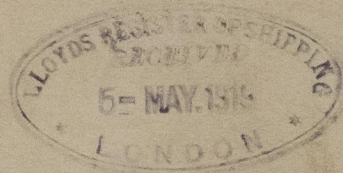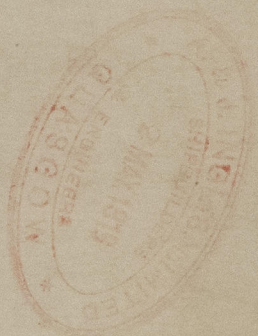

© 2021

Lloyd's Register
Foundation

010835-010845-0075