
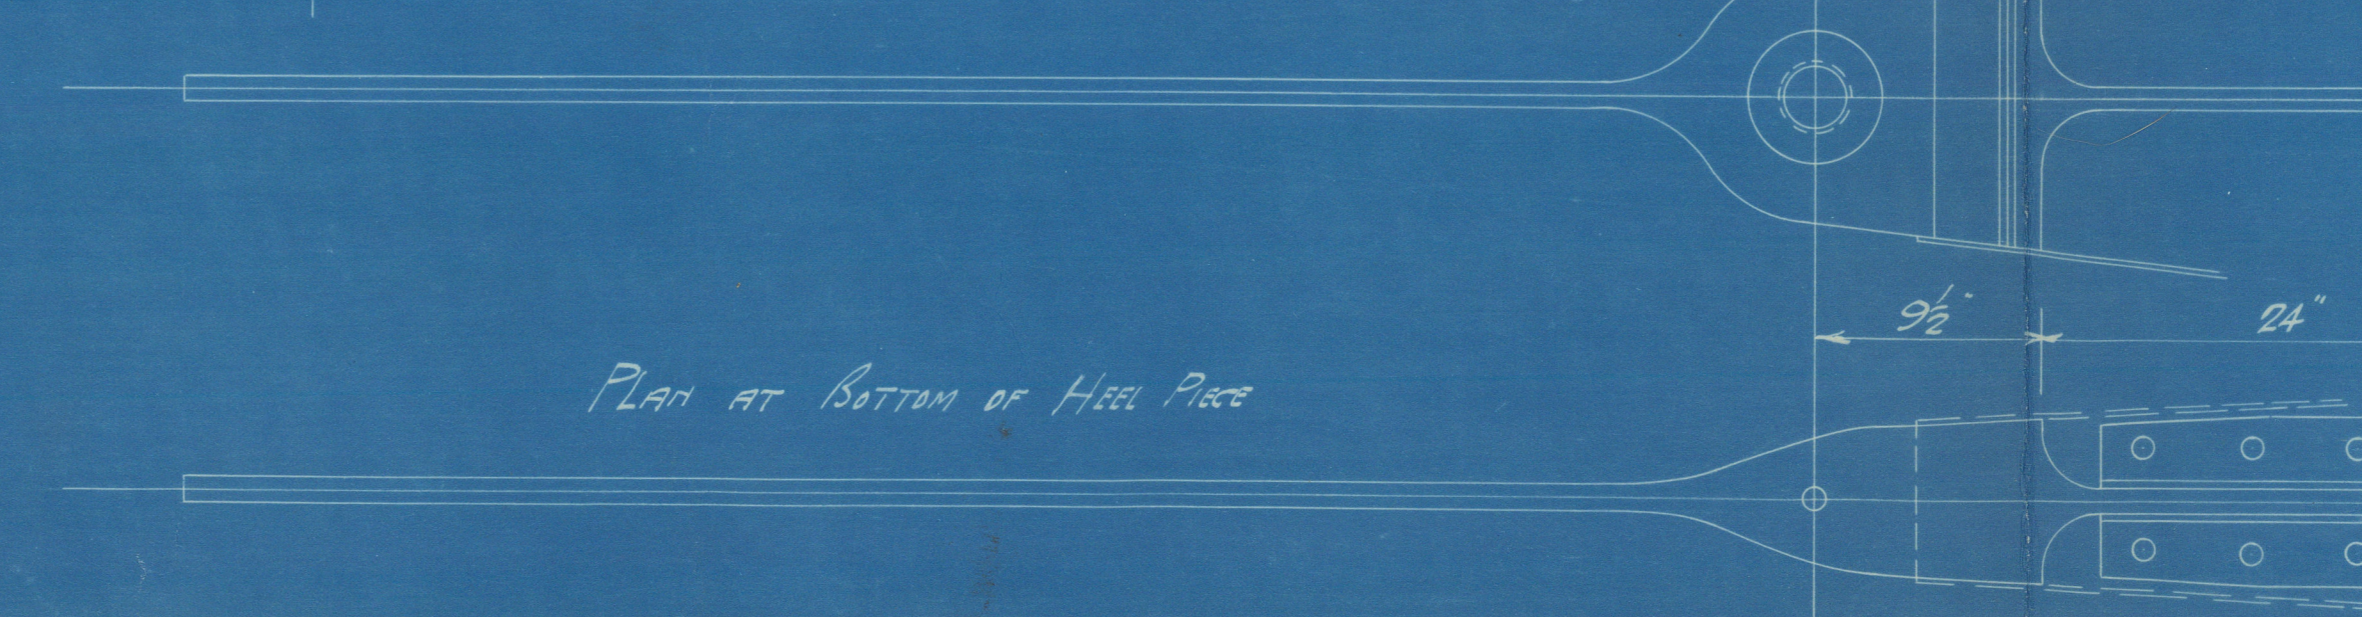
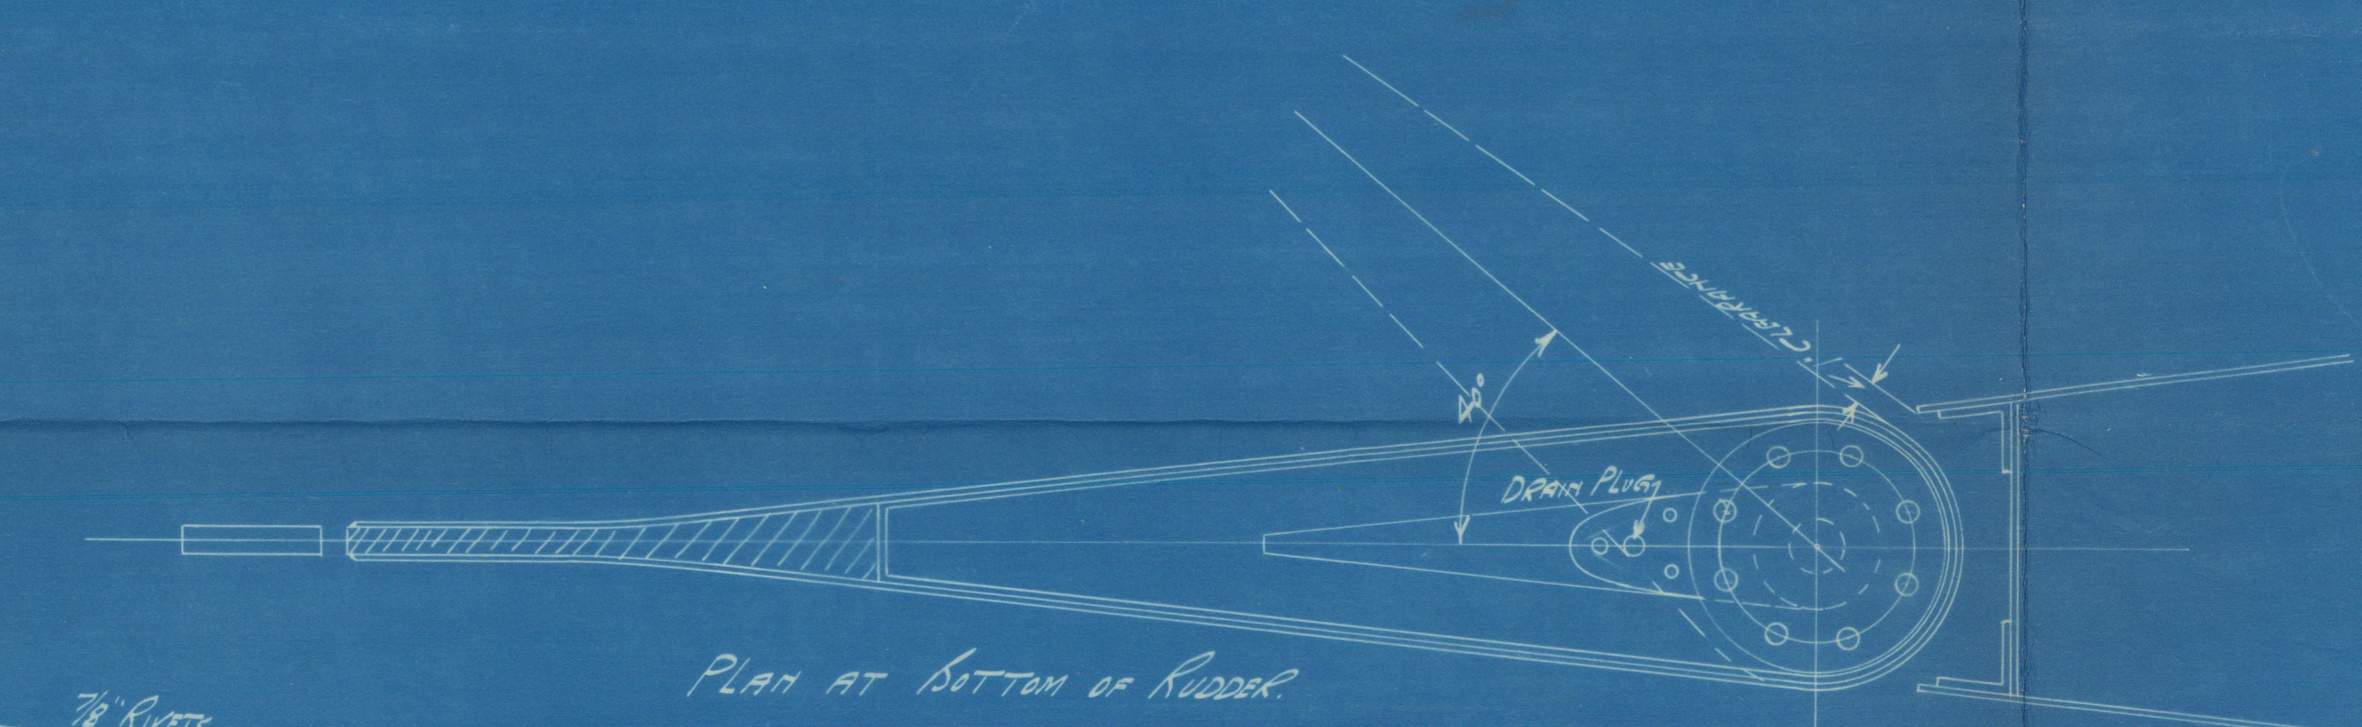
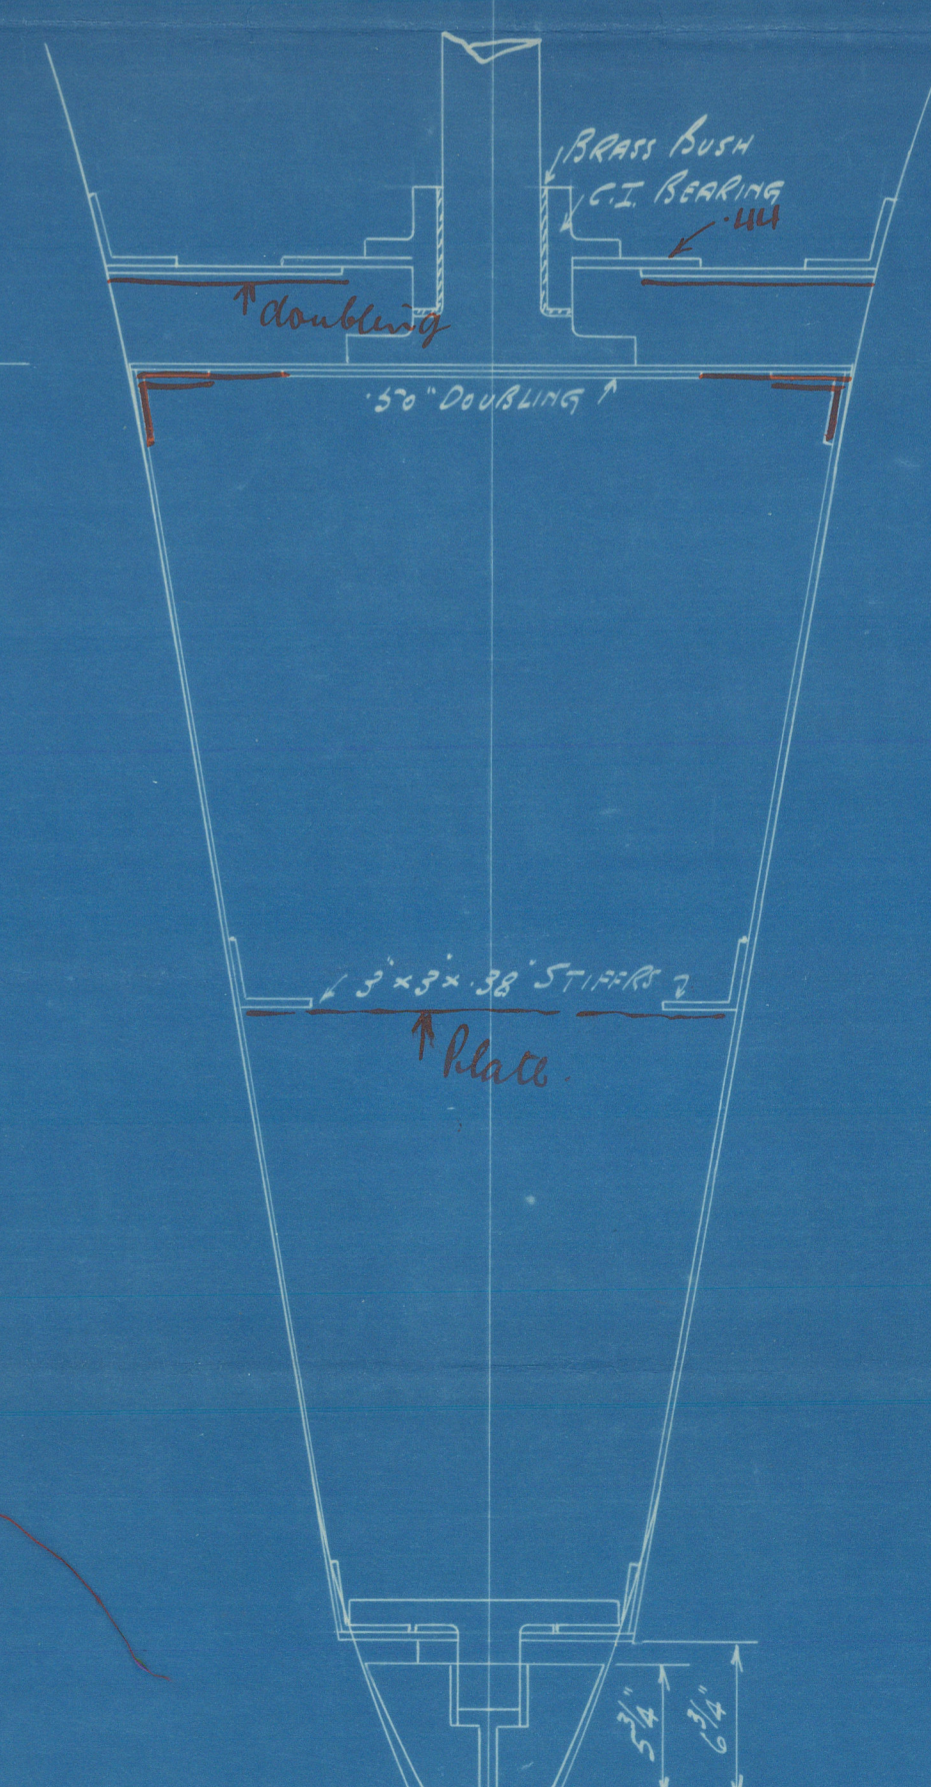
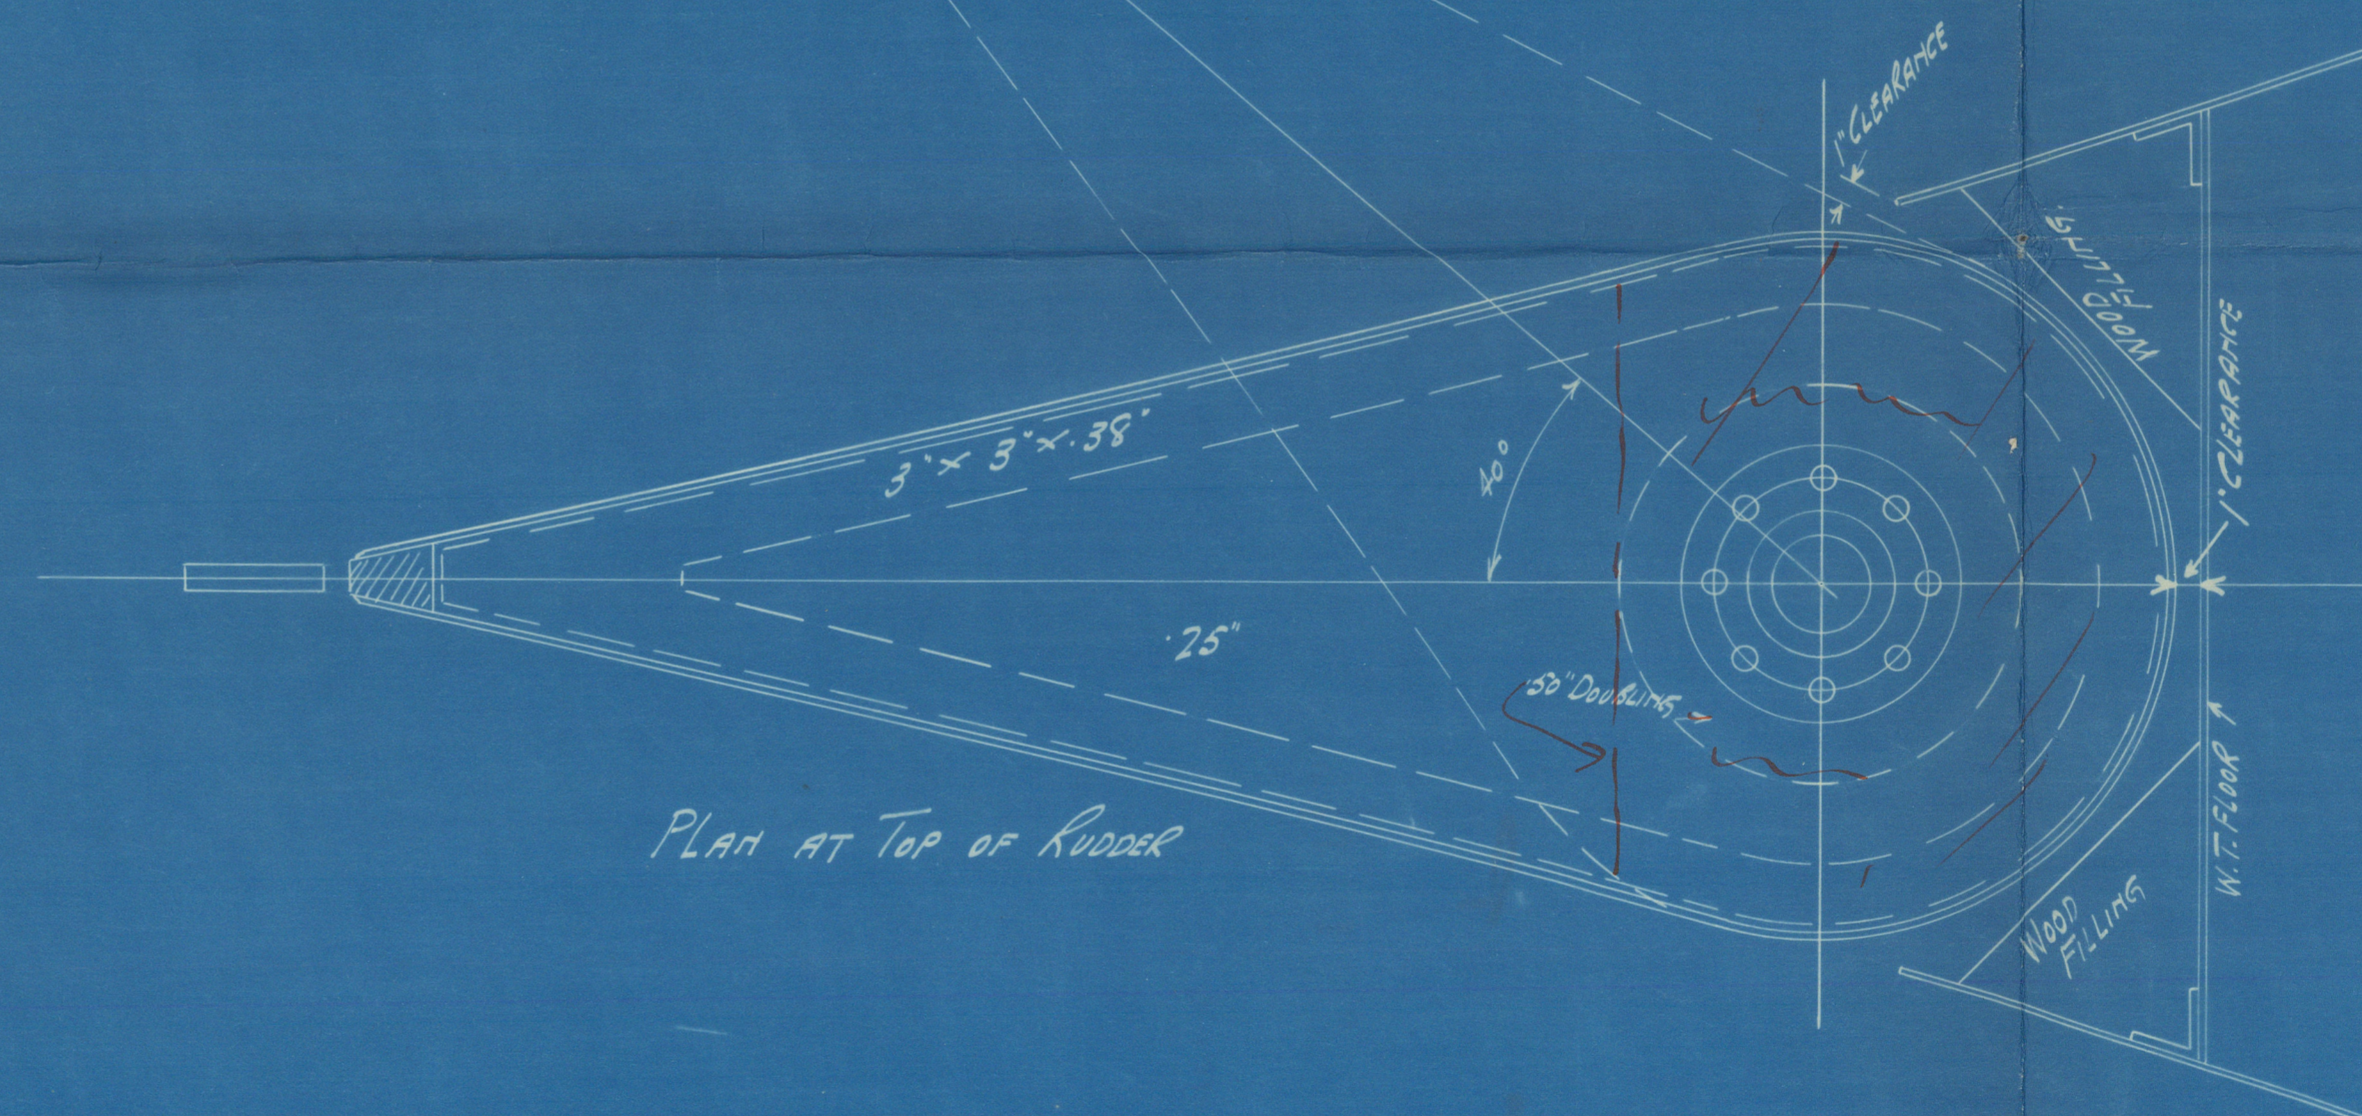
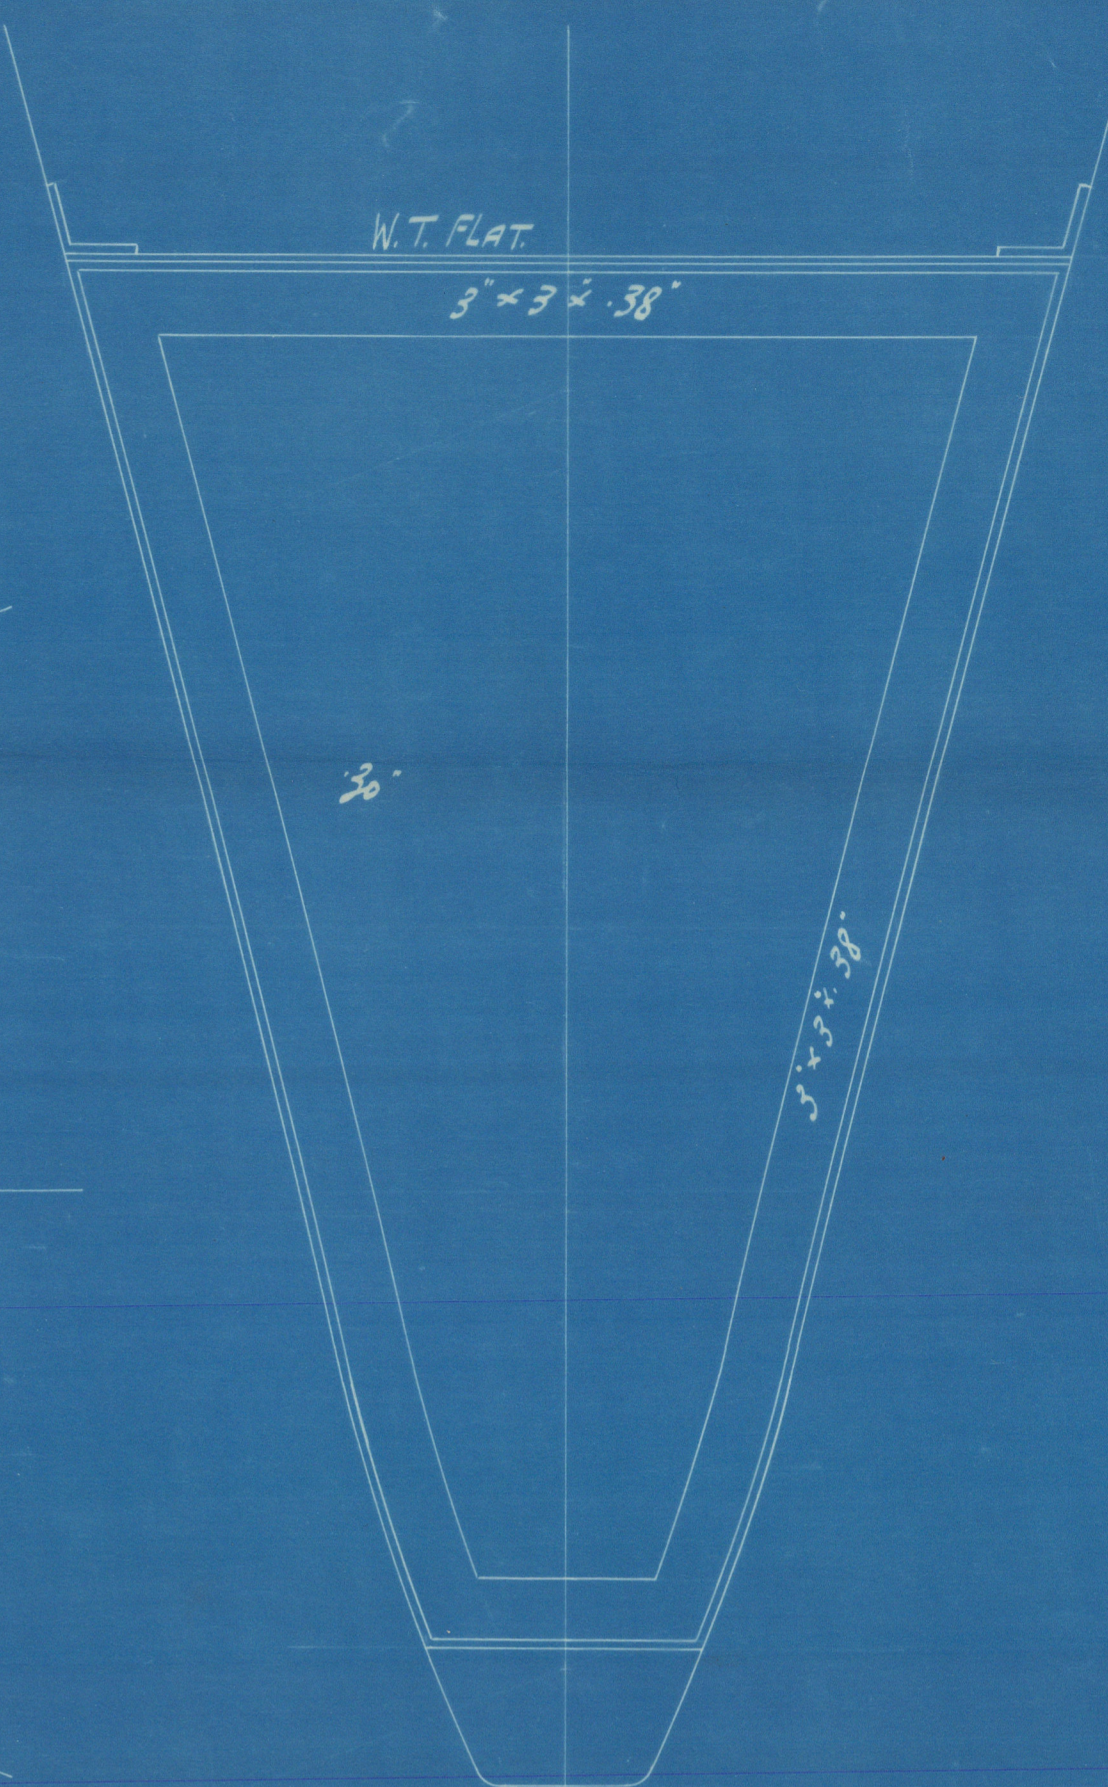
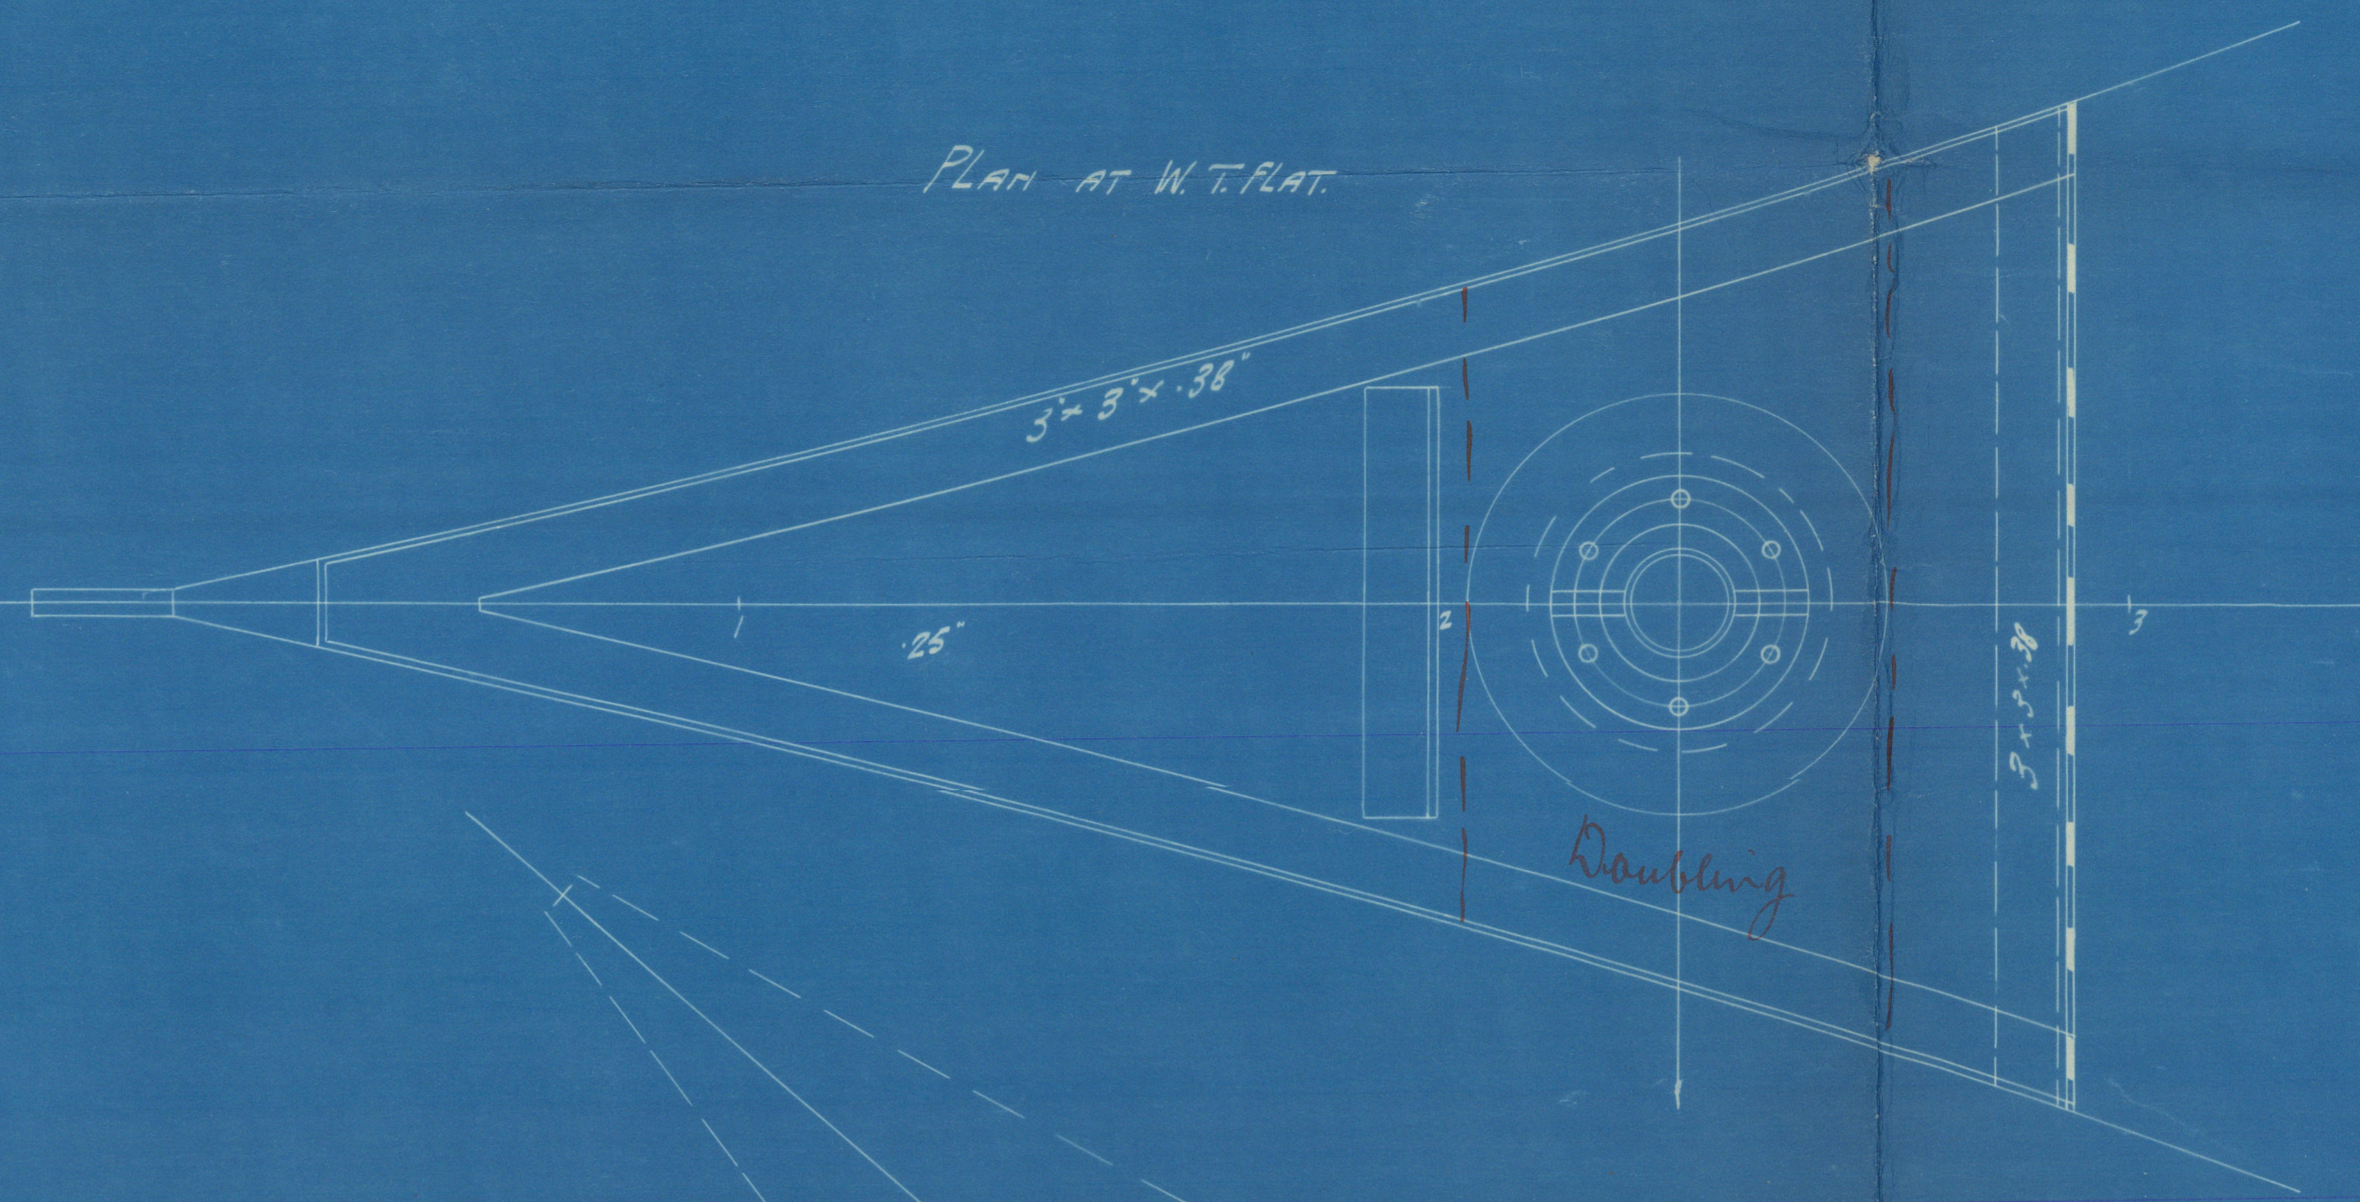


P.S. No 330.  
 RUDDER & STERN FRAME.  
 SCALE  $1\frac{1}{2}" = 1 \text{ FOOT}$

NUMERALS: A-D = 22 x 2.5 = 55 SPEED  $9\frac{1}{2}$  KNOTS (AREA TAKEN FROM  $\frac{1}{2}$  OF RUDDER STOCK)  
 RUDDER STOCK  $3\frac{3}{4}"$  DIA. PER RULES  
 -11- -11- 4" -11- -11- ONNERS.  
 NOTES: ALL TO B.O.T. & LLOYDS REQUIREMENTS. FORGED IRON BEST SHIPYARD SCAP  
 FOR DETAILS SEE BOW RUDDER PLAN.

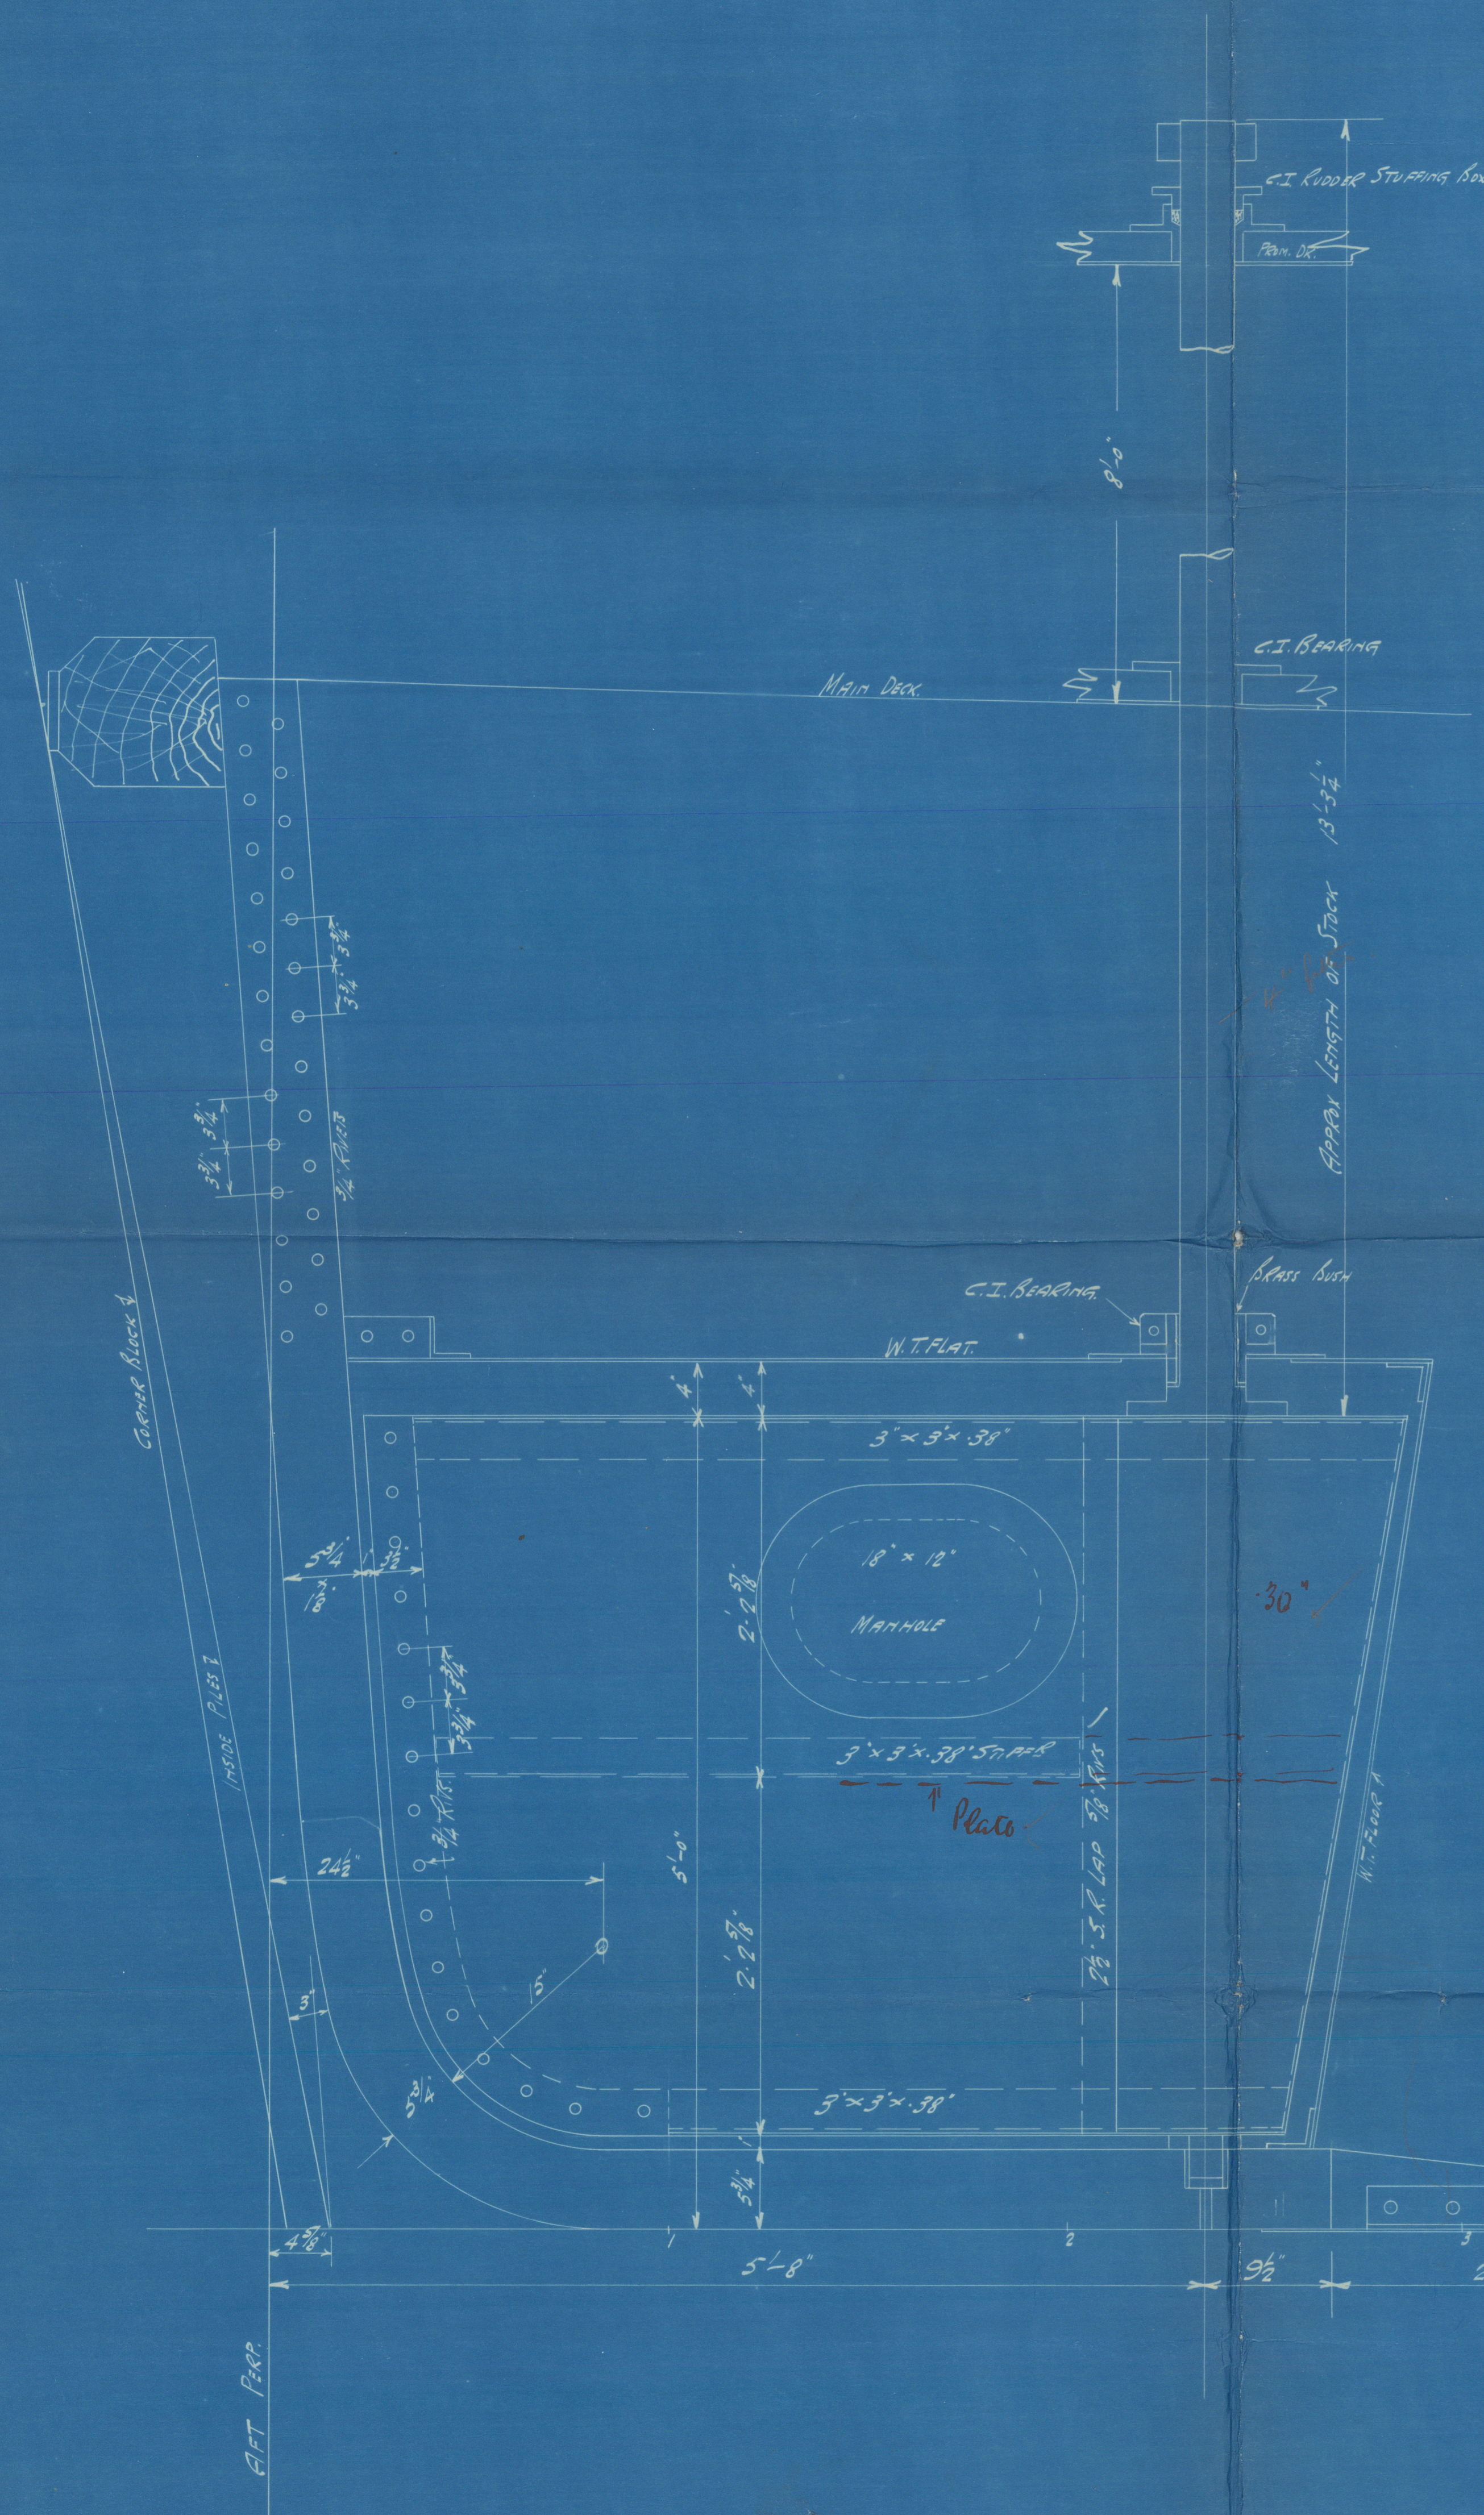

APPROVED  
 LLOYD'S REGISTER OF SHIPPING  
 20. 11. 18

Messrs. The Caledon S. & E. Co. Ltd.

No. 330.

RUDDER & STERN FRAME.

Ferry Paddle Steamer

"B. L. Nairn"

Dundee Report N<sup>o</sup> 8695.



© 2021

Lloyd's Register  
Foundation

010674-016881-0014