

LLOYD'S REGISTER OF SHIPPING

Index No. 48691
(For London Office only.)


UNITED WITH THE BRITISH CORPORATION REGISTER

SURVEYS FOR FREEBOARD.

(CONDITIONS OF ASSIGNMENT.)

Ship's Name SOVAC RADIANT. Port of Survey PALERMO.
 Official Number 1351F Surveyor's Signature H. Evans, W. W. Maitland
 Nationality and Port of Registry PANAMA. Date of Survey 1st, 3rd, 4th, 6th, 8th, 10th, 12th Aug 1955

Disposition and dimensions of superstructures, ~~trunks~~, deckhouses, machinery casings ~~and other structures~~ to be inserted in the diagrams and tabular statement:—

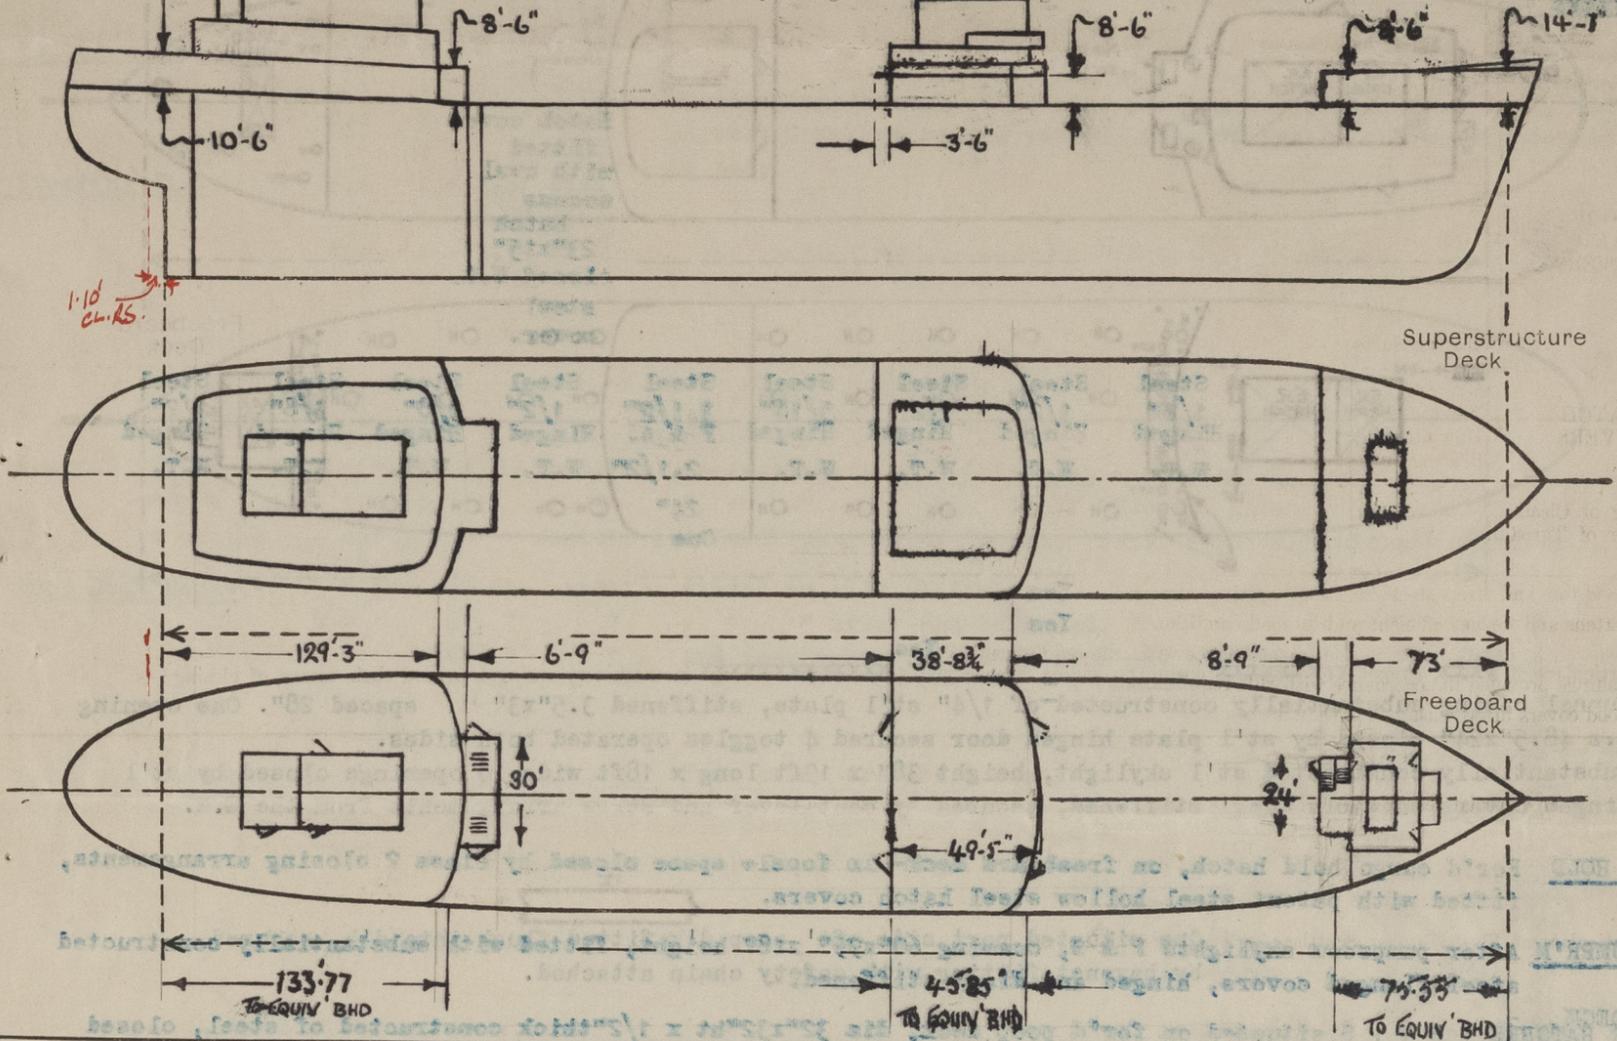

Particulars of Superstructures, Trunks, Casings, Deckhouses.

	Coaming	Plating	Stiffeners	Spacing	End Attachments of Stiffeners	Size of Openings	Height of Sills	Height, between between D'ks.
Poop Bulkhead (IN WAY OF PUMP ROOM)	-	7/16"	3.5x2.5x0.25 J	30"	Nil Stiff's shaped.	Nil	-	102"
Raised Quarter Deck Bulkhead	-	-	-	-	-	-	-	-
Bridge, After Bulkhead	-	5/16"	4x3x0.25. J	30"	Top welded to beams bot' snapped.	One P&S 60x28 One S 61x49	18.5	102"
Bridge, Forward Bulkhead	-	3/8"	11x4.5x3/8" J	30"	Welded to D'k top and bot'.	One P & One S 28 x 60	18.5	102"
Forecastle Bulkhead	-	5/16"	3.5x2.5x1/4" J	30"	Stiff's snapped T & B	1P&1S 48x38 " 28x60	23 18	102"
For'd secondary for'stle bulkhead	-	3/8"	6x4x3/8" J	30"	Welded to D'k top & bot'	1P. 63x28 1S. 62x50	15.5 23	102"
Trunk, Forward	-	-	-	-	-	-	-	-
Exposed Machinery Casings on Freeboard or Raised Quarter Decks	-	-	-	-	-	-	-	-
Exposed Machinery Casings on Superstructure Decks (Boat D'k)	-	5/16"	4x3x3/8" J	36"	Alternative stiff's b'kts top	60x28	16.5	43"
Machinery Casings within Superstructures	Main D'k 5/8"	5/16"	4x3x3/8" J	28"	"	66x28	13.5	-
Poop D'k	-	"	"	"	"	"	15	-
Aft' Deckhouse Pump Room Entrances & EXPOSED POOP BHD.	-	3/8"	10x4.5x0.5 J	30"	Welded to D'k at bot'm. Welded and b'kt to D'k at top.	28x60	18.5	102"

Particulars of Closing Appliances (state if capable of being manipulated from both sides).

Poop Bulkhead	NO OPENINGS.
POOP HOUSE Deck Bulkhead	Substantially constructed st'l deck house enclosing E.R. casing - closed by st'l W.T. doors covering openings 60x26, sills 15", doors secured 6 toggles operated both sides.
Bridge, After Bulkhead	1.P & 1.S closed hinged st'l W.T. doors, operated both sides, secured 6 toggles. 1.S closed rect' st'l plate diag' stiffened, secured 14 hook bolts.
Bridge, Forward Bulkhead	1.P & 1.S closed hinged St'l W.T. doors, 6 toggles, operated both sides.
Forecastle Bulkhead	1.P & 1.S closed rect' st'l plates, diag' stiffened, secured with hook bolts. 1.P & 1.S closed hinged W.T. st'l doors, secured 6 toggles, operated both sides.
Exposed Machinery Casings on Superstructure Decks (Boat D'k)	FOC'SLE ENCLOSED (NOTE: The p.s. door is for access to for'd p'mp r'm) P.s. Hinged st'l door secured lock, operated both sides. S.s. rect' st'l plate, diag' stiffened, secured hook bolts.
Machinery Casings within Superstructures	1.P 60x28 fitted hinged st'l W.T. door secured 6 toggles, operated both sides
Aft' Deckhouse Pump Room Entrances	1.P & 1.S closed hinged st'l plate doors, operated both sides, situated on poop d'k level. 2.P & 2.S closed hinged st'l plate doors, operated both sides, situated on main d'k level.
	1.P & 1.S closed hinged st'l W.T. doors, operated both sides, secured 6 toggles.

