

PLAN No 1430.

VESSEL No 1832.

TWIN SCREW INSULATED LIGHTER

DIMENSIONS 225' 3" BP 44' 0" MLD 11' 6" MLD 3' MAIN DECK


20' 10" " " UPPER DECK.

To CLASS - BS \* FOR RIVER PURPOSES ONLY. DRAFT 7' 6".

SCALE 1/8" = ONE FOOT.



14 APR 1920

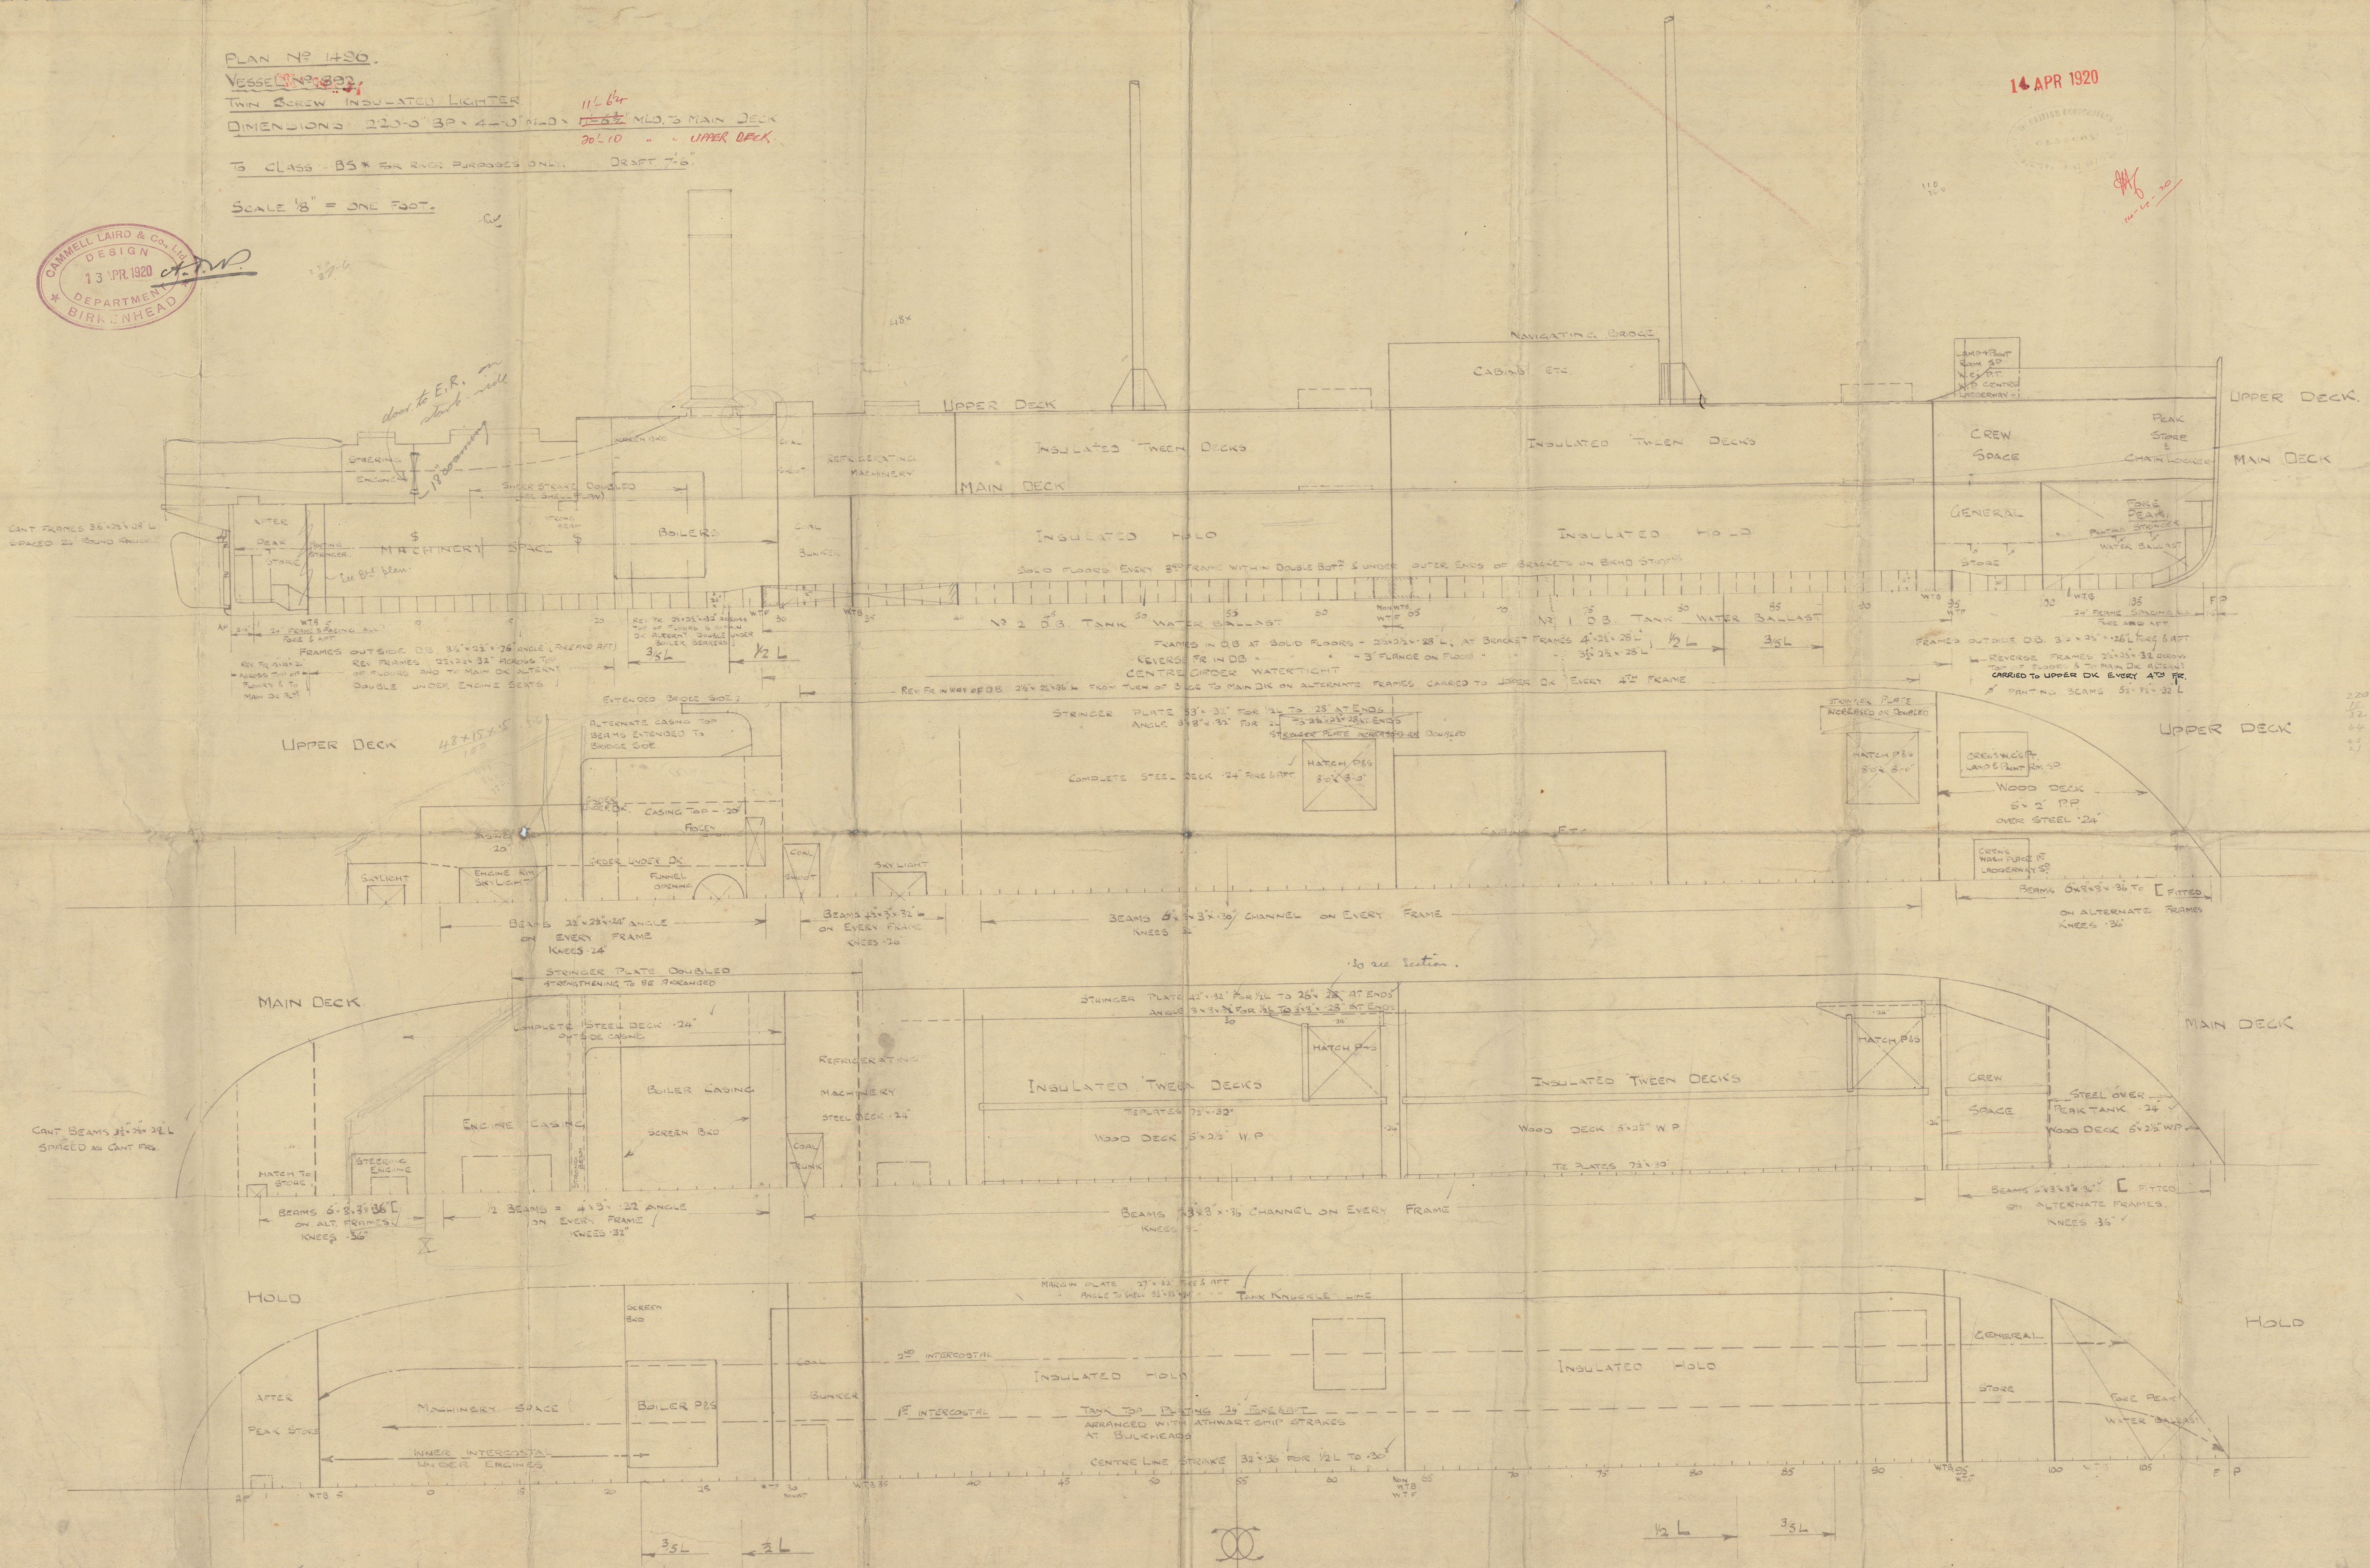



Cammell Laird & Co  
No 892  
TSS Insulated Lighter  
Amended profile & decks

bag

Tc 26. 5. 20

Cammell Laird & Co  
# 892

Amended profile & decks

**KINGSWOOD**

**ex**

14. 11 20

15

© 2021

**TSS**

**SHIRLEY**

Lloyd's Register  
Foundation

010874 - 010881 - 0122