

22-1-15
23-2-15
3-12-15


Equipment No 4255.

- 1 Stockless lower anchor 7 1/4 cuts } 14 1/4 cuts
- 1 " " " 7 " }
- 1 Common stream anchor 2 3/4 cuts on stock
- 1 " Kedge " 3/4 cut " "
- 165 fathoms 7/8" stud link cable
- 45 " 9/8" S.L. stream chain.
- 75 fathoms 6 1/2" towline + 90 fathoms 4" hawser.

S.S. No 14 + 15

L = Length B.P. = 120 Ft. 0 ins.
B = Breadth (mid) = 22 Ft. 0 ins.
D = Depth (mid to M.D.) = 10 Ft. 0 "
Depth (mid to Q.D.) = 13 Ft. 6 ins.

Transverse Number (B + D) = 32
Longitudinal " L (B + D) = 3840
d (main deck) = 8 + 9; d (quarter deck) = 12 + 13
1/2 (Main deck) = 12; 1/2 (qr. deck) = 9 + 10.

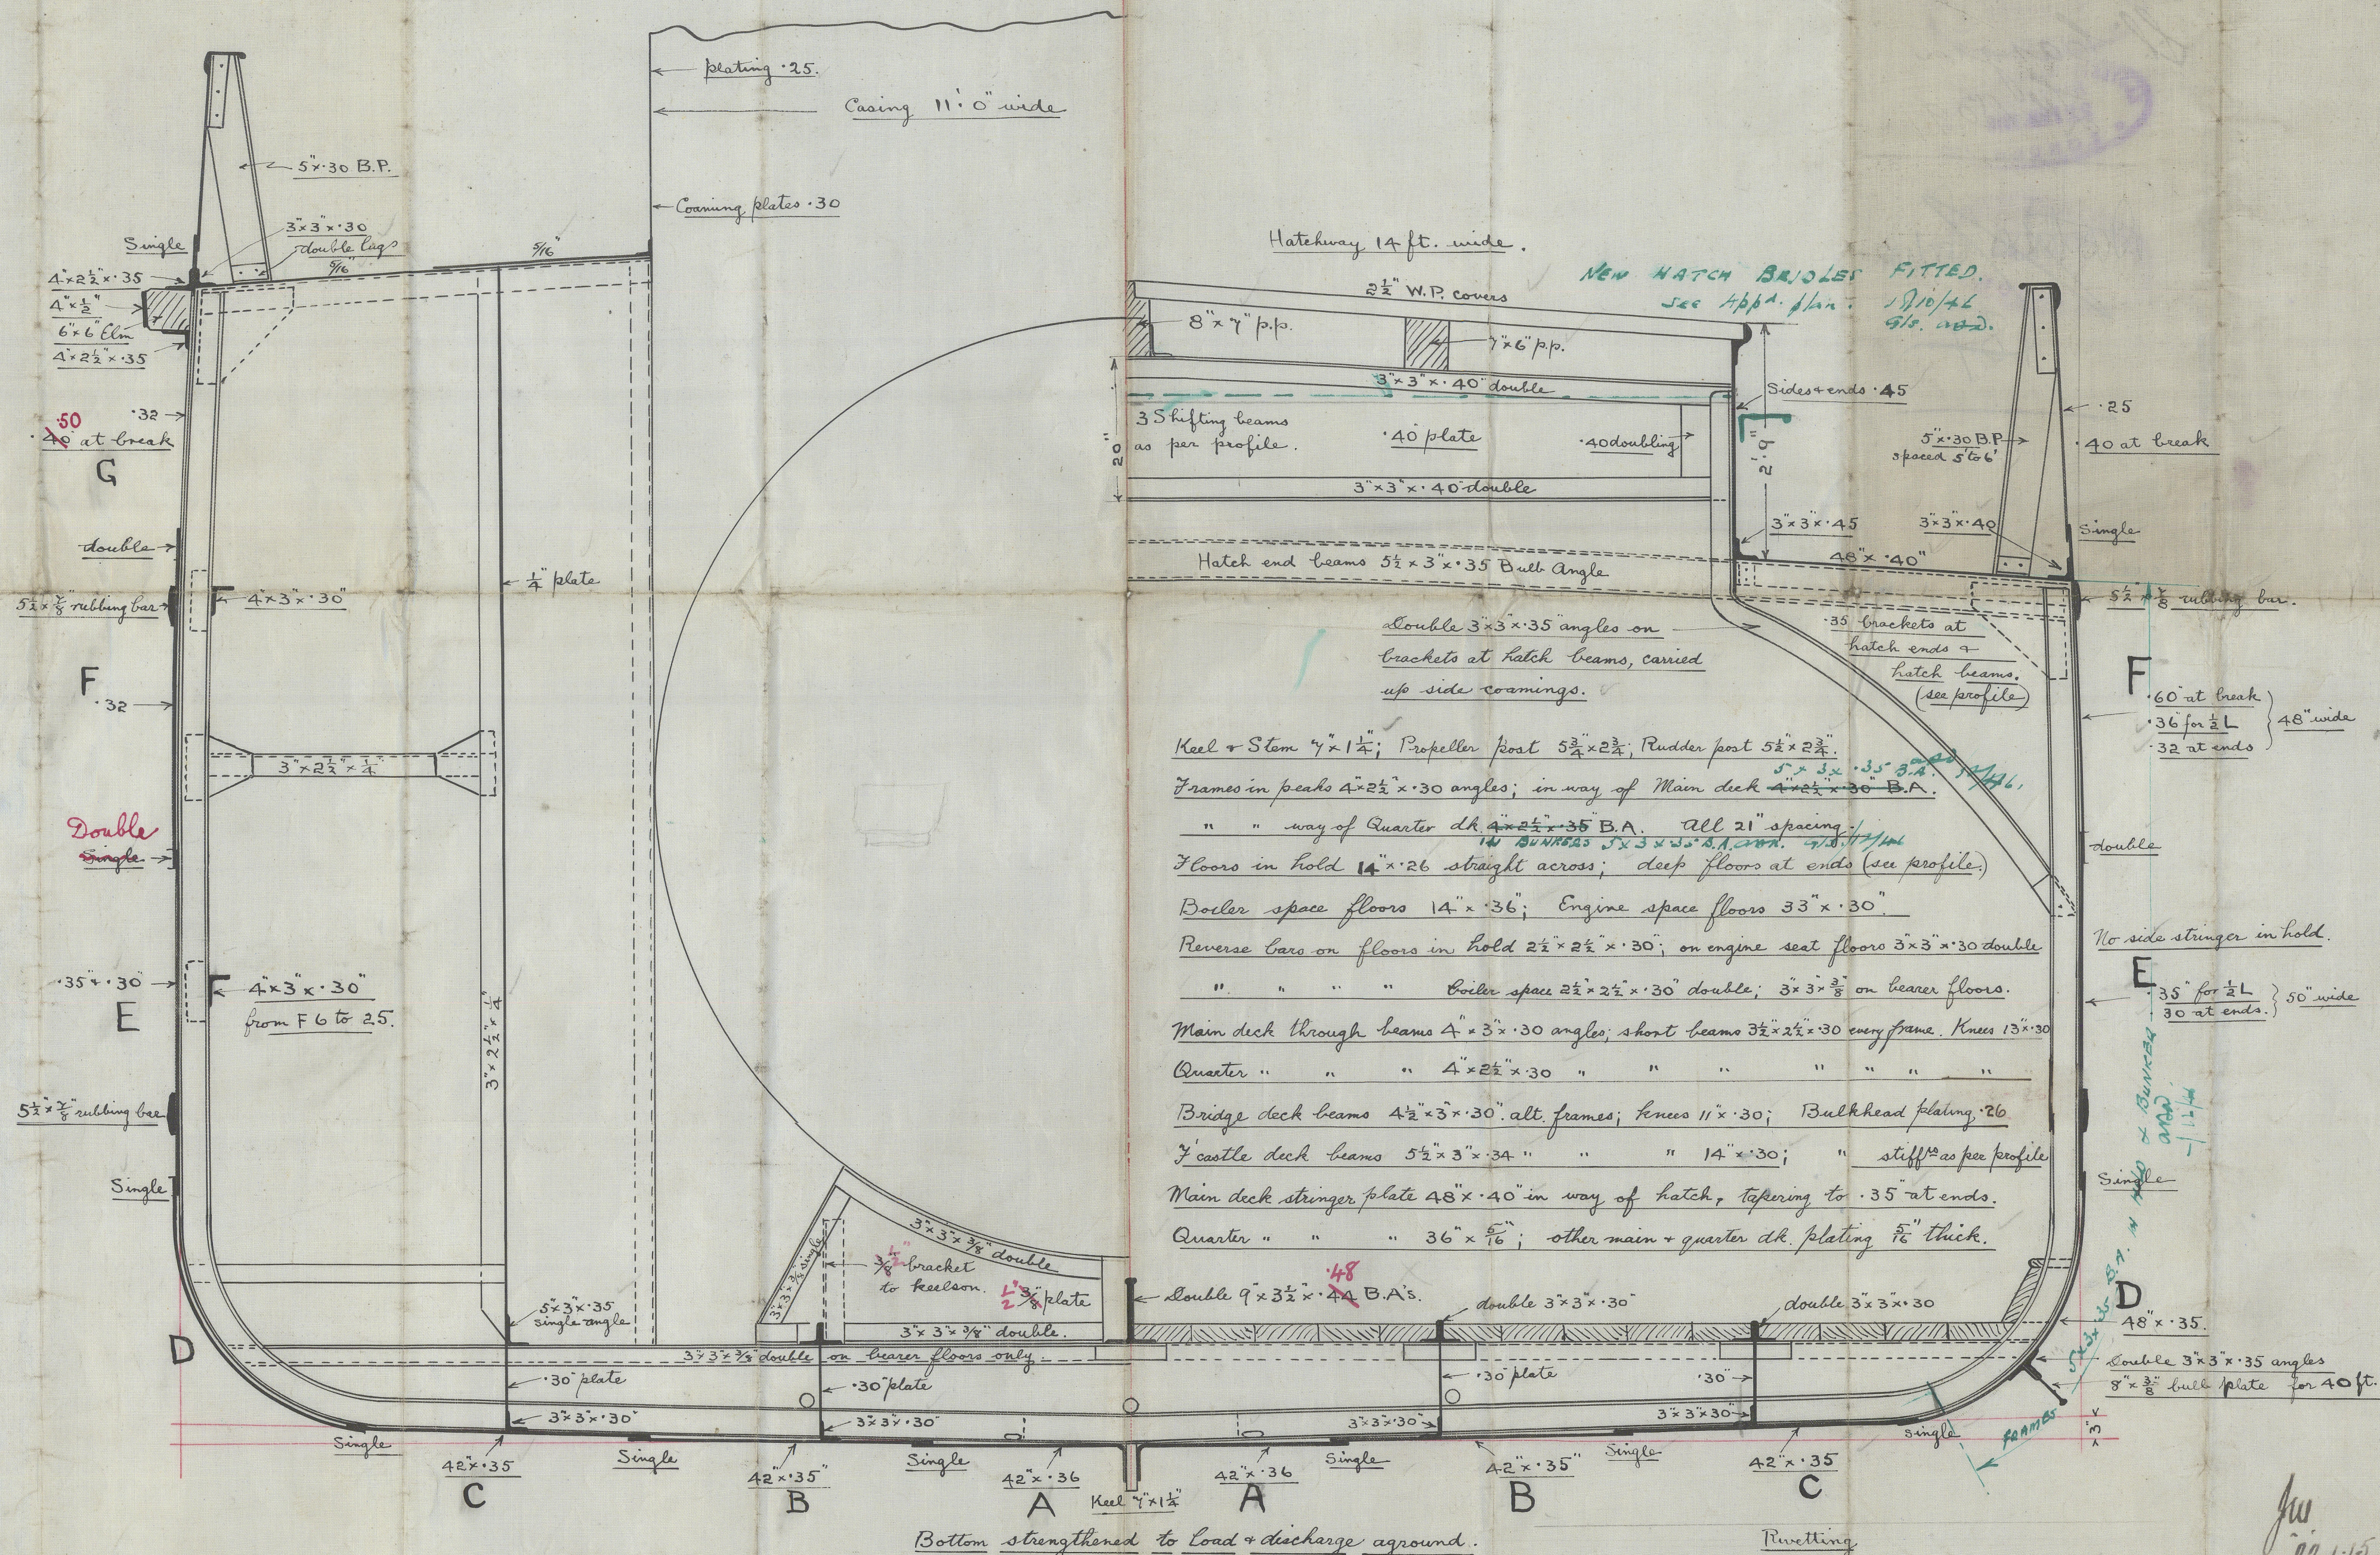

MIDSHIP SECTION

SCALE - 3/4" = 1 FOOT

Rivetting
Frames, floors, reverse bars, beams, decks
and shell plating all 3/4" rivetting.
Keel, stem, and sternpost 1" rivetting.

22-1-15
A. Jeffry & Co
Shipbuilders
Alloa.



S. S. Nos 14 + 15

Midship Section

A. Jeffery + 6°
Alloa

D. S. 187

Isabel

"^{Ex}
S. S. Collins

Lh 14896

S. S. Cargan

Lh 15097.

~~Director's Section~~
187



© 2021

Lloyd's Register
Foundation

010890-010904-0001