

STERN FRAME



SHIP N° 600

SCALE 1" = ONE FOOT

MINIMUM SCANTLINGS REQUIRED

STERN FRAME TO BE OF HAMMERED SCRAP IRON &
TO PASS LLOYDS' TEST.

1ST LONGITUDINAL N° = 860.

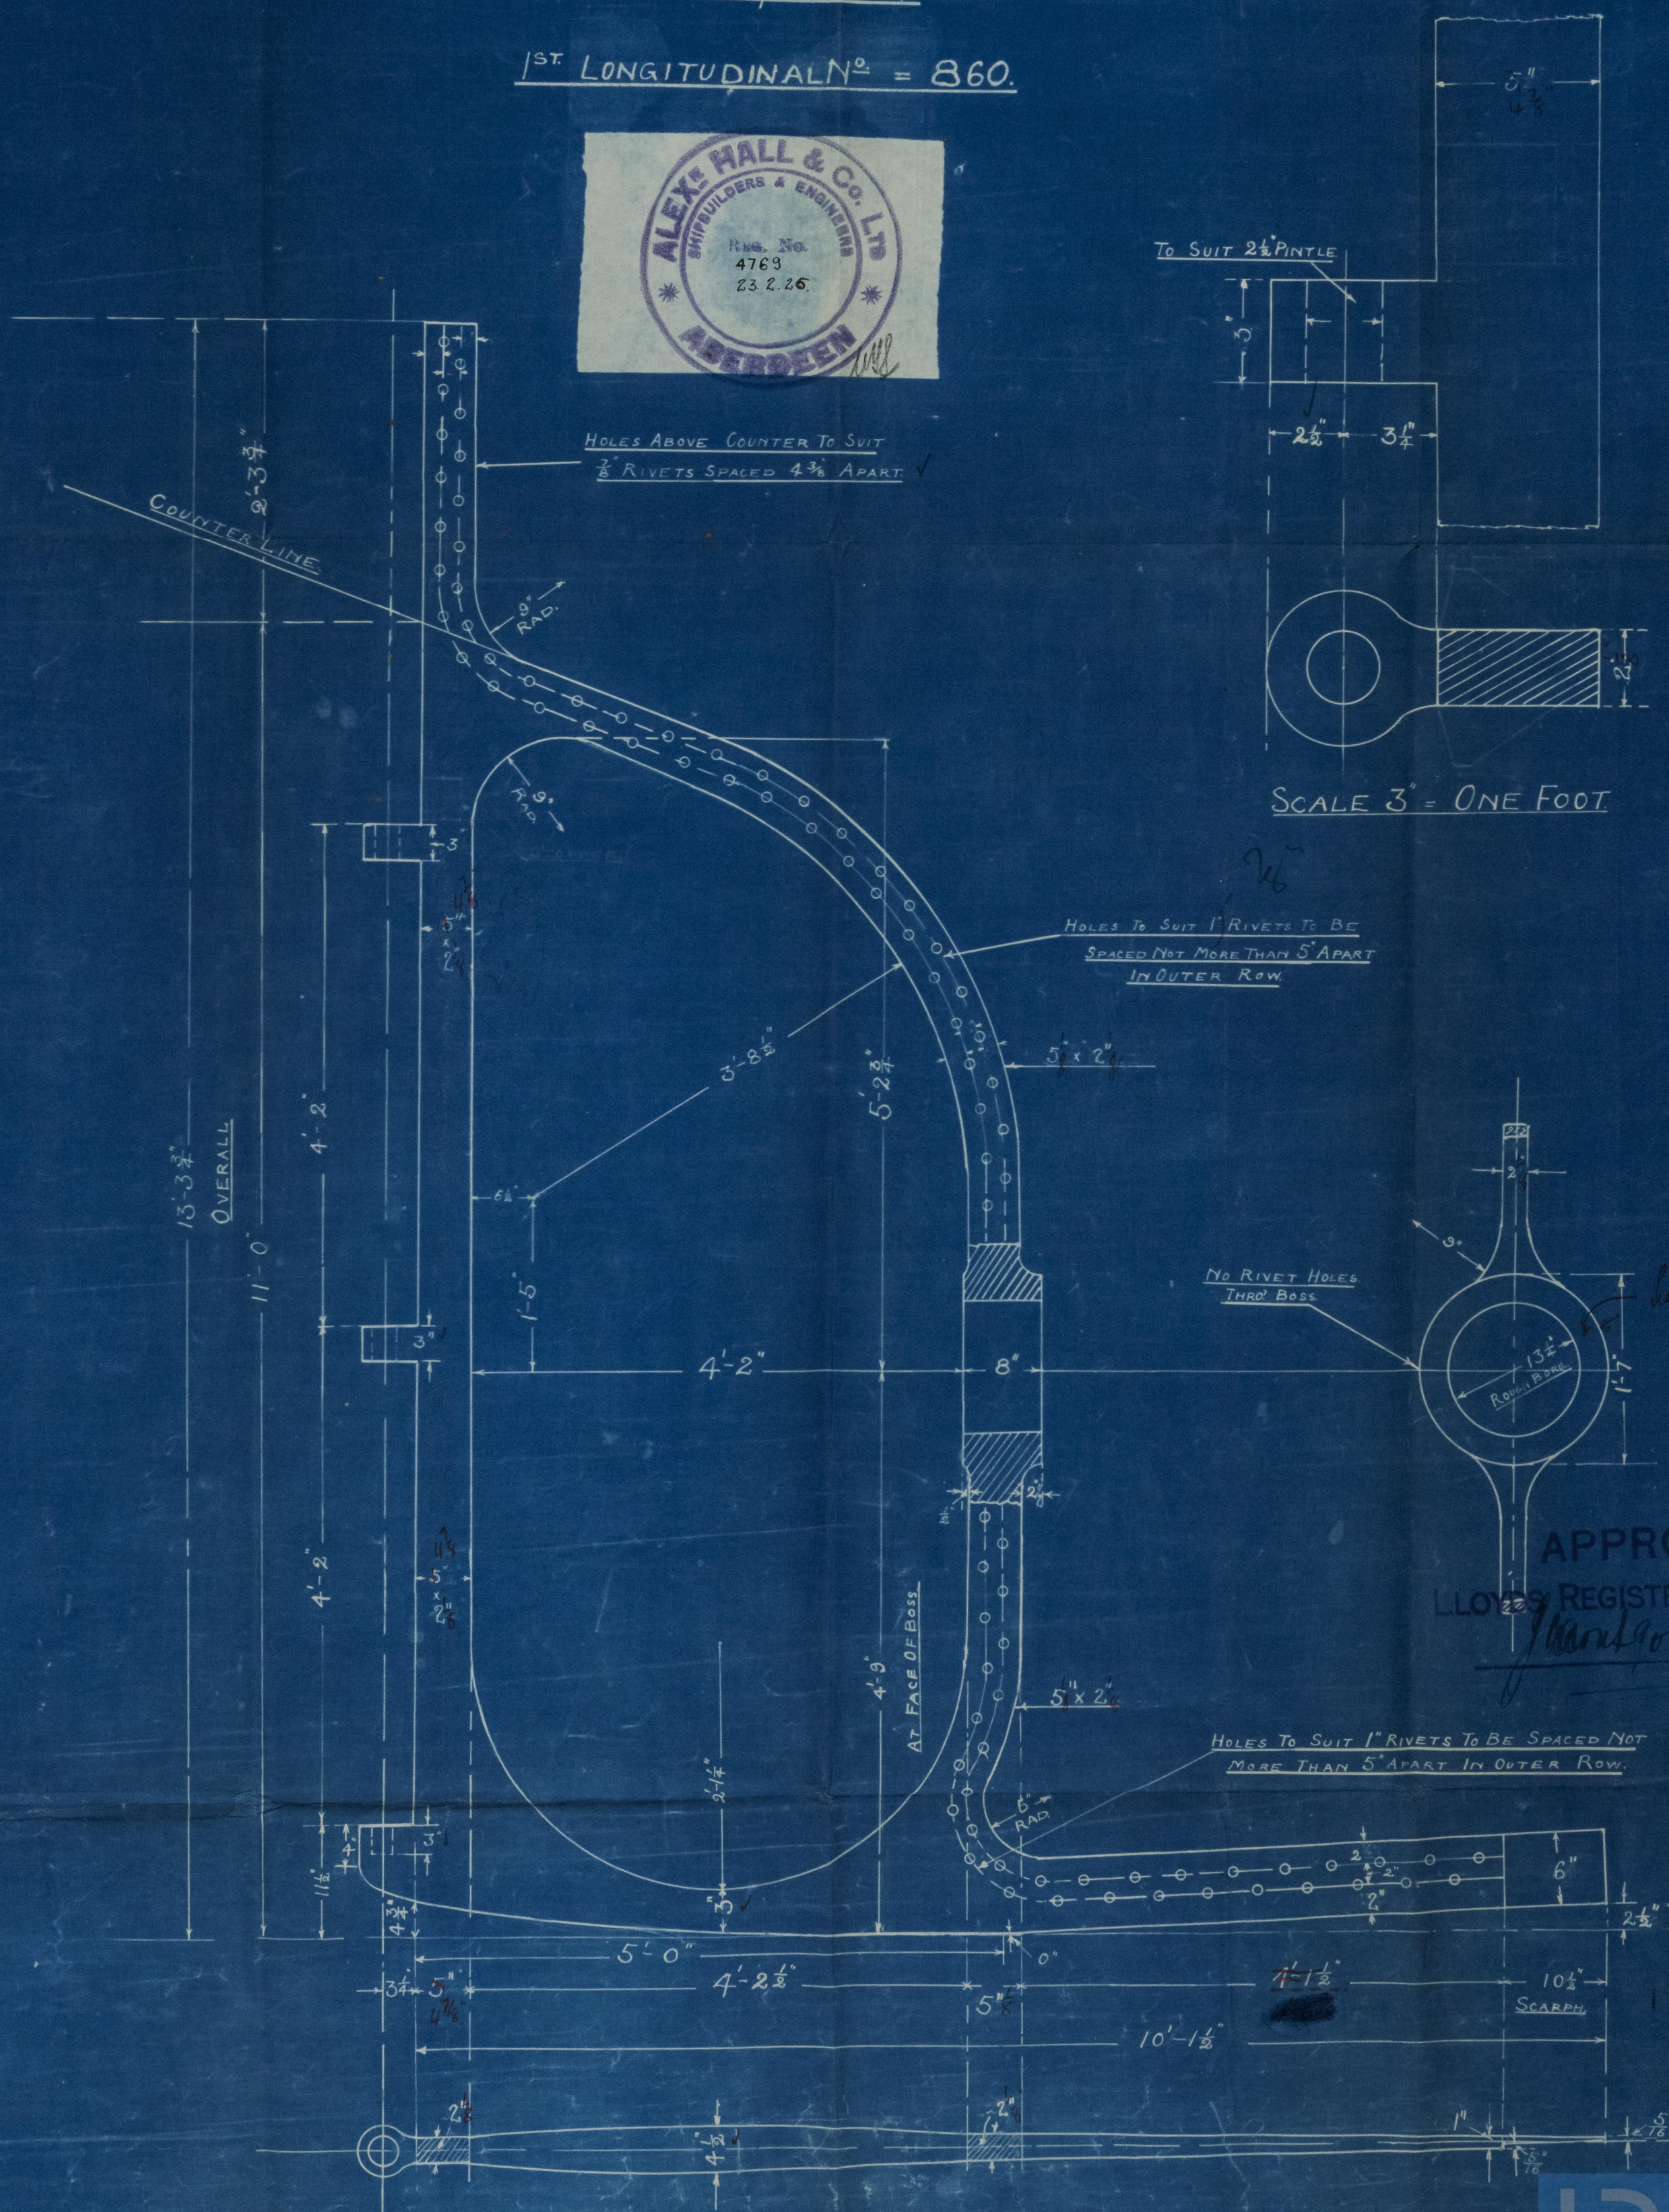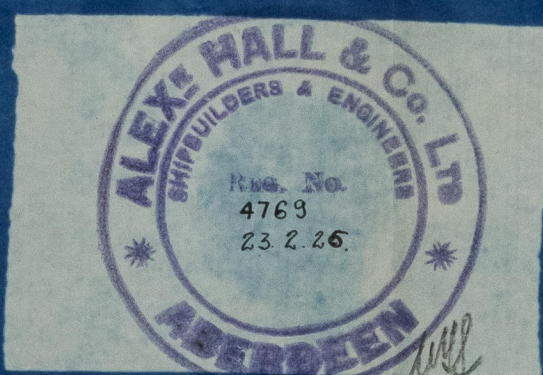

TO SUIT 2 1/2\" PINTLE

SCALE 3\" = ONE FOOT

APPROVED
LLOYDS REGISTER OF SHIPPING

DATE 2-3-27

N° 619

27-3-27



STERN FRAME

MESSRS A. HALL & CO^o LD.

N^{os} 600 & 619.

600 = SCREW TUG. = "TAYRA"

ABN. REPORT. 14476.

619 = "FOSSA"

ABN. REPORT. 15780.



© 2021

Lloyd's Register
Foundation

010982-010991-0127