

SHIP No 1160


FLY TO PROFILE & DECKS SHOWING DECK BEAMS AT EVERY FRAME AT POOP & BRIDGE DECKS.

NOTE:- POOP DECK PLATING SEAMS & BUTTS WELDED

STRINGER ANGLE, DECK BEAMS, CASING & DECKHOUSE FOUNDATION BARS RIVETED.

DECK SHEATHED CLEAR OF DECKHOUSE, WITH WOOD SHEATHING.

DECK PLATING COVERED WITH $\frac{3}{16}$ " COMPOSITION INSIDE DECKHOUSE.

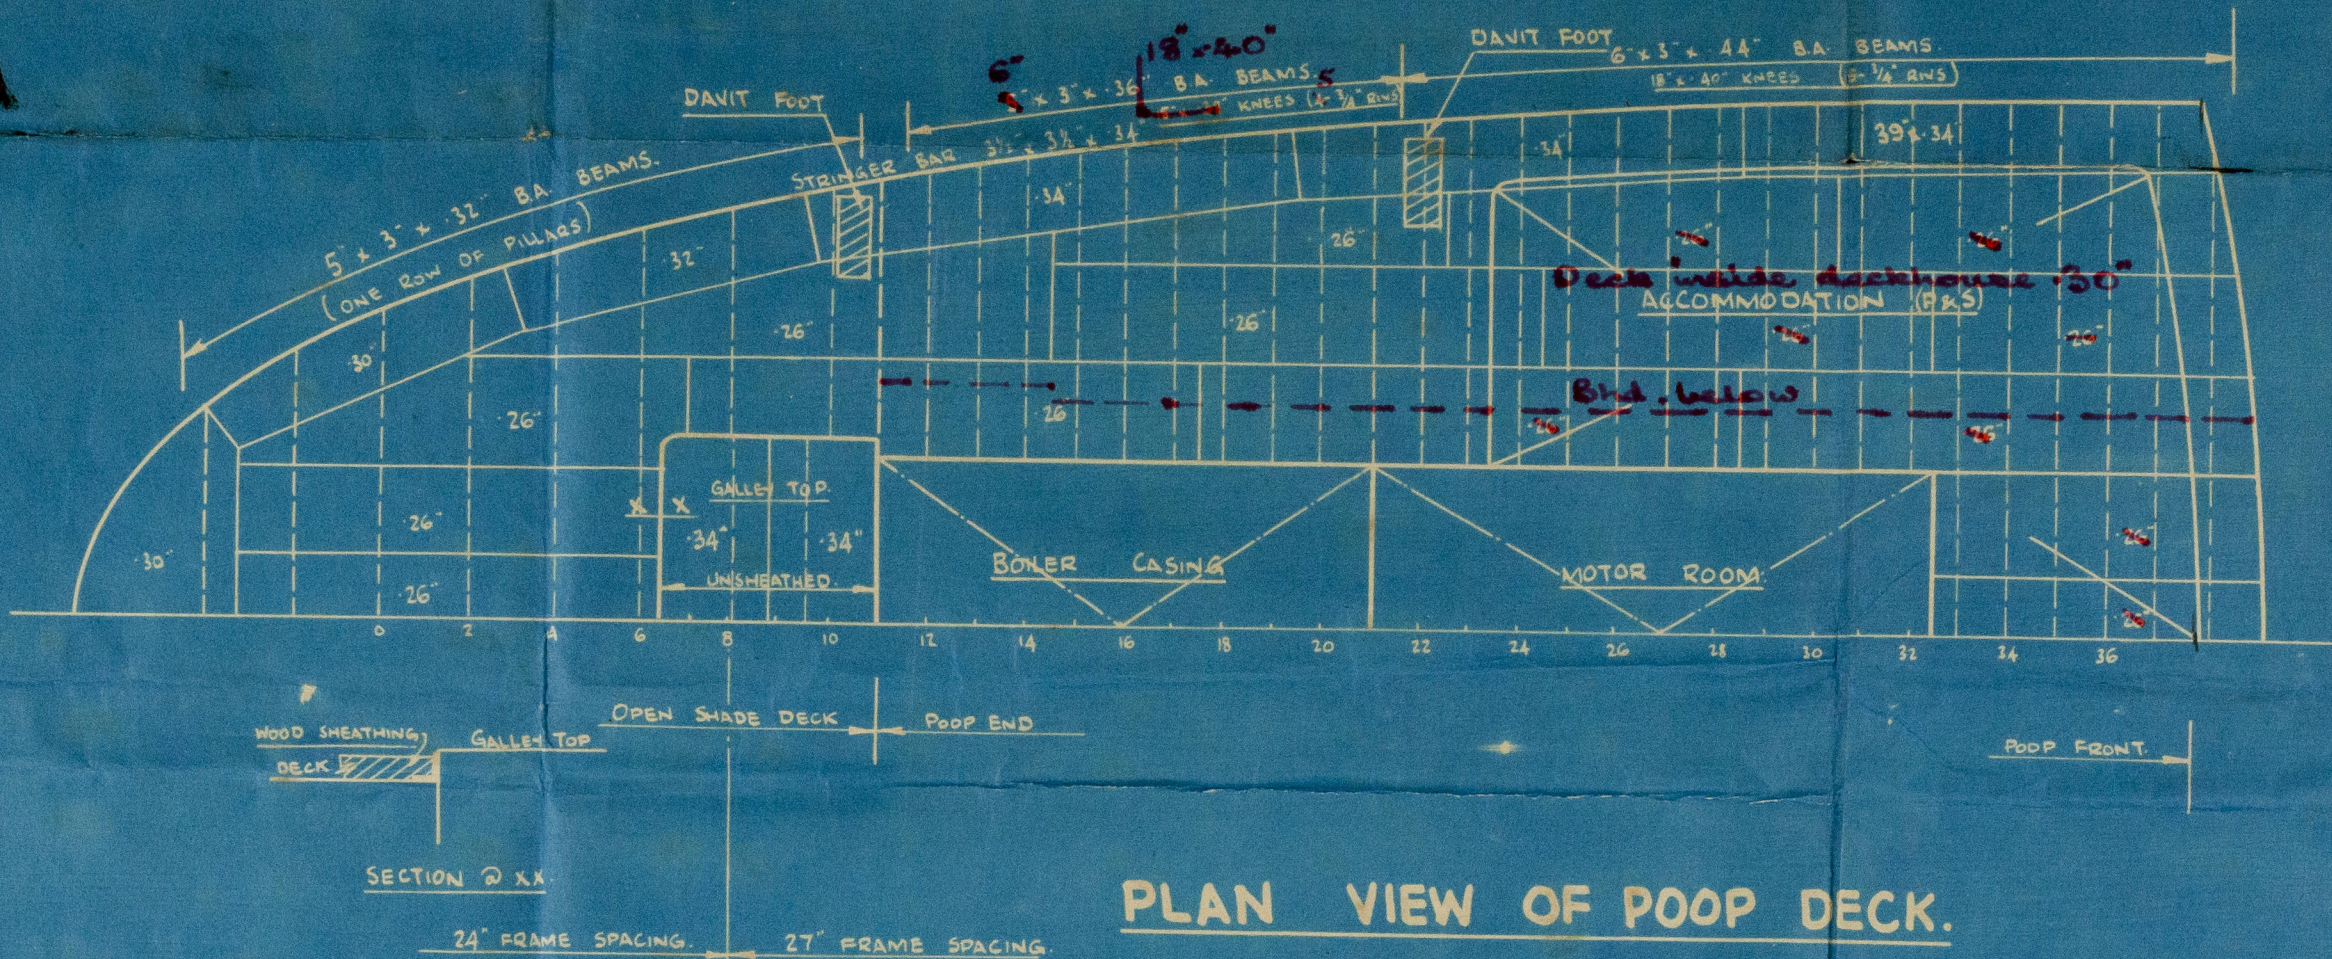

PLAN VIEW OF POOP DECK.


SCALE :- $\frac{1}{8}$ " = 1 FOOT.

NOTE:- BRIDGE DECK PLATING SEAMS & BUTTS WELDED.

STRINGER ANGLE, DECK BEAMS & DECKHOUSE FOUNDATION BARS RIVETED.

DECK SHEATHED, CLEAR OF DECKHOUSE, WITH WOOD SHEATHING.

DECK PLATING COVERED WITH $\frac{3}{16}$ " COMPOSITION INSIDE DECKHOUSE.

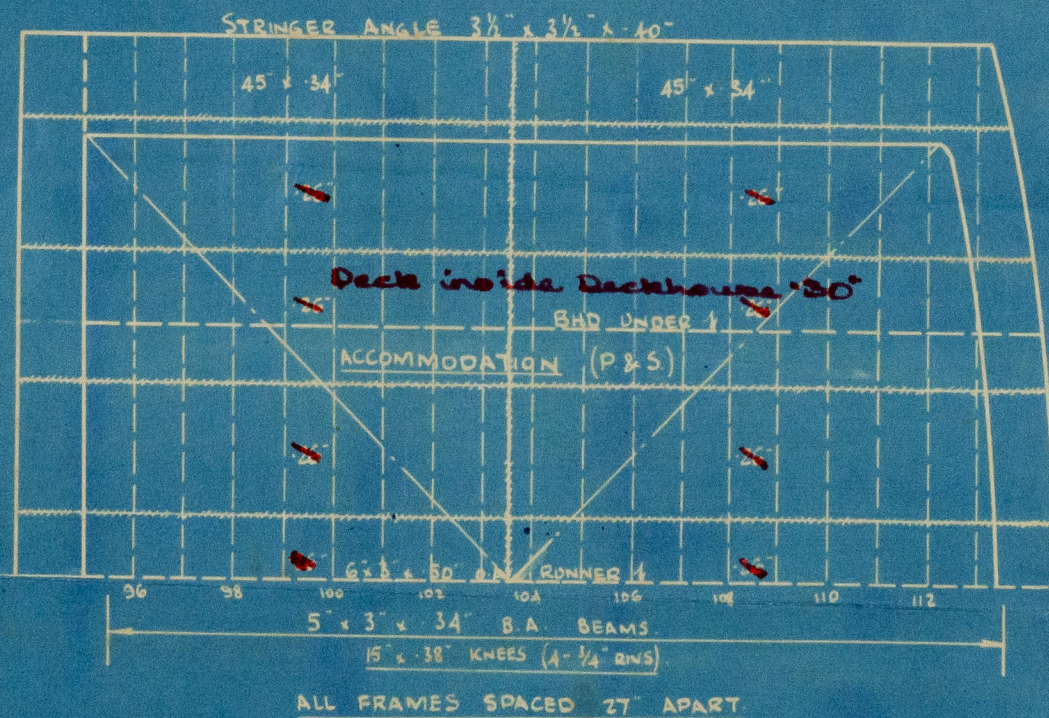


PLAN VIEW OF BRIDGE DECK.

SCALE :- $\frac{1}{8}$ " = 1 FOOT.

AVL
7.3.46



010992-011000-0001

"CYRENA" 

Fly to Profile & Decks.

3



© 2021

Lloyd's Register
Foundation

010992-011000-0001