


CASTLE TYPE TRAWLERS

DIMENSIONS 125'-0" x 23'-6" x 13'-6" MLD.

SCALE $\frac{1}{2}$ INCH = 1 FOOT.

N^os 201-2-3-4-5-6

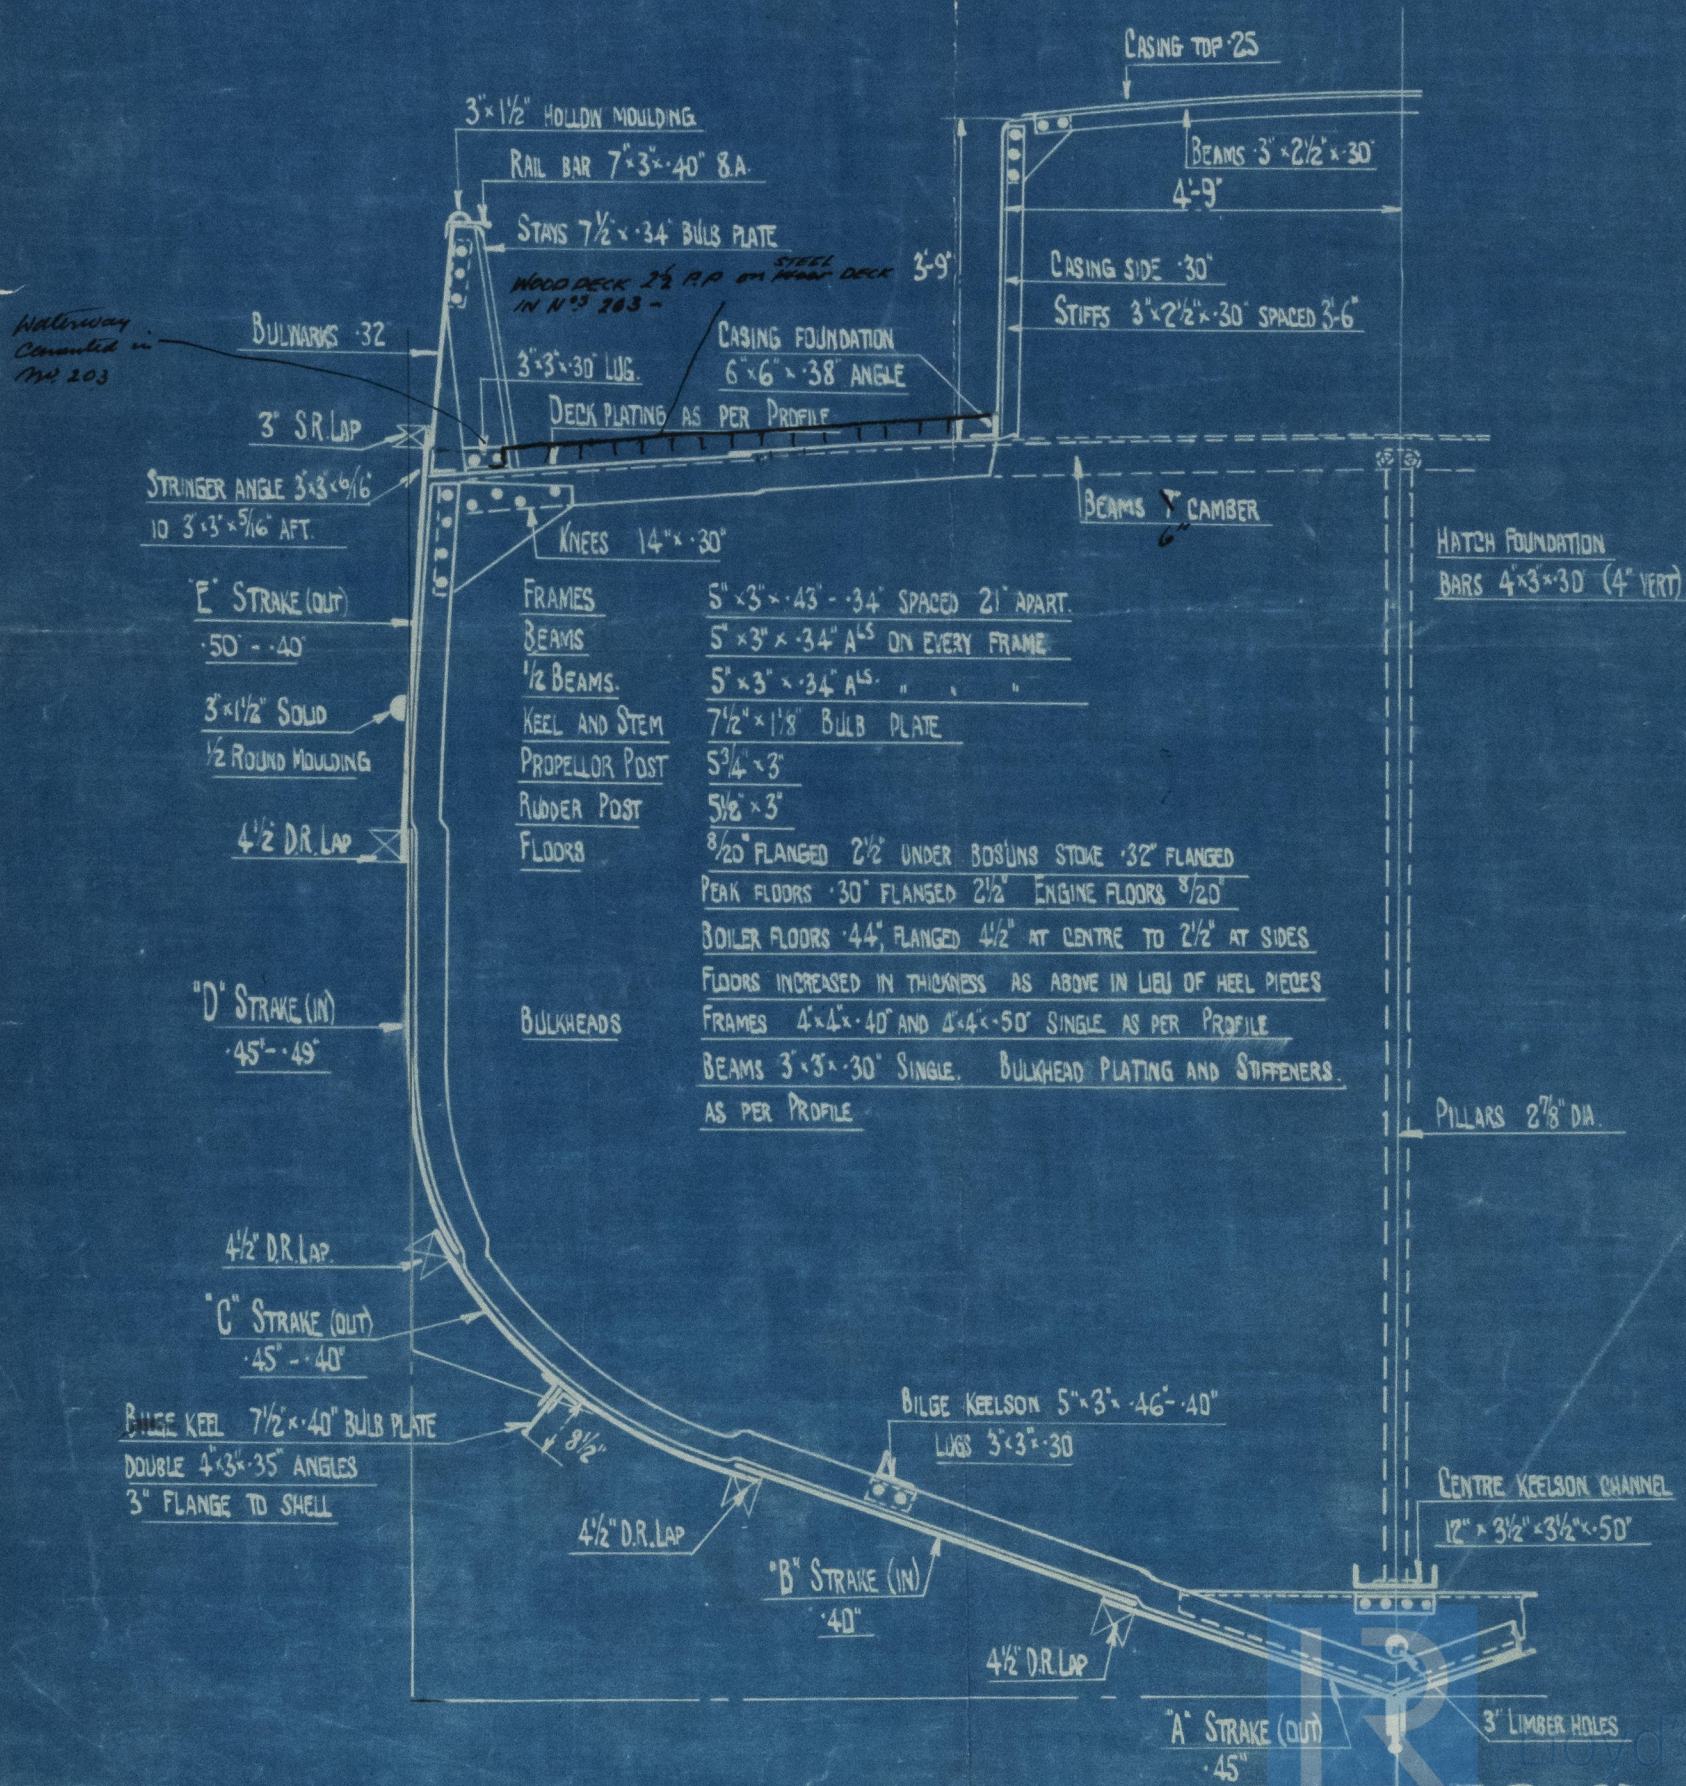

C Remoldson Co.
 "Castle" Trawler "Ebor Downs"
 110 201

MID SECTION (AS BUILT)

7570

S. S. EBOR DOWNS
 NEWCASTLE ON TYNE.

Report No. 72234

SS Pierre Francois Deswaite

S. S. PIERRE FRANCOIS DESWAITE

NEWCASTLE ON TYNE.

Report No. 72570.

DINAS

D/S 583

n/n "Caerphilly
 Castle"

S. S. EBOR ELECT
 NEWCASTLE ON TYNE.

Report No.

72722

© 2021

Lloyd's Register
 Foundation