
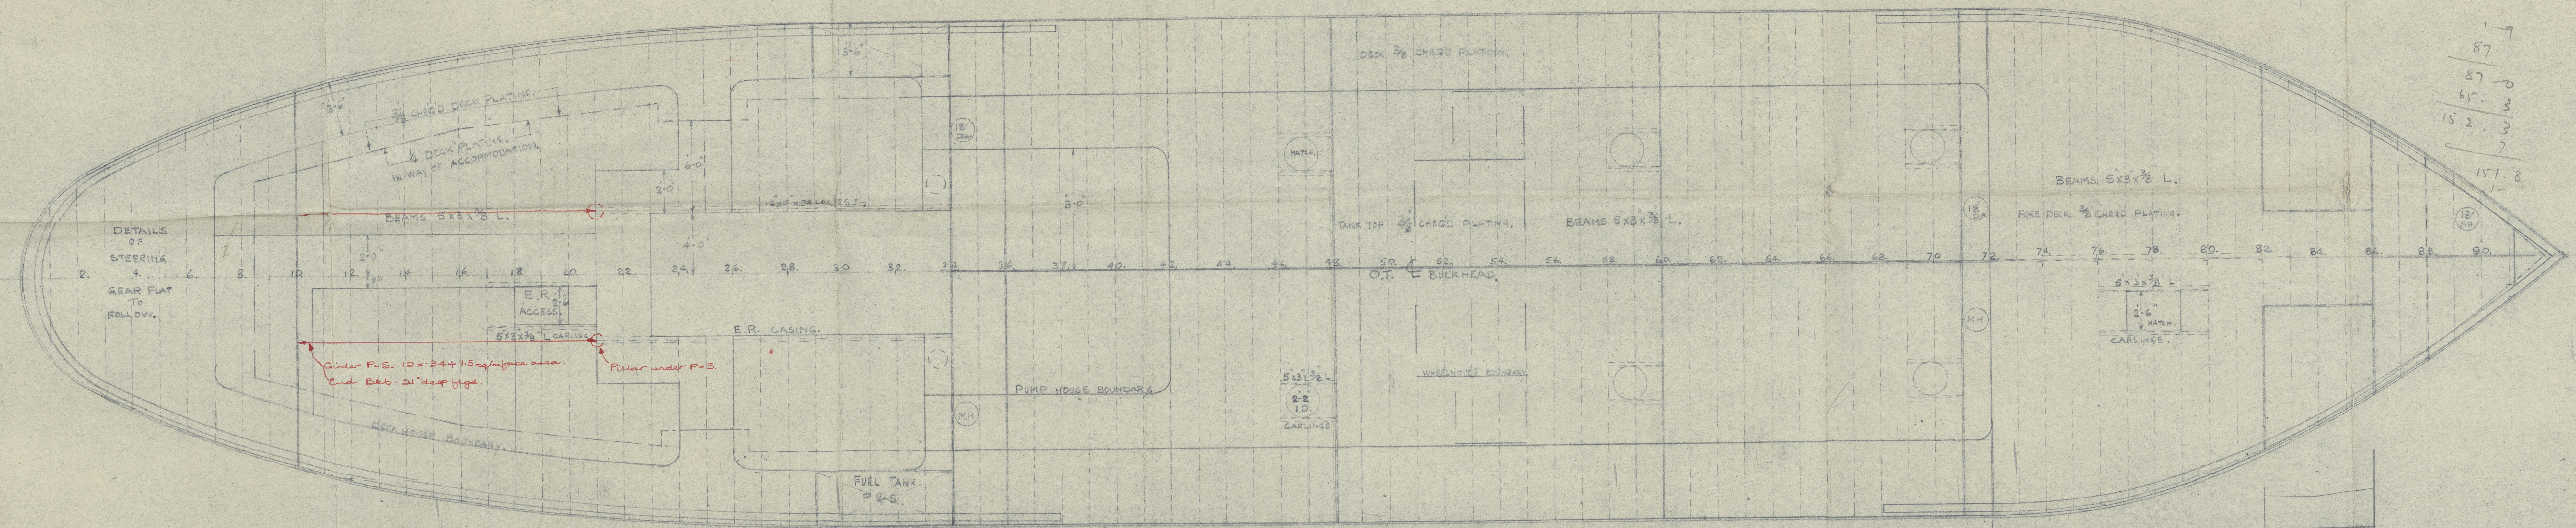
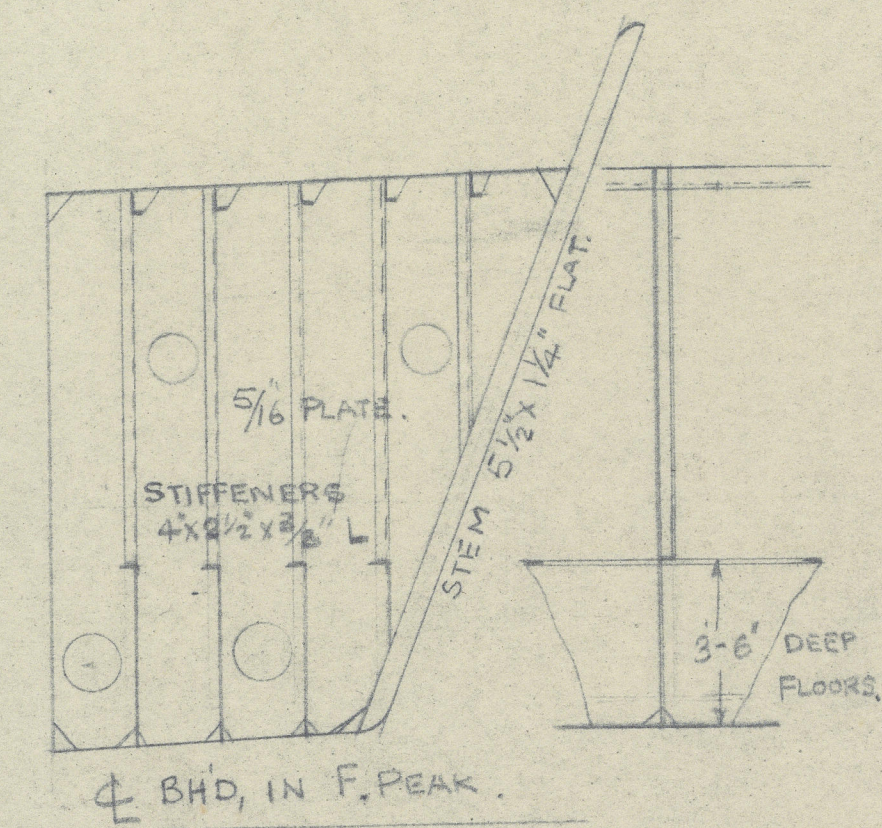


22 JAN 1959


Tipping Bldg. when
down T.B. guarantee S.F.B.
connections (See approved
Midship Section).

X Gider end Bldg. to be
horizontal, 14" x 34" fig. 3'

Bldg.

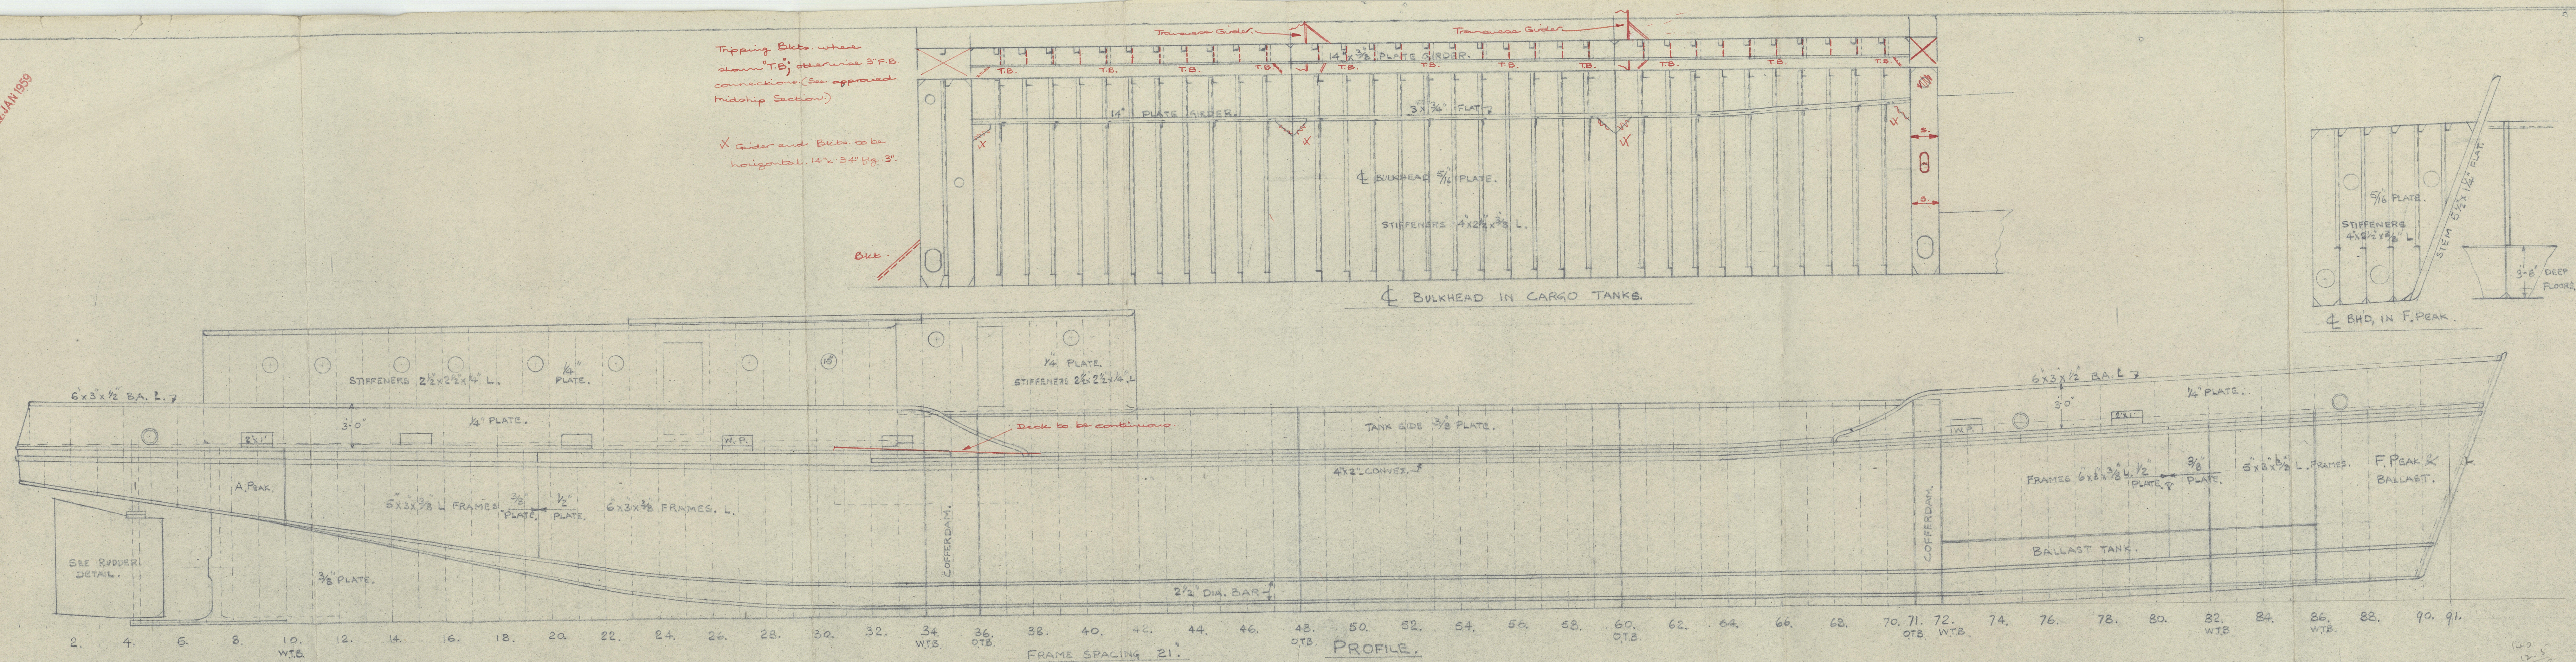

140
12.5
113.5
261
4
157.8
152.3
65.0
87.0
87.0

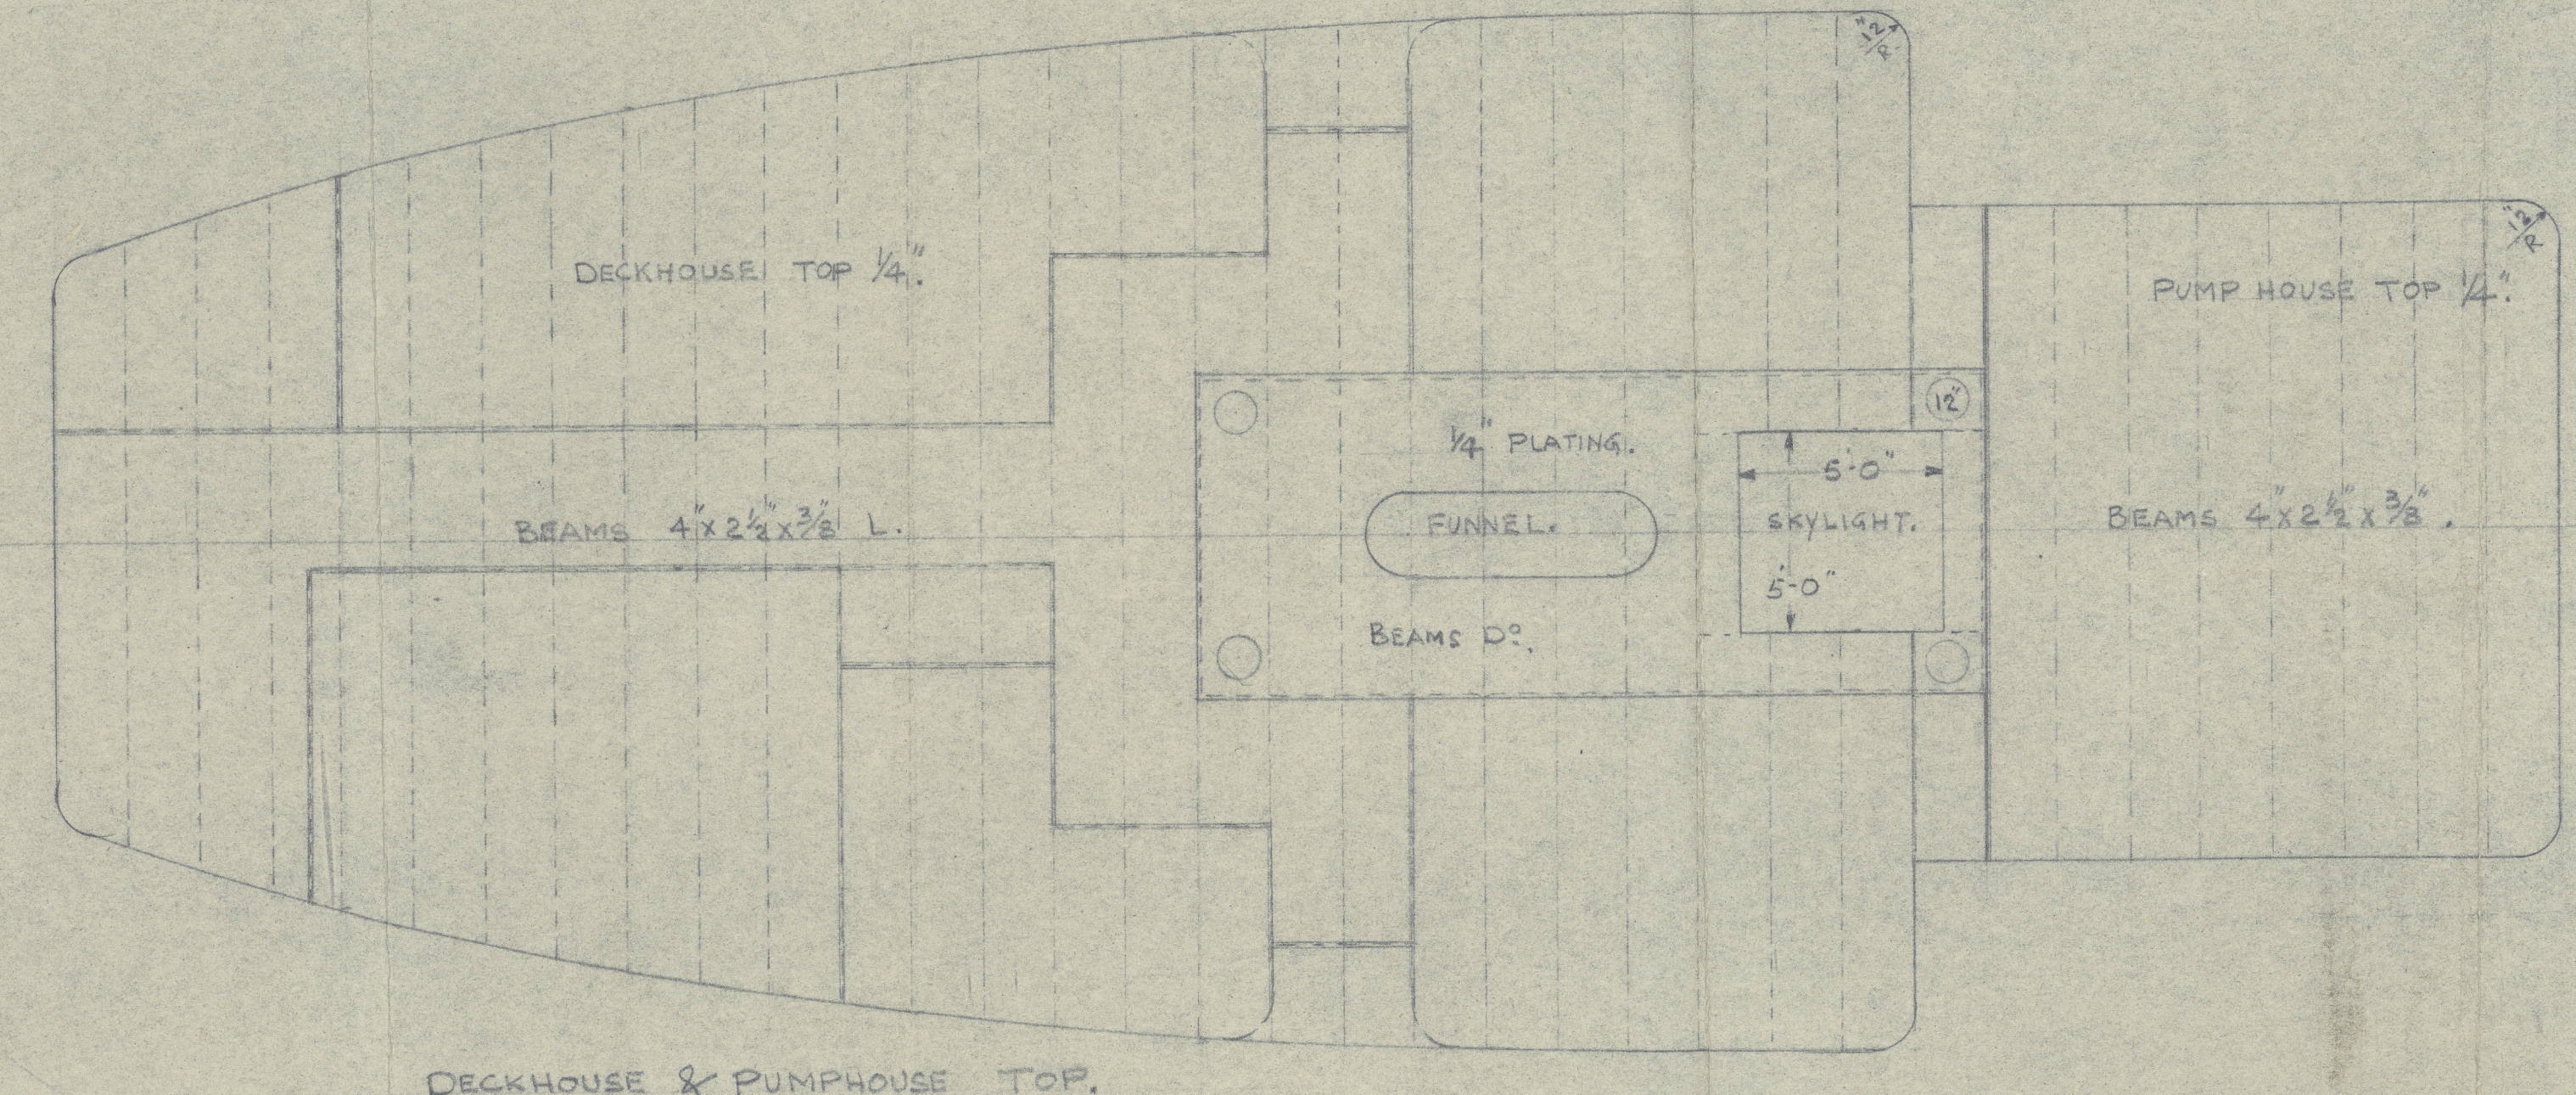

DECK & TANK TOP PLAN.

TEST HEAD - 2 FT. ABOVE TRUNK TOP.

STEELWORK PLAN.


500 TON POWERED TANKER. ABOVE 150' FLASH.

163'-3\"/>

SCALE 1/4\"/>

SEE- DRG 266. FOR BHD'S ETC.

CHARRINGTON GARDNER LOCKET (LONDON) LTD.
PRIORITY WORKS, LAMBTON RD.
DARTFORD, KENT.
DRG: N° 265. 31/12/58.

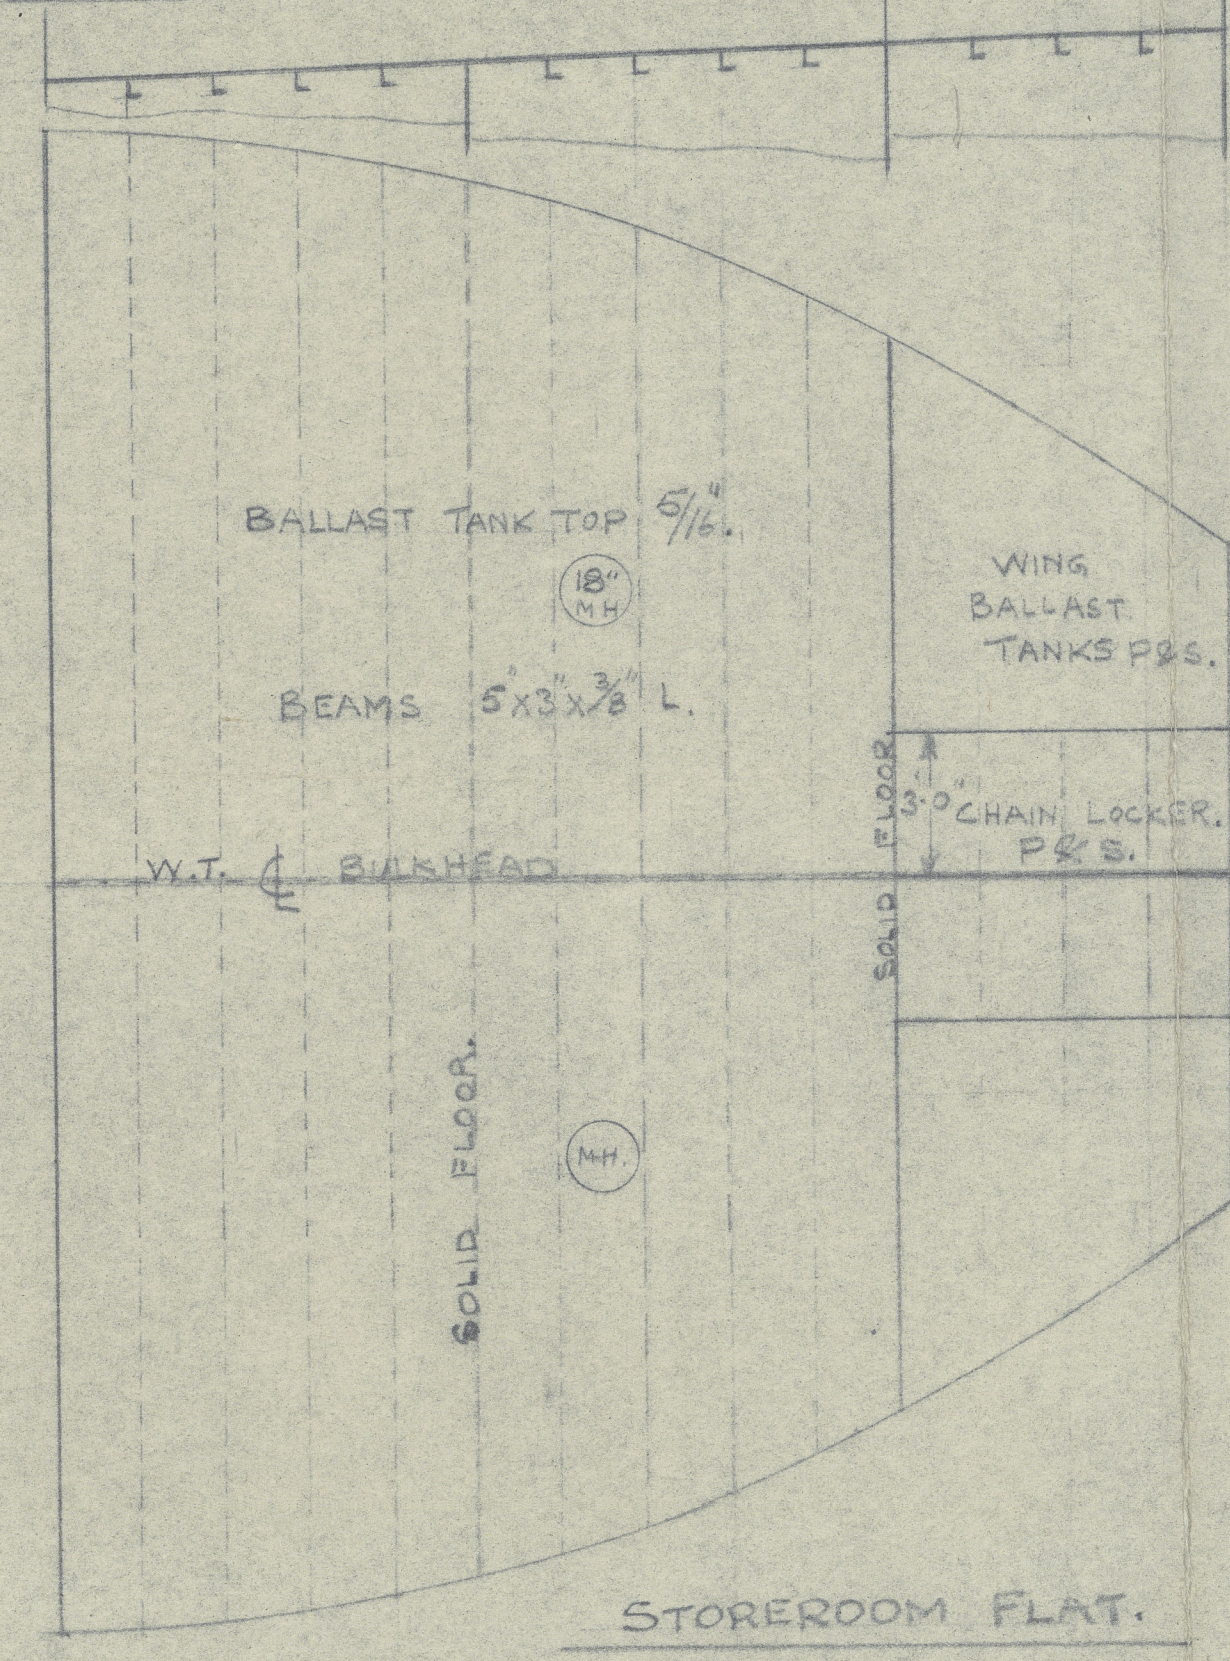

As fitted, 12.4.60

52

CHARRINGTON GARDNER
& LOCKET LTD
DARTFORD

SHIP NO 148
M.V. CHARMO *

RECORDS DEPT.,
LONDON.

3

STEELWORK PLAN

PLEASE ATTACH LONDON REPORT
N^o 142598

APPROVED
27.1.59



© 2021

Lloyd's Register
Foundation