

EBOARD REPORT on the CHARMO


Submitted Surveyors be informed R/C11 examined and found in order except that they should be requested to confirm that wire gauze is in fact fitted in all cofferdam ventilators and air pipes.

~~FF~~

WCH
14.9.60
15/9/60.

2/ FR ENG RPT'S to note closing arrangements for air pipes.

Mr. K. G. Kirby has been phoned & confirmed that air pipes are as sketched below.

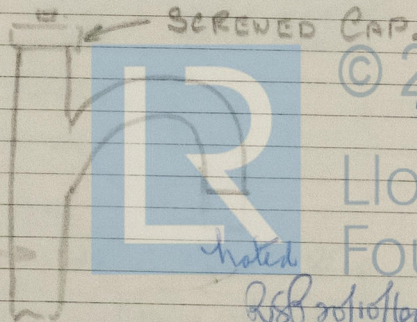

Noted

WCH 20/10/60.

© 2021

20.9.60

Lloyd's Register
Foundation